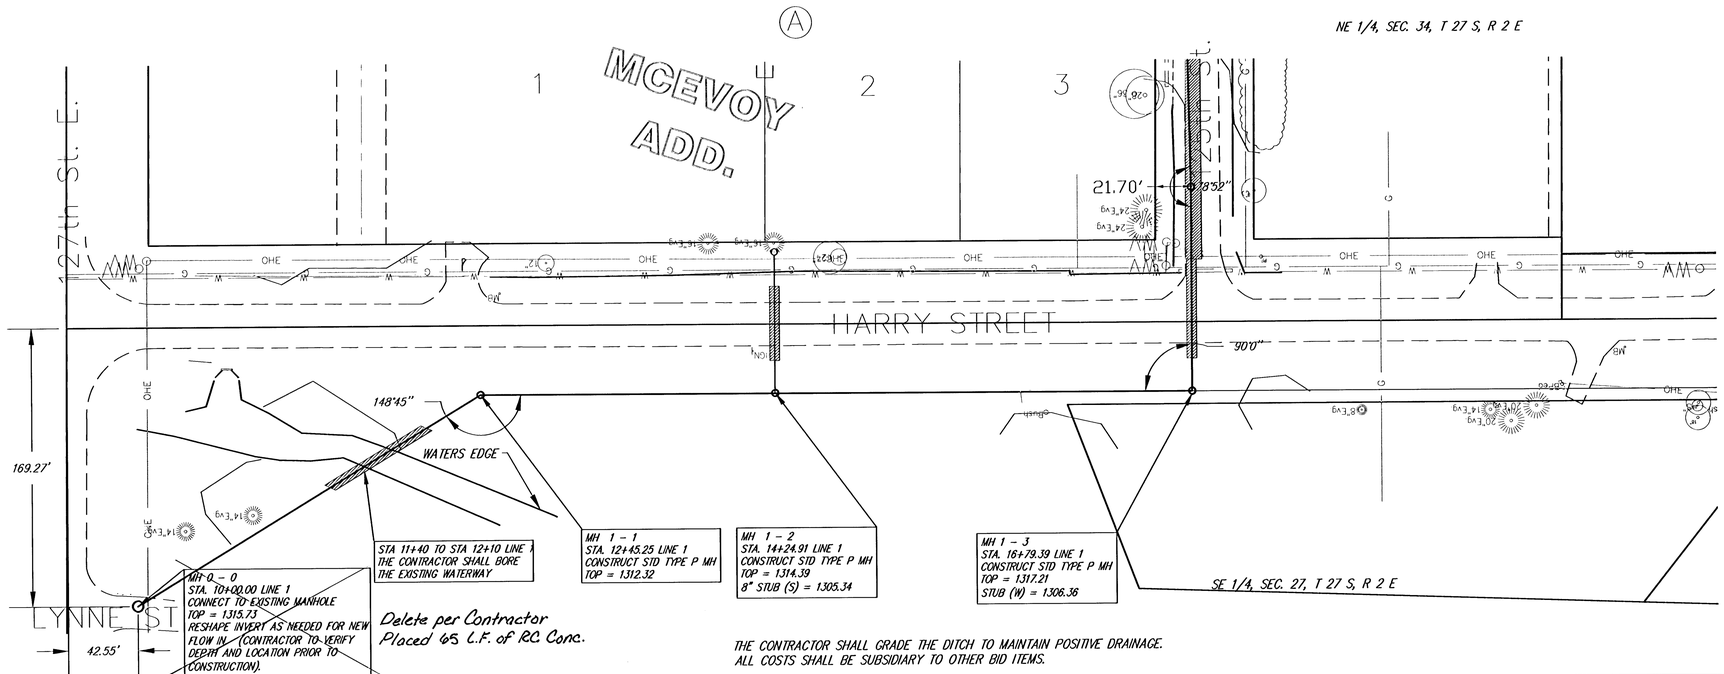

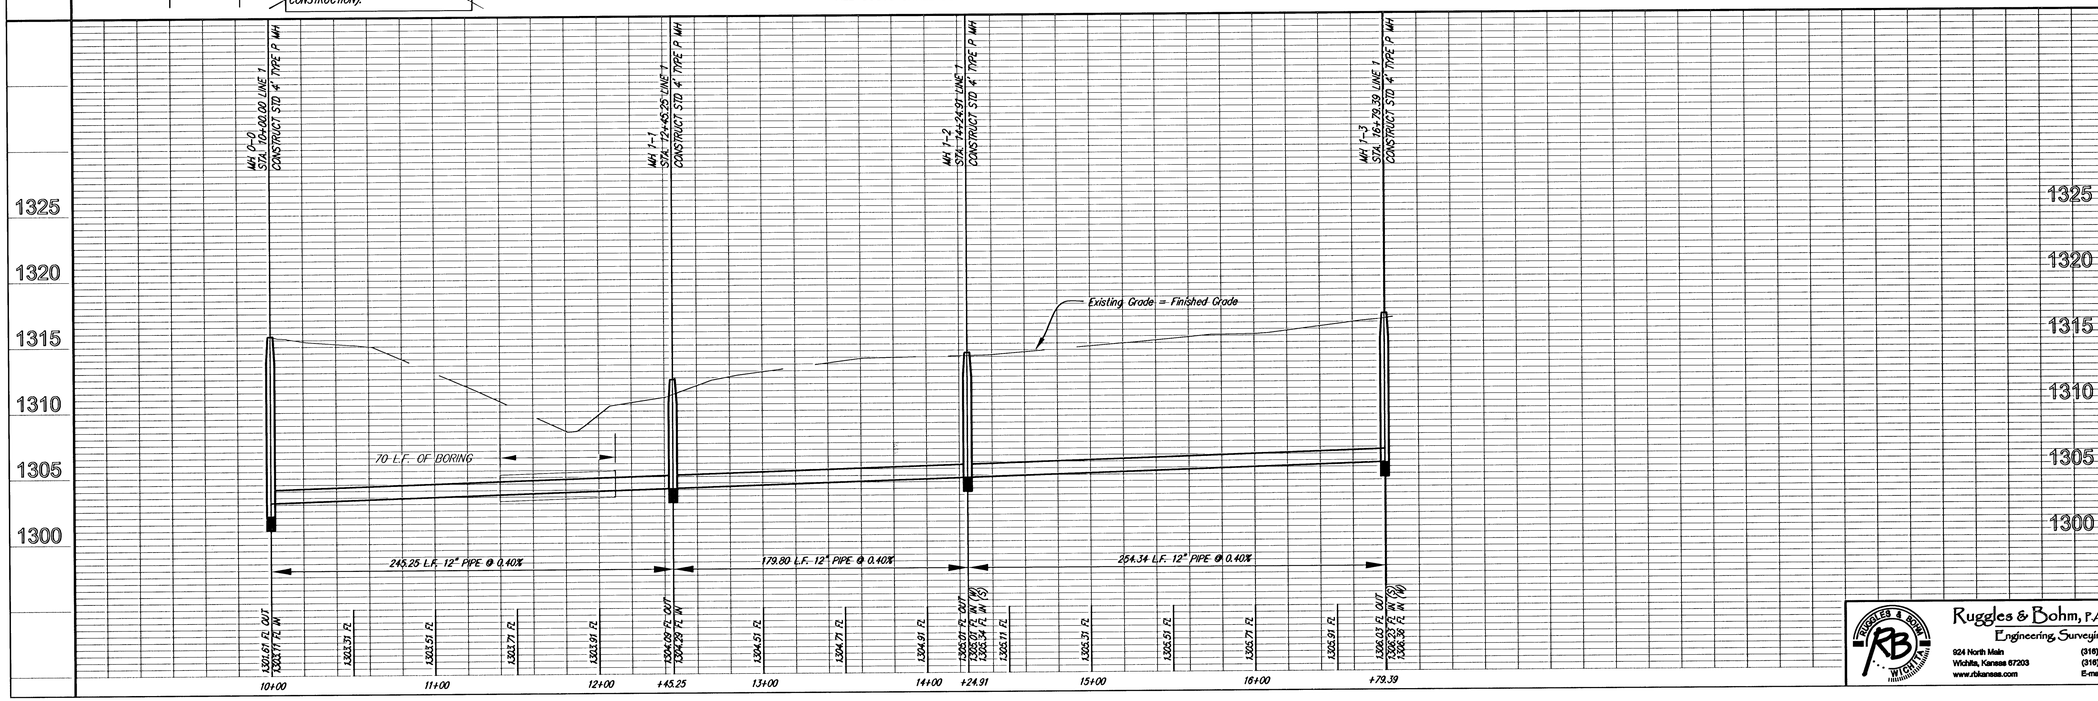

DESIGN	PDC
DRAWN	PDC
DATE	9/26/05
REVIEWED	
REVIEW DATE	11/17/05
UTILITY	
PROJECT NUMBER	468-84026
DRAWING FILE	0705- base

SANITARY SEWER MAIN
LINE 1, MAIN 16, SS #23
WICHITA, KANSAS

Ruggles & Bohm, P.A.
Engineering, Surveying, Land Planning
924 North Main
Wichita, Kansas 67203
www.rbkansas.com
(316) 264-8008
(316) 264-4621 fax
E-mail: info@rbkansas.com

WO NO.	2612X
SHEET	3 of 17