

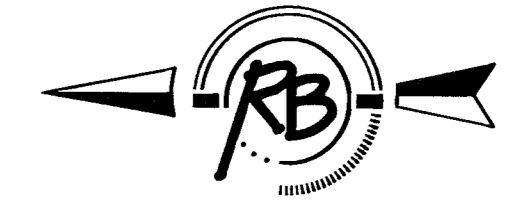


SE 1/4, SEC. 29, T 26 S, R 1 E


MI 221-0002  
FUNSTON, DAVID L.  
1525 N. MESA

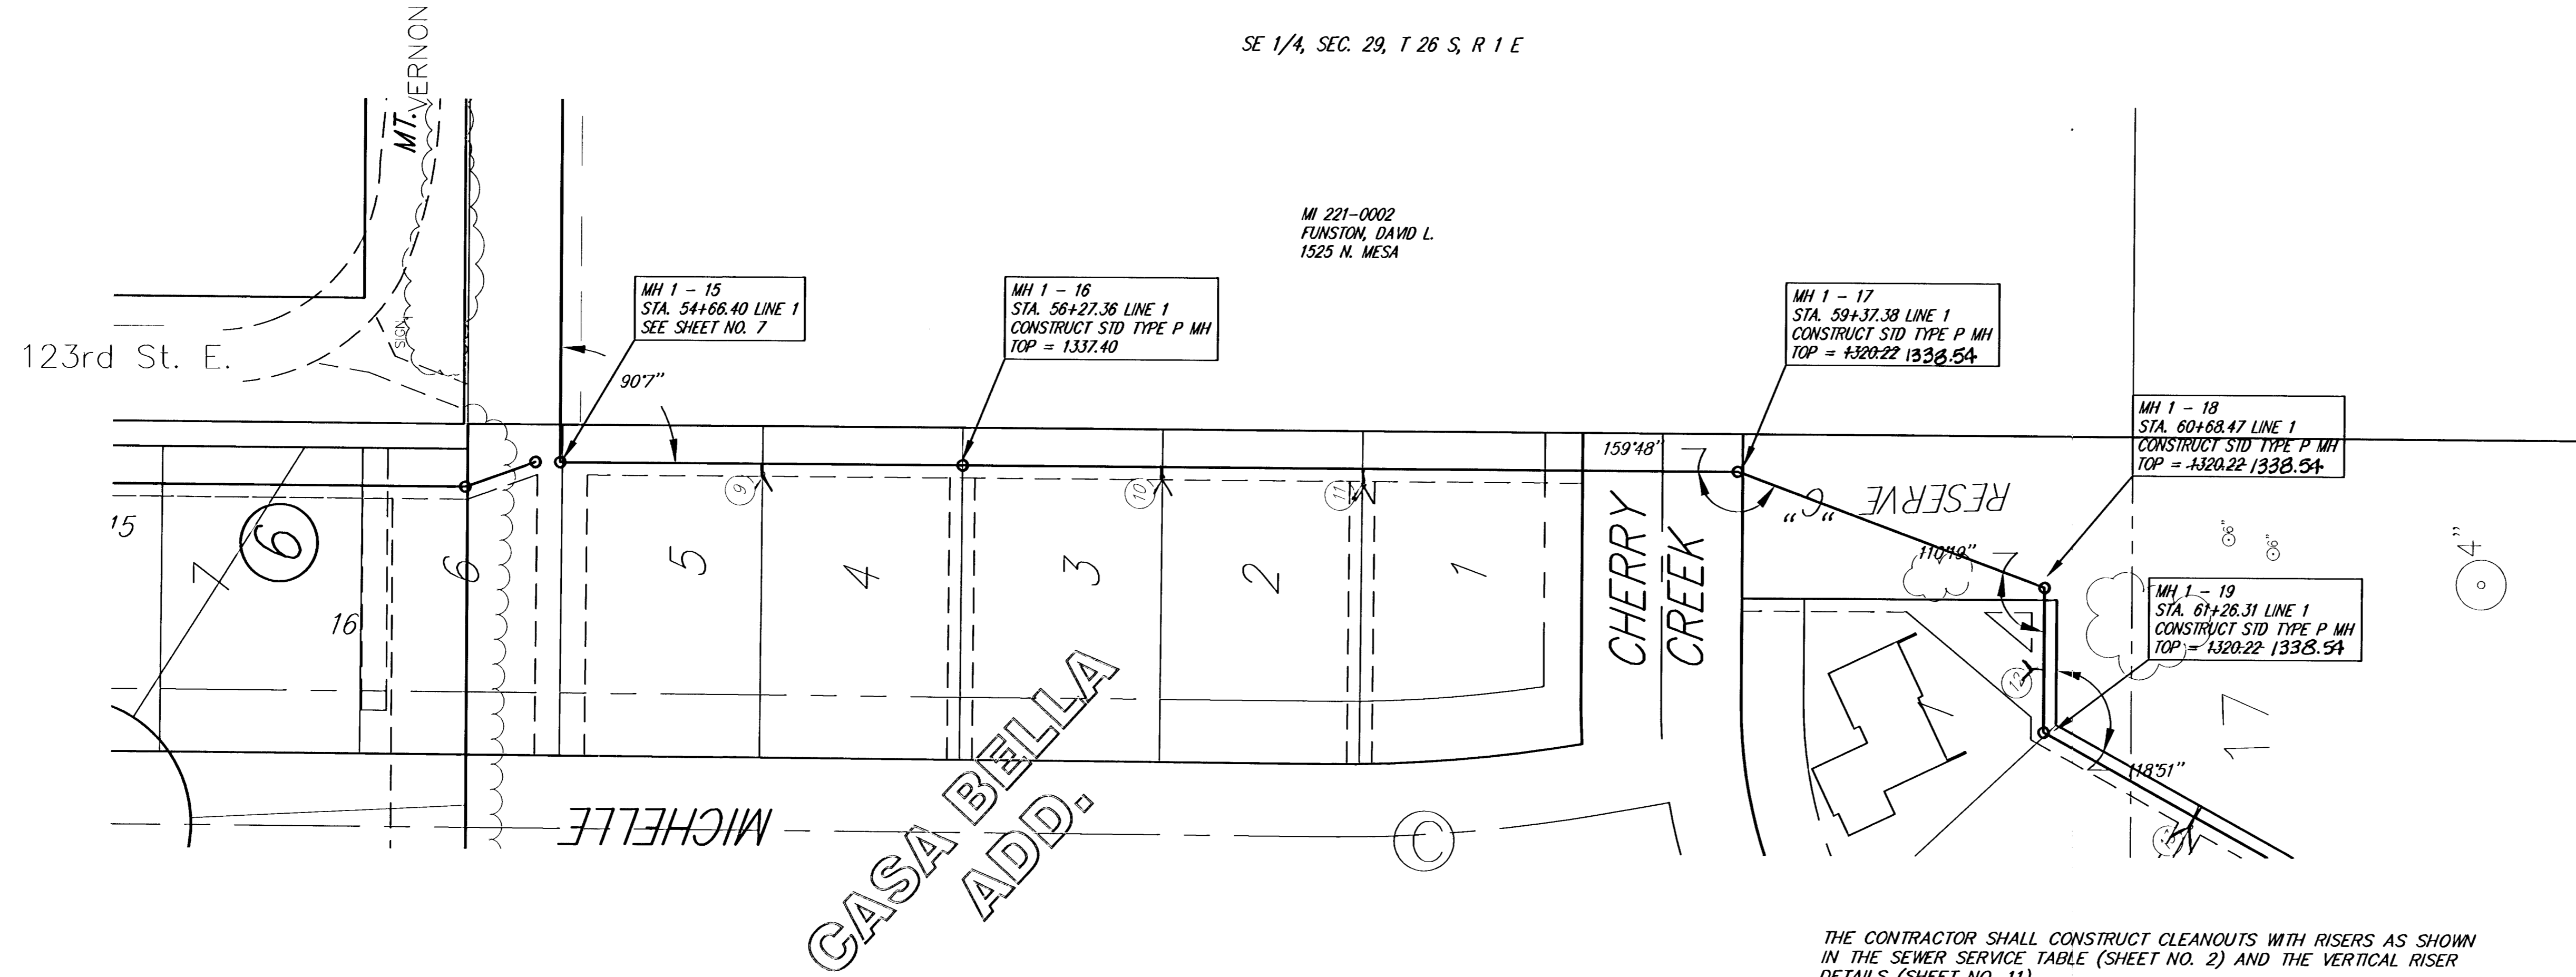

Scale 1" = 40' (Horiz.)  
1" = 5' (Vert.)

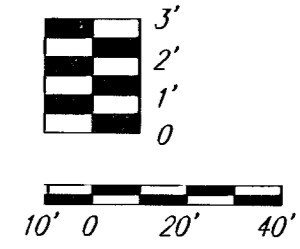

THE CONTRACTOR SHALL CONSTRUCT CLEANOUTS WITH RISERS AS SHOWN IN THE SEWER SERVICE TABLE (SHEET NO. 2) AND THE VERTICAL RISER DETAILS (SHEET NO. 1).

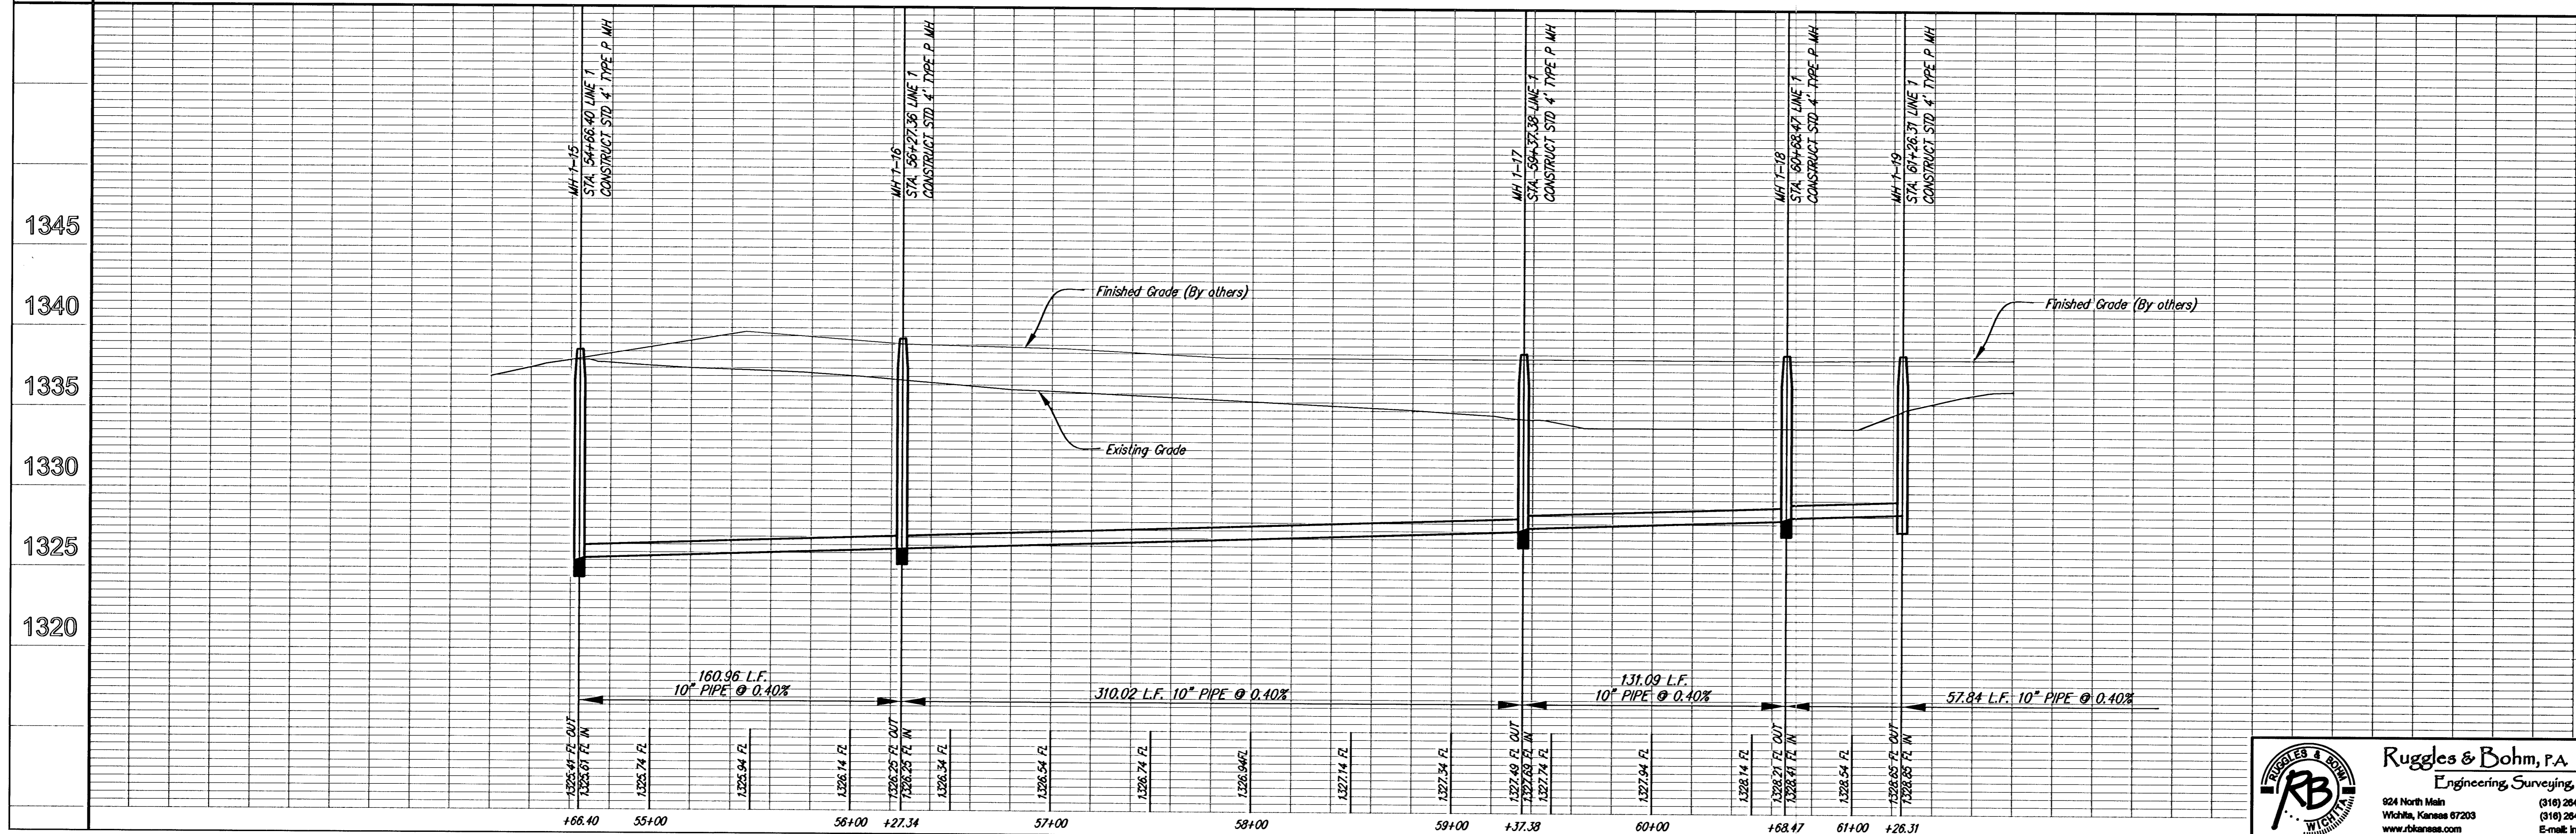

DESIGN	UTILITY	DATE	9/27/05	REVIEW	11/17/05
PROJECT NUMBER	468-64026	DESIGNER	eng: base	DRAWN	PCC
SANITARY SEWER MAIN LINE 1, MCEVOY WICHITA, KANSAS					
1320	1325	1330	1335	1340	1345

**Ruggles & Bohm, P.A.**  
Engineering, Surveying, Land Planning

924 North Main  
Wichita, Kansas 67203  
www.rbkansas.com

(316) 264-8008  
(316) 264-4621 fax  
E-mail: info@rbkansas.com

RB JOB 2612X  
SHEET 8  
17