




SE 1/4, SEC. 29, T 26 S, R 1 E

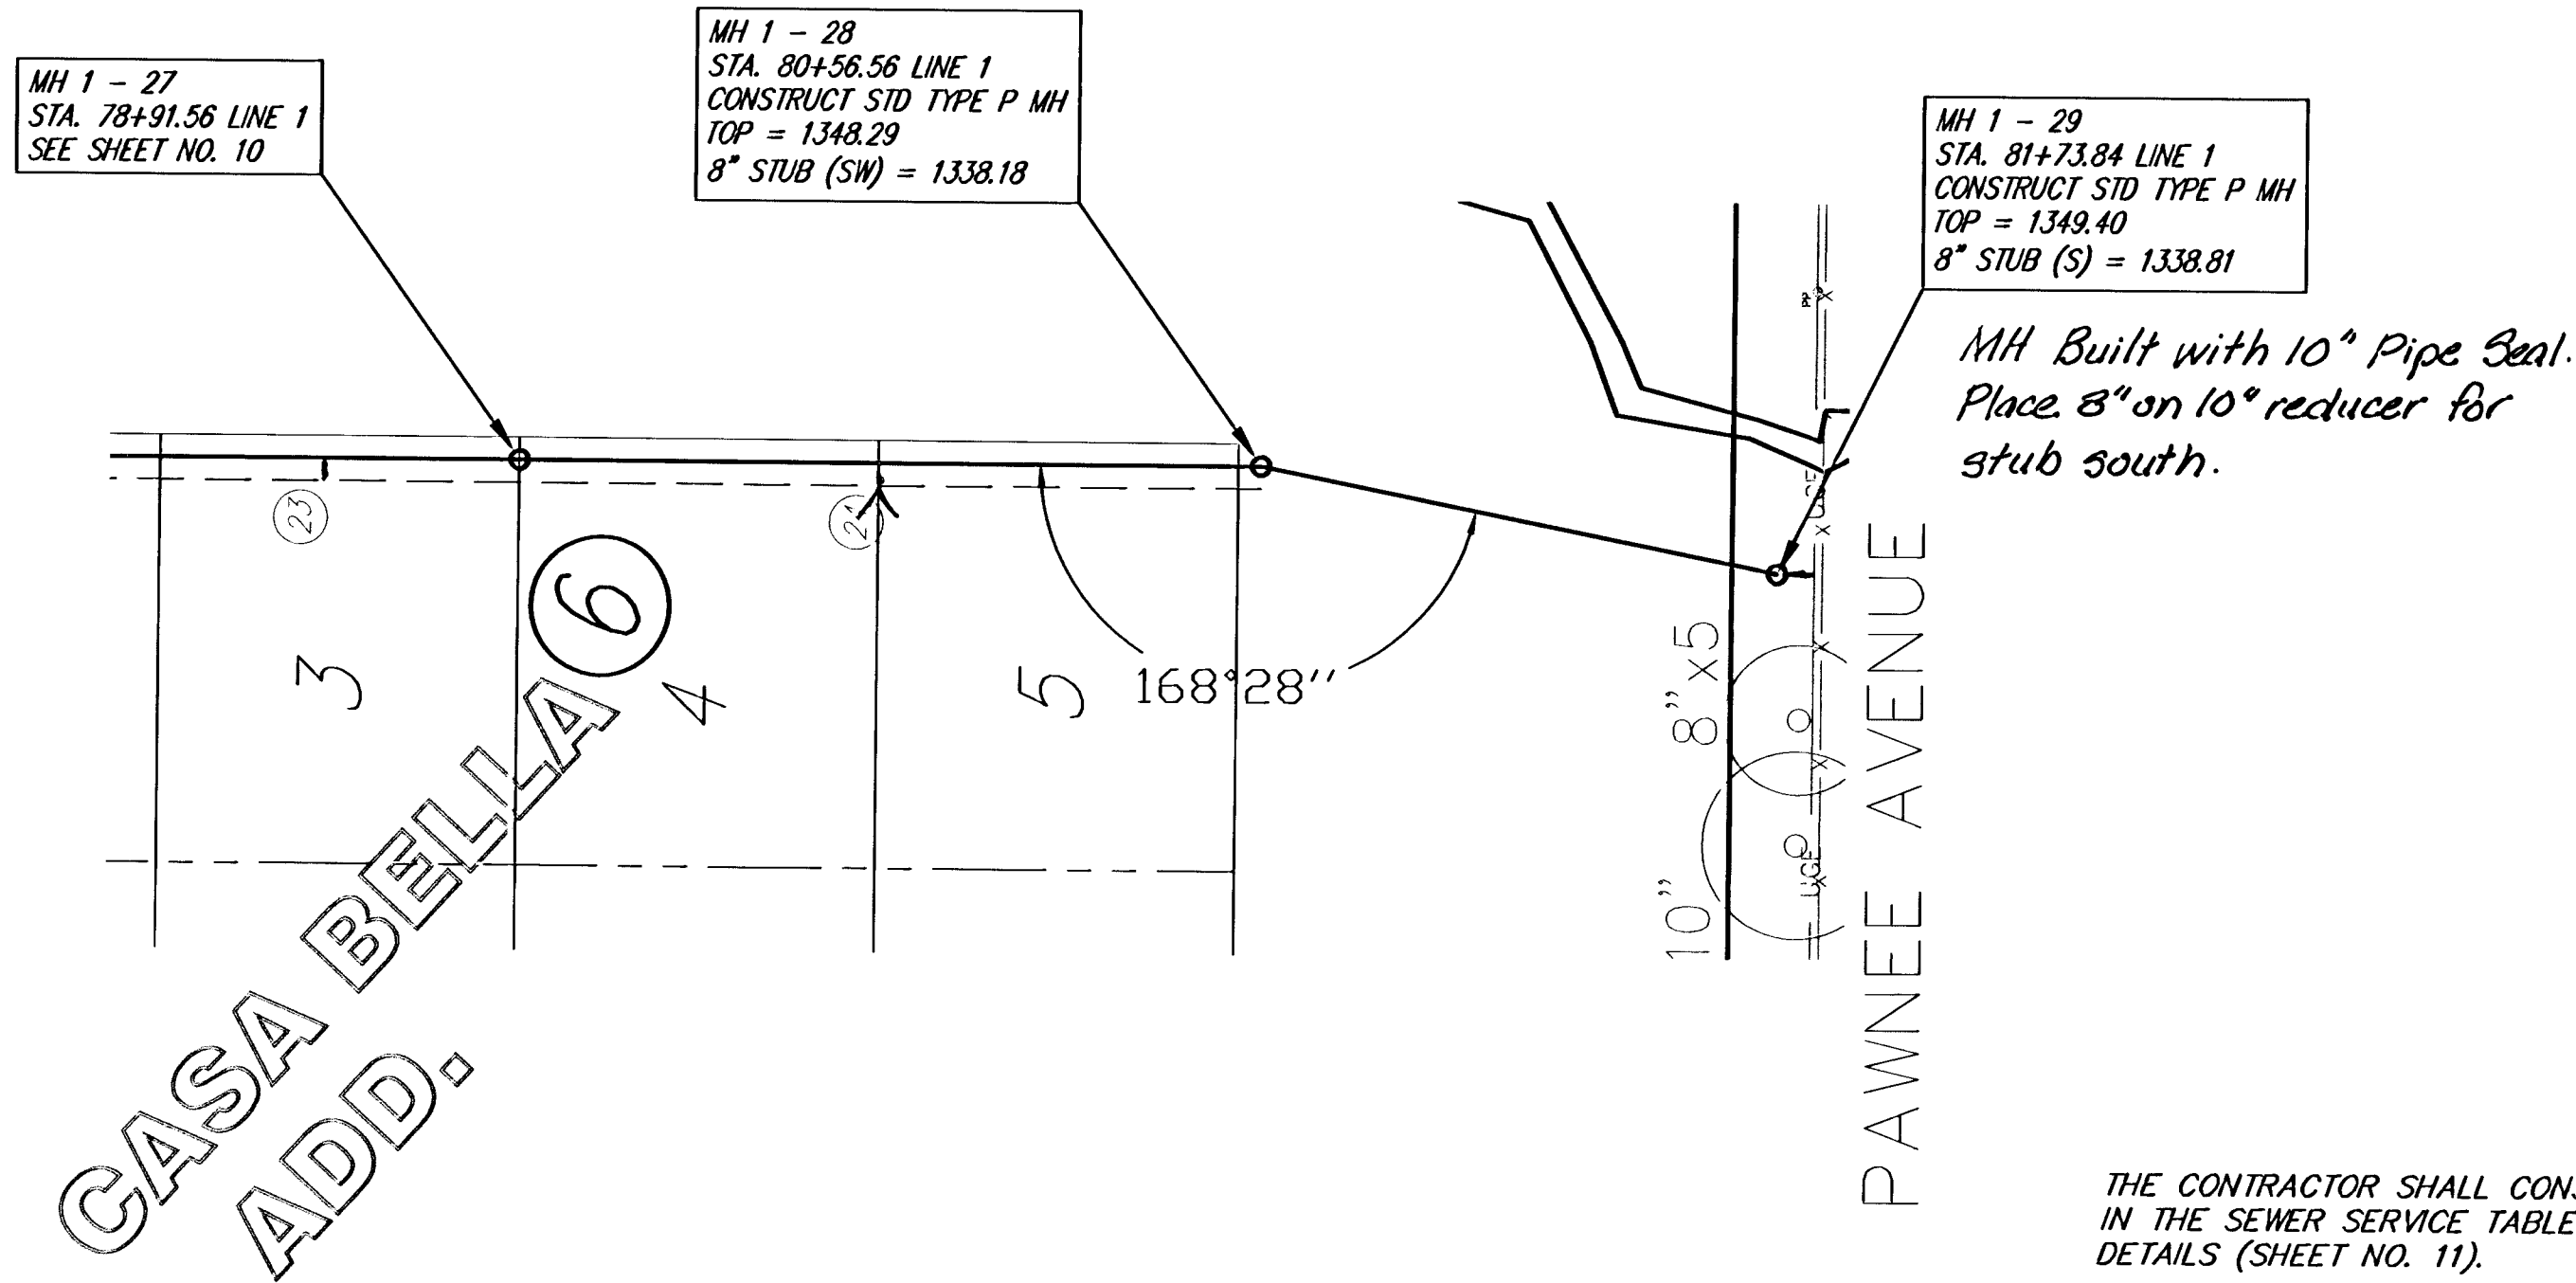


Scale 1" = 40' (Horiz.)
1" = 5' (Vert.)

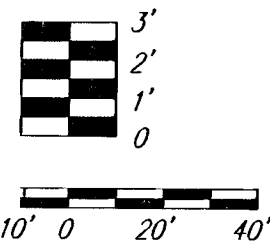

THE CONTRACTOR SHALL CONSTRUCT CLEANOUTS WITH RISERS AS SHOWN
IN THE SEWER SERVICE TABLE (SHEET NO. 2) AND THE VERTICAL RISER
DETAILS (SHEET NO. 11).

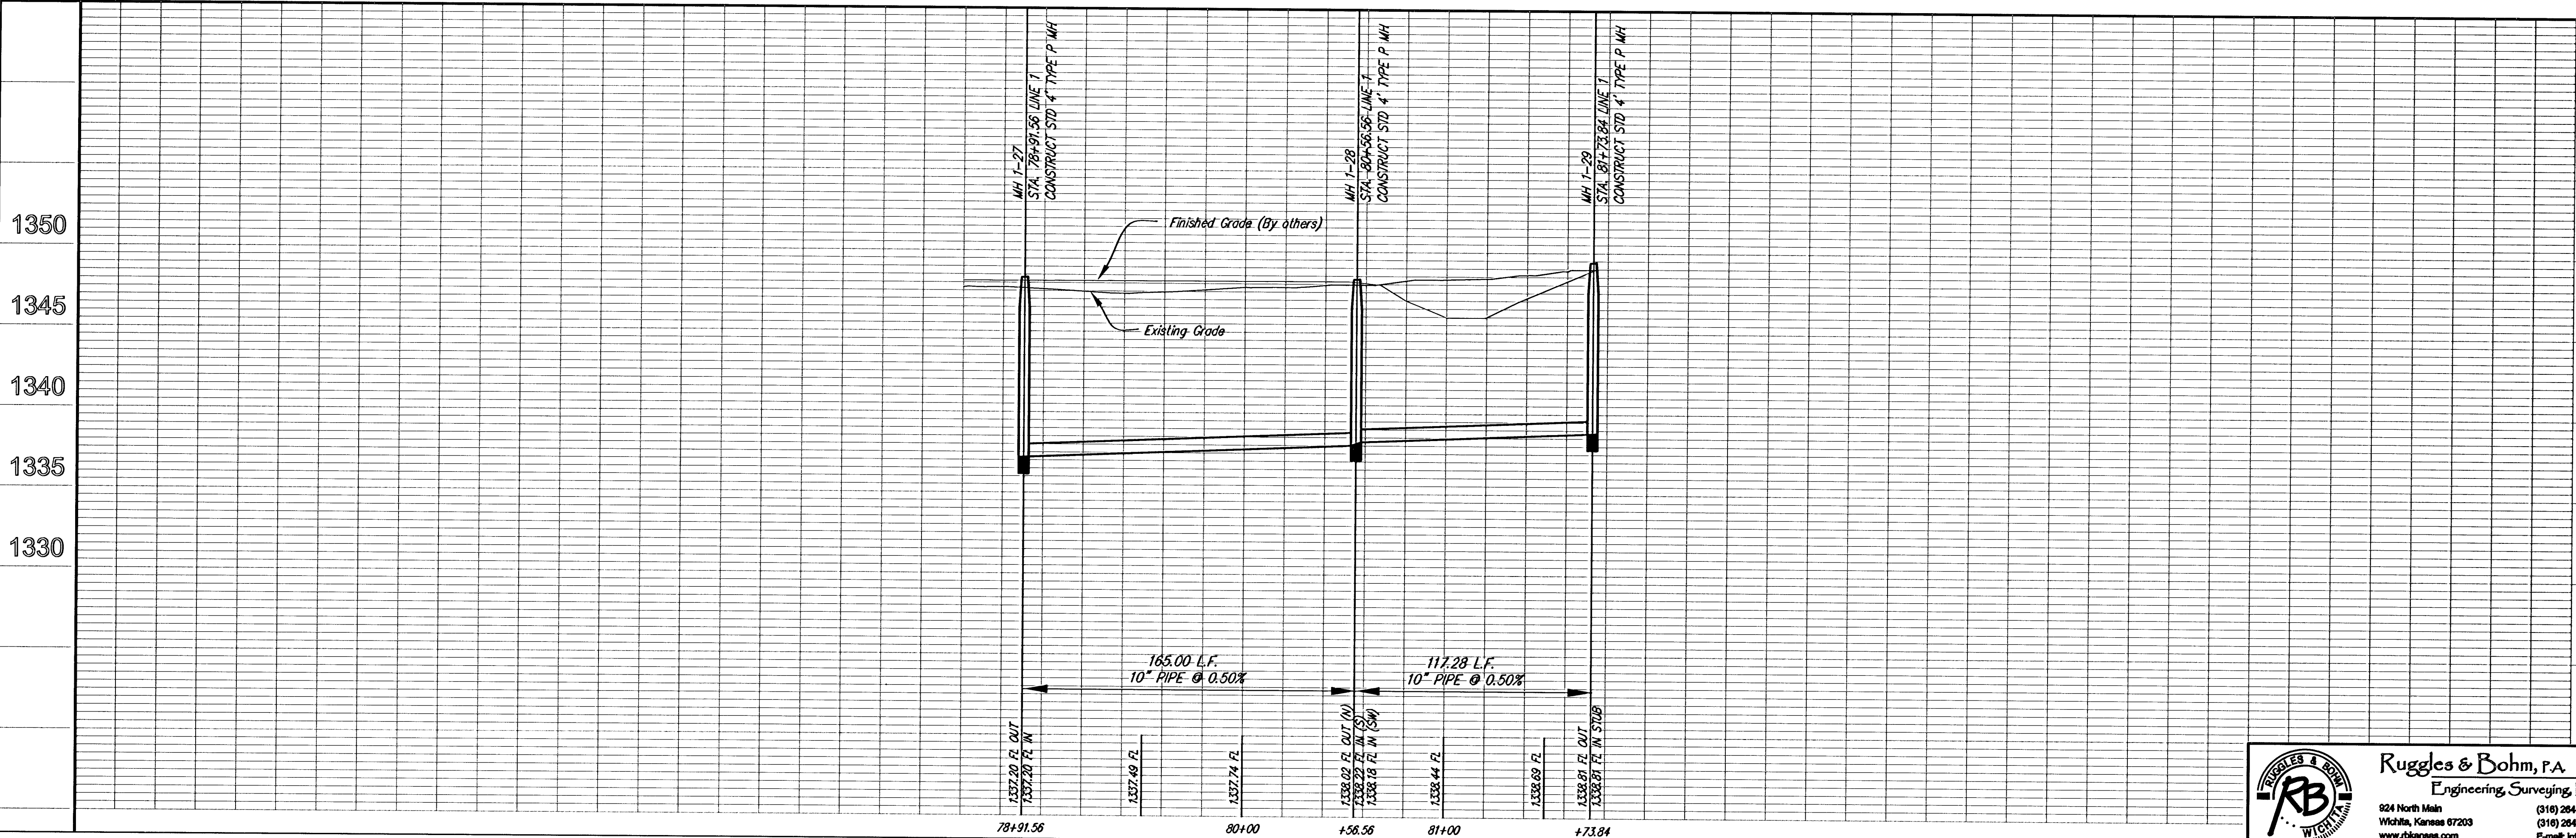

PROJECT NUMBER		DESIGN		REVIEW	
468-84026		PDC	PDC	DATE	REVIEW
DRAWING FILE		UTILITY	DATE	9/27/05	12/14/05
engg. base					
SANITARY SEWER MAIN					
LINE 1, MCEVOY					
WICHITA, KANSAS					

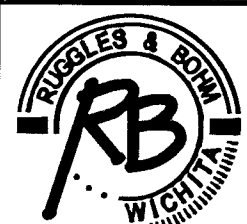

Ruggles & Bohm, P.A.
Engineering, Surveying, Land Planning
924 North Main
Wichita, Kansas 67203
(316) 264-8008
(316) 264-4821 fax
E-mail: info@rbkansas.com

RB JOB	2612X
SHEET	11
OF	17