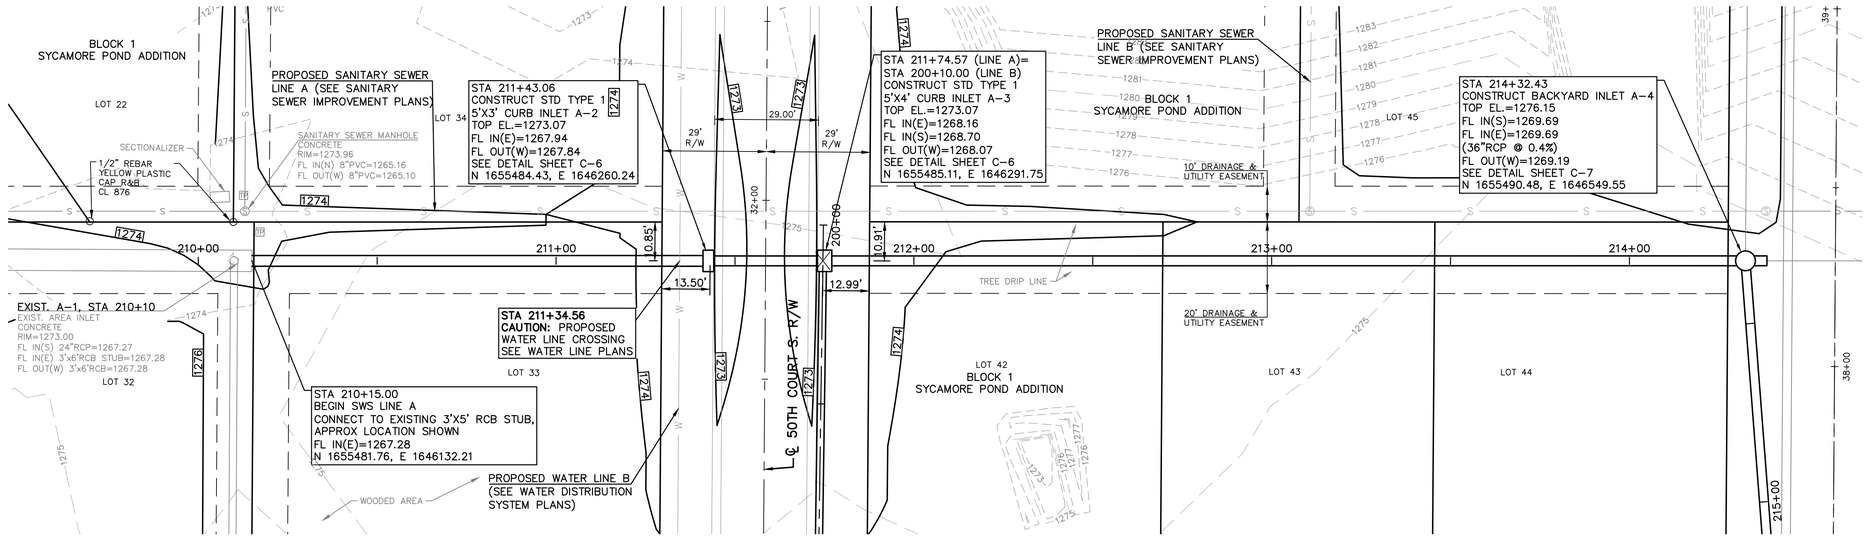

SWS LINE A

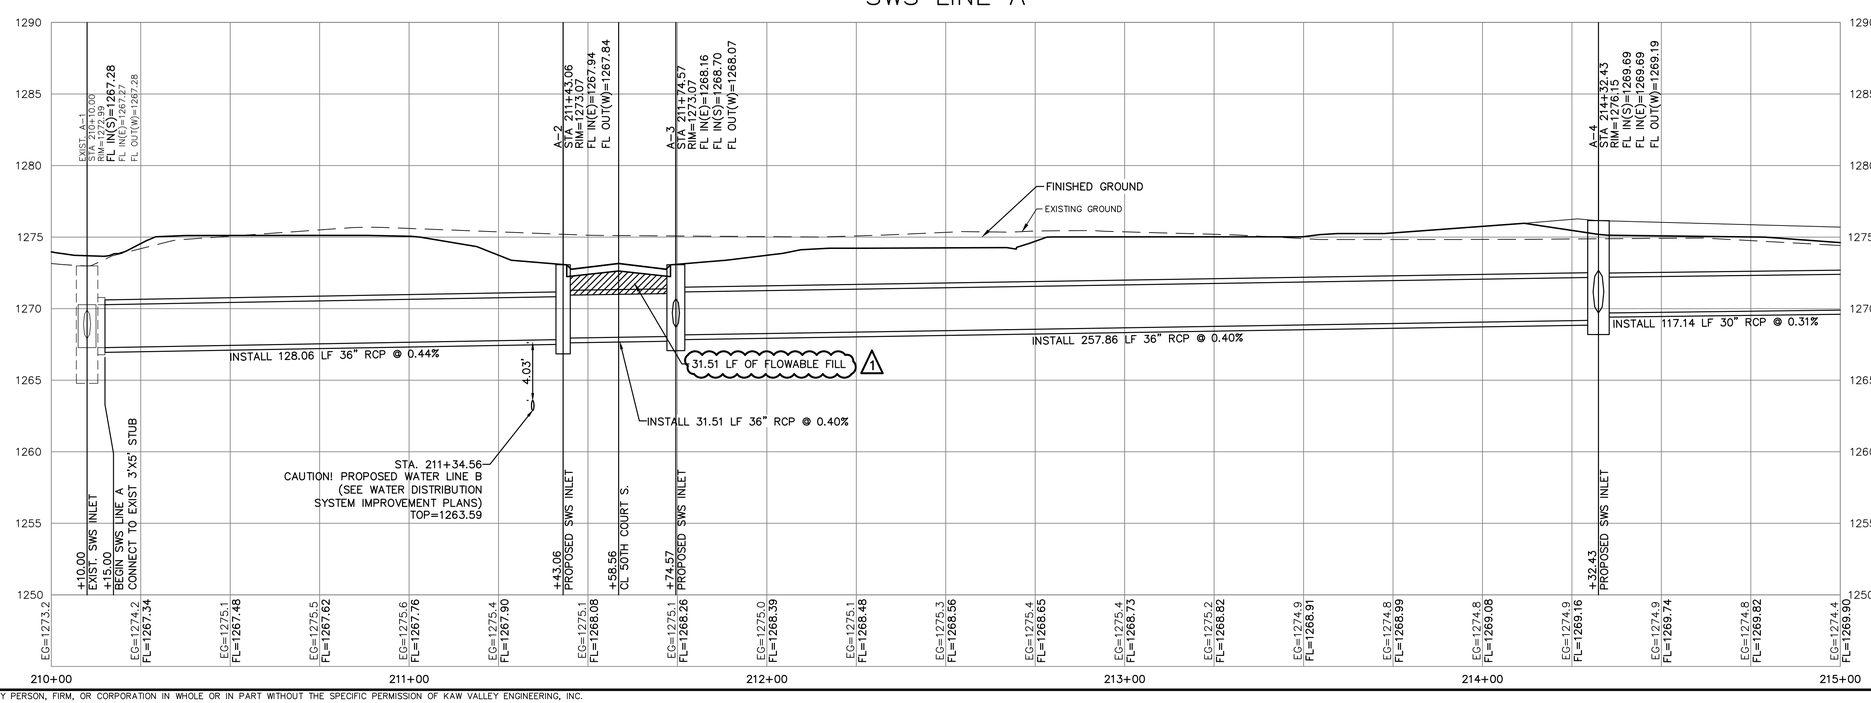

REV	DATE	DESCRIPTION	DSN	DWN	CHK
1	6-1-22	REVISED PER CITY & CLIENT COMMENT	KM	JT	KS
0	4-15-22	INITIAL ISSUE	SRB	JT	KS

EKATERINA MIKHAILICHENKO
LICENSED
28404
6/1/2022
KANSAS
PROFESSIONAL ENGINEER

SHAWN R. BRYAN
ENGINEER
KS # 17899

200 N. EMPORIA, SUITE 100
WICHITA, KANSAS 67202
PH. (316) 440-4304 | FAX (316) 440-4309
wf@kveng.com | www.kveng.com

KAW VALLEY ENGINEERING

KAW VALLEY ENGINEERING, INC., IS AUTHORIZED TO OFFER ENGINEERING SERVICES BY KANSAS STATE CERTIFICATE OF AUTHORIZATION # E-113.
EXPIRES 12/31/22

SYCAMORE POND ADDITION

W 50TH STREET S & S OSAGE CIRCLE
WICHITA, KANSAS

PHASE II - STORM SEWER IMROVEMENTS
STORM SEWER LINE A - PLAN & PROFILE

PROJ. NO.	G19_1259
DESIGNER	TRA
DRAWN BY	JT
CFN	1259-1D_DPP
SHEET	3
REV	1

THIS DRAWING SHALL NOT BE UTILIZED BY ANY PERSON, FIRM, OR CORPORATION IN WHOLE OR IN PART WITHOUT THE SPECIFIC PERMISSION OF KAW VALLEY ENGINEERING, INC.