


EXTENSIVE REVISIONS

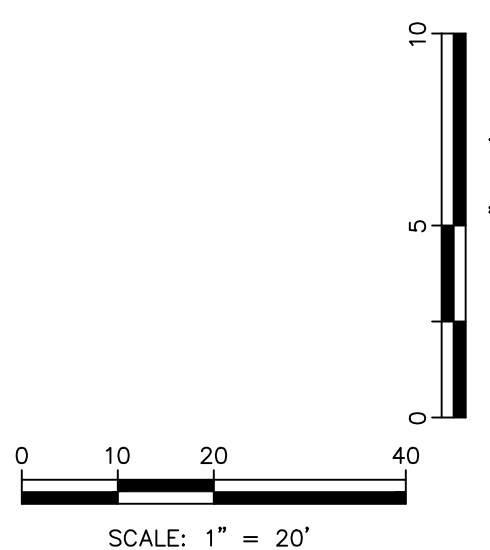

**SYCAMORE POND ADDITION**  
**W 50TH STREET S & S OSAGE CIRCLE**  
**WICHITA, KANSAS**

**PHASE II - PAVEMENT IMPROVEMENT PLANS**  
**W. 50TH STREET S. - CROSS SECTIONS**

PROJ. NO. **G19-1259-1**  
 DESIGNER **TRA** DRAWN BY **JT**

CFN **1259-1P-STPP**  
 SHEET **18** REV **2**

REV	DATE	DESCRIPTION	BY	CHK
2	6-1-22	REVISED PER CITY AND CLIENT COMMENT	KM	KS
1	5-25-22	REVISED PER CITY COMMENT	SRB	KS
0	4-15-22	INITIAL ISSUE	SRB	KS

**EKATERINA MIKHAYLICHENKO**  
 ENGINEER  
 KS # 28404

200 N. EMPORIA, SUITE 100  
 WICHITA, KANSAS 67202  
 PH. (316) 440-4304 | FAX (316) 440-4309  
 www.kveeng.com | www.kveeng.com

**KAW VALLEY ENGINEERING**  
 KAW VALLEY ENGINEERING, INC., IS AUTHORIZED TO OFFER ENGINEERING SERVICES BY KANSAS STATE CERTIFICATE OF AUTHORIZATION # E-113. EXPIRES 12/31/22

**28404**  
 6/1/2022  
 KANSAS  
 PROFESSIONAL ENGINEER