
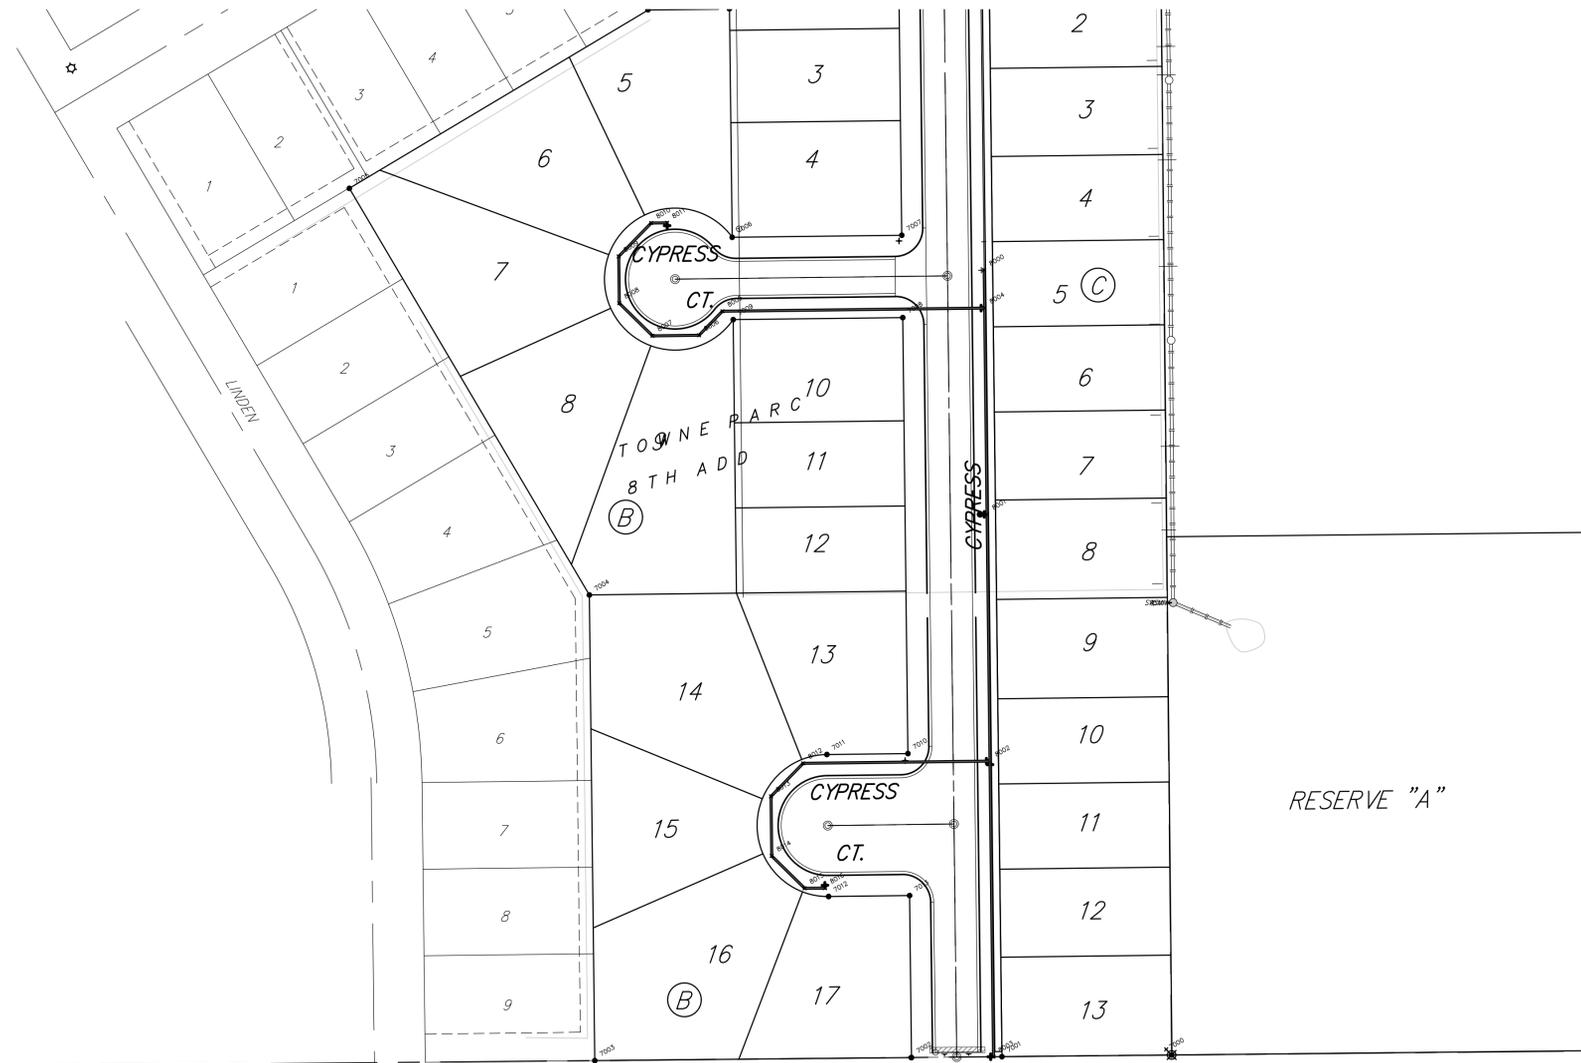


WATER LINES

Point Table			
Point #	Northing	Easting	Raw Description
8000	1670810.33	1679680.72	Sta. 0+00, Line 1-Exist. Blowoff
8001	1670638.35	1679682.76	Sta. 1+72, Line 1-Fire Hydrant
8002	1670464.56	1679684.83	Sta. 3+45.8, Line 1-8"x8" TEE
8003	1670256.37	1679687.31	Sta. 5+59.07, Line 1-Blowoff Assy
8004	1670783.61	1679681.04	Sta. 0+00, Line 2-Tapping Sleeve
8005	1670781.40	1679495.50	Sta. 1+85.6, Line 2-45° Bend
8006	1670764.48	1679478.97	Sta. 2+09.2, Line 2-45° Bend
8007	1670764.09	1679446.06	Sta. 2+42.1, Line 2-45° Bend
8008	1670787.08	1679422.52	Sta. 2+75, Line 2-45° Bend
8009	1670819.99	1679422.13	Sta.3+07.9, Line 2-45° Bend
8010	1670843.54	1679445.12	Sta. 3+40.8, Line 2-45° Bend
8011	1670843.67	1679456.34	Sta. 3+52, Line 2-Blowoff
8012	1670462.98	1679552.61	Sta. 1+32.2, Line 3-45° Bend
8013	1670439.73	1679529.90	Sta. 1+64.7, Line 3-45° Bend
8014	1670397.73	1679530.40	Sta. 2+06.7 Line 3-45° Bend
8015	1670374.98	1679553.71	Sta. 2+39.3, Line 3-45° Bend
8016	1670375.09	1679568.14	Sta. 2+53.7, Line 3-Blowoff

PROPERTY IRONS

Point Table			
Point #	Northing	Easting	Raw Description
7000	1670261.56	1679809.52	Prop_Iron
7001	1670256.40	1679693.31	Prop_Iron
7002	1670255.78	1679629.31	Prop_Iron
7003	1670253.55	1679405.19	Prop_Iron
7004	1670581.36	1679401.32	Prop_Iron
7005	1670867.75	1679231.54	Prop_Iron
7006	1670833.49	1679502.43	Prop_Iron
7007	1670834.92	1679622.42	Prop_Iron
7008	1670776.92	1679623.11	Prop_Iron
7009	1670775.49	1679503.12	Prop_Iron
7010	1670469.87	1679626.77	Prop_Iron
7011	1670469.18	1679569.45	Prop_Iron
7012	1670369.19	1679570.64	Prop_Iron
7013	1670369.87	1679627.96	Prop_Iron

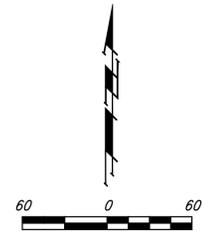

Baughman Company, P.A.  

TOWNE PARC 8TH ADDITION-PHASE II  
**COORDINATE POINTS**  
 WATER DISTRIBUTION SYSTEM

