

WATER LINES

Point Table			
Point #	Northing	Easting	Raw Description
30000	20974.94	31306.43	Sta. 0+00, Line 1-Exist. Blowoff
30001	21149.94	31306.52	Sta. 1+75, Line 1-8" x 8" Cross
30002	21273.94	31306.58	Sta. 2+98, Line 1-45' Bend
30003	21275.94	31306.58	Sta. 3+01, Line 1-45' Bend
30004	21288.94	31306.58	Sta. 3+13, Line 1-45' Bend
30005	21290.94	31306.59	Sta. 3+16, Line 1-45' Bend
30007	21451.94	31306.66	Sta. 4+77, Line 1-8" x 8" Cross
30008	21574.94	31306.72	Sta. 6+00, Line 1-Exist. Blowoff
30009	21150.05	31073.52	Sta. 2+33, Line 2-FH
30010	21150.16	30857.67	Sta. 4+48.85, Line 2-45' Bend
30011	21166.89	30840.95	Sta. 4+72.5, Line 2-45' Bend
30012	21166.91	30808.04	Sta. 5+05.43, Line 2-45' Bend
30013	21143.65	30784.76	Sta. 5+38.32, Line 2-45' Bend
30014	21110.74	30784.74	Sta. 5+71.23, Line 2-45' Bend
30015	21087.45	30808.00	Sta. 6+04.14, Line 2-45' Bend
30016	21087.43	30851.00	Sta. 6+74.14, line 2-Blowoff
30017	21149.77	31671.52	Sta. 3+65, Line 3-FH
30018	21153.37	31925.98	Sta. 6+23.06, Line 3-45' Bend
30020	21126.44	31952.88	Sta. 6+59.07, Line 3-45' Bend
30023	21100.82	31952.87	Sta. 6+84.68, Line 3-45' Bend
30024	21073.92	31925.94	Sta. 7+19.18, Line 3-45' Bend

WATER LINES



Point Table			
Point #	Northing	Easting	Raw Description
30025	21073.94	31885.48	Sta. 7+54.62, Line 3-Blowoff
30026	21452.09	31000.66	Sta. 3+06, Line 4-FH
30027	21452.16	30857.82	Sta. 4+48.85, Line 4-45' Bend
30028	21468.89	30841.10	Sta. 4+72.5, Line 4-45' Bend
30029	21468.91	30808.19	Sta. 5+05.41, Line 4-45' Bend
30030	21445.65	30784.90	Sta. 5+38.32, Line 4-45' Bend
30031	21412.74	30784.89	Sta. 5+71.24, Line 4-45' Bend
30032	21389.45	30808.15	Sta. 6+04.15, Line 4-45' Bend
30033	21389.43	30851.15	Sta. 6+47.15, Line 4-Blowoff
30038	21451.91	31369.66	Sta. 0+68, Line 5-FH
30039	21451.88	31436.66	Sta. 1+30, Line 5-P.V.I.
30040	21451.84	31526.48	Sta. 2+19.82, Line 5-45' Bend
30041	21468.55	31543.22	Sta. 2+43.47, Line 5-45' Bend
30042	21468.54	31576.13	Sta. 2+76.38, Line 5-45' Bend
30044	21441.67	31602.96	Sta. 3+14.36, Line 5-45' Bend
30045	21415.92	31602.95	Sta. 3+40.11, Line 5-45' Bend
30047	21389.09	31576.09	Sta. 3+77.60, Line 5-45' Bend
30048	21389.11	31533.09	Sta. 4+20.6, Line 5-Blowoff
30049	21149.66	31889.34	Sta. 5+82.82, Line 3-45' Bend
30050	21153.39	31893.06	Sta. 5+88.09, Line 3-45' Bend

PROPERTY IRONS

Point Table			
Point #	Northing	Easting	Raw Description
10000	20959.57	32079.43	PROP_COR
10001	29290.61	31364.93	PROP_COR
10002	20959.94	31300.43	PROP_COR
10003	20960.25	30669.40	PROP_COR
10004	21580.25	30669.69	PROP_COR
10005	21579.94	31300.72	PROP_COR
10006	21579.91	31364.72	PROP_COR
10007	21579.74	31724.75	PROP_COR
10008	21292.74	31724.62	PROP_COR
10009	21292.57	32079.59	PROP_COR
10010	21097.67	31862.12	PROP_COR
10011	21155.67	31882.39	PROP_COR
10012	21097.91	31364.49	PROP_COR
10013	21155.91	31364.52	PROP_COR
10014	21155.94	31300.52	PROP_COR
10015	21097.94	31300.49	PROP_COR
10016	21098.15	30865.19	PROP_COR
10017	21156.15	30865.22	PROP_COR
10018	21400.15	30865.34	PROP_COR
10019	21458.15	30865.37	PROP_COR

PROPERTY IRONS

Point Table			
Point #	Northing	Easting	Raw Description
10020	21399.94	31300.64	PROP_COR
10021	21399.91	31364.64	PROP_COR
10022	21457.91	31364.67	PROP_COR
10023	21457.94	31300.67	PROP_COR
10024	21399.84	31518.91	PROP_COR
10025	21457.84	31518.93	PROP_COR
10026	21580.25	30669.69	PROP_COR

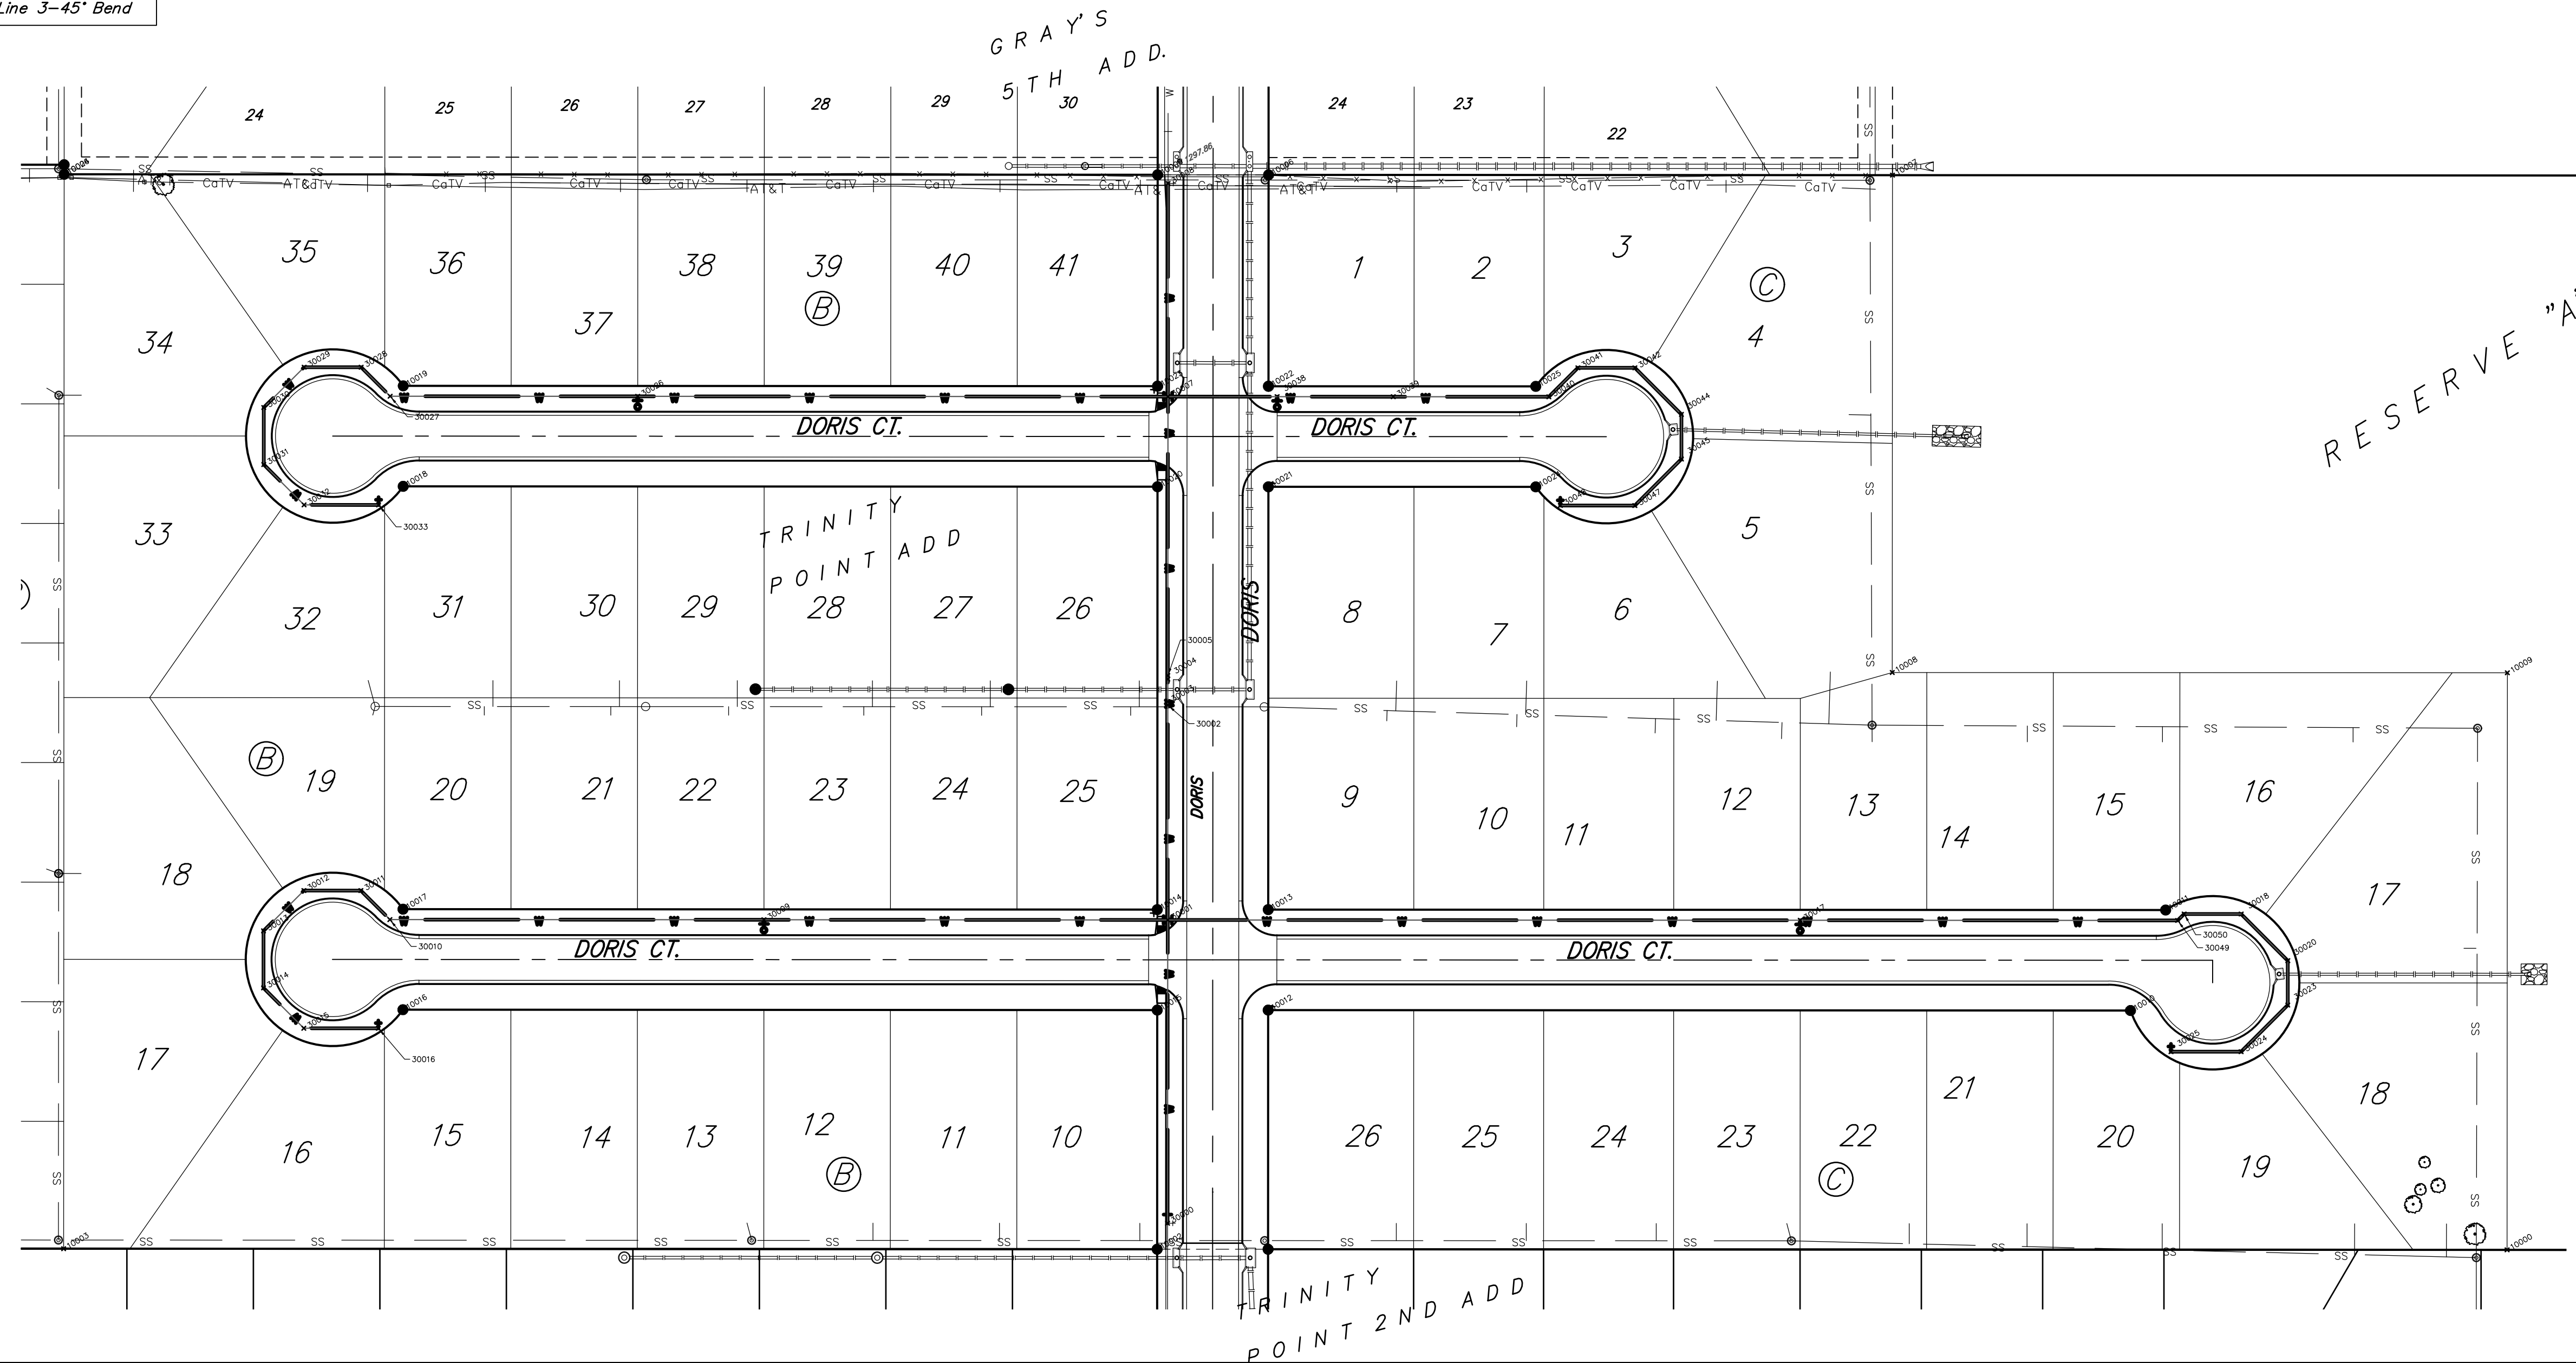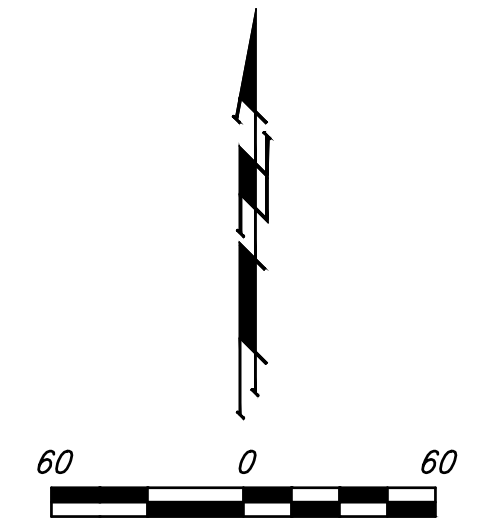

Baughman Company, P.A.
 ENGINEERS, ARCHITECTS, PLANNERS, LANDSCAPE ARCHITECTS
 TRINITY POINT ADDITION PHASE II
COORDINATE POINTS
 WATER DISTRIBUTION SYSTEM
 SHEET
15
18