


CAUTION!!!! PRIVATE UTILITIES EXIST IN AREA. (GAS, FIBER OPTICS, ETC.) CONTRACTOR SHALL COORDINATE CONSTRUCTION ON SEDGWICK COUNTY ZOO PROPERTY WITH SCOTT CHILDS, ZOO OPERATIONS COORDINATOR, AT 648-8318. ANY DAMAGED UTILITIES SHALL BE REPAIRED IMMEDIATELY BY THE CONTRACTOR AT THE CONTRACTORS EXPENSE.

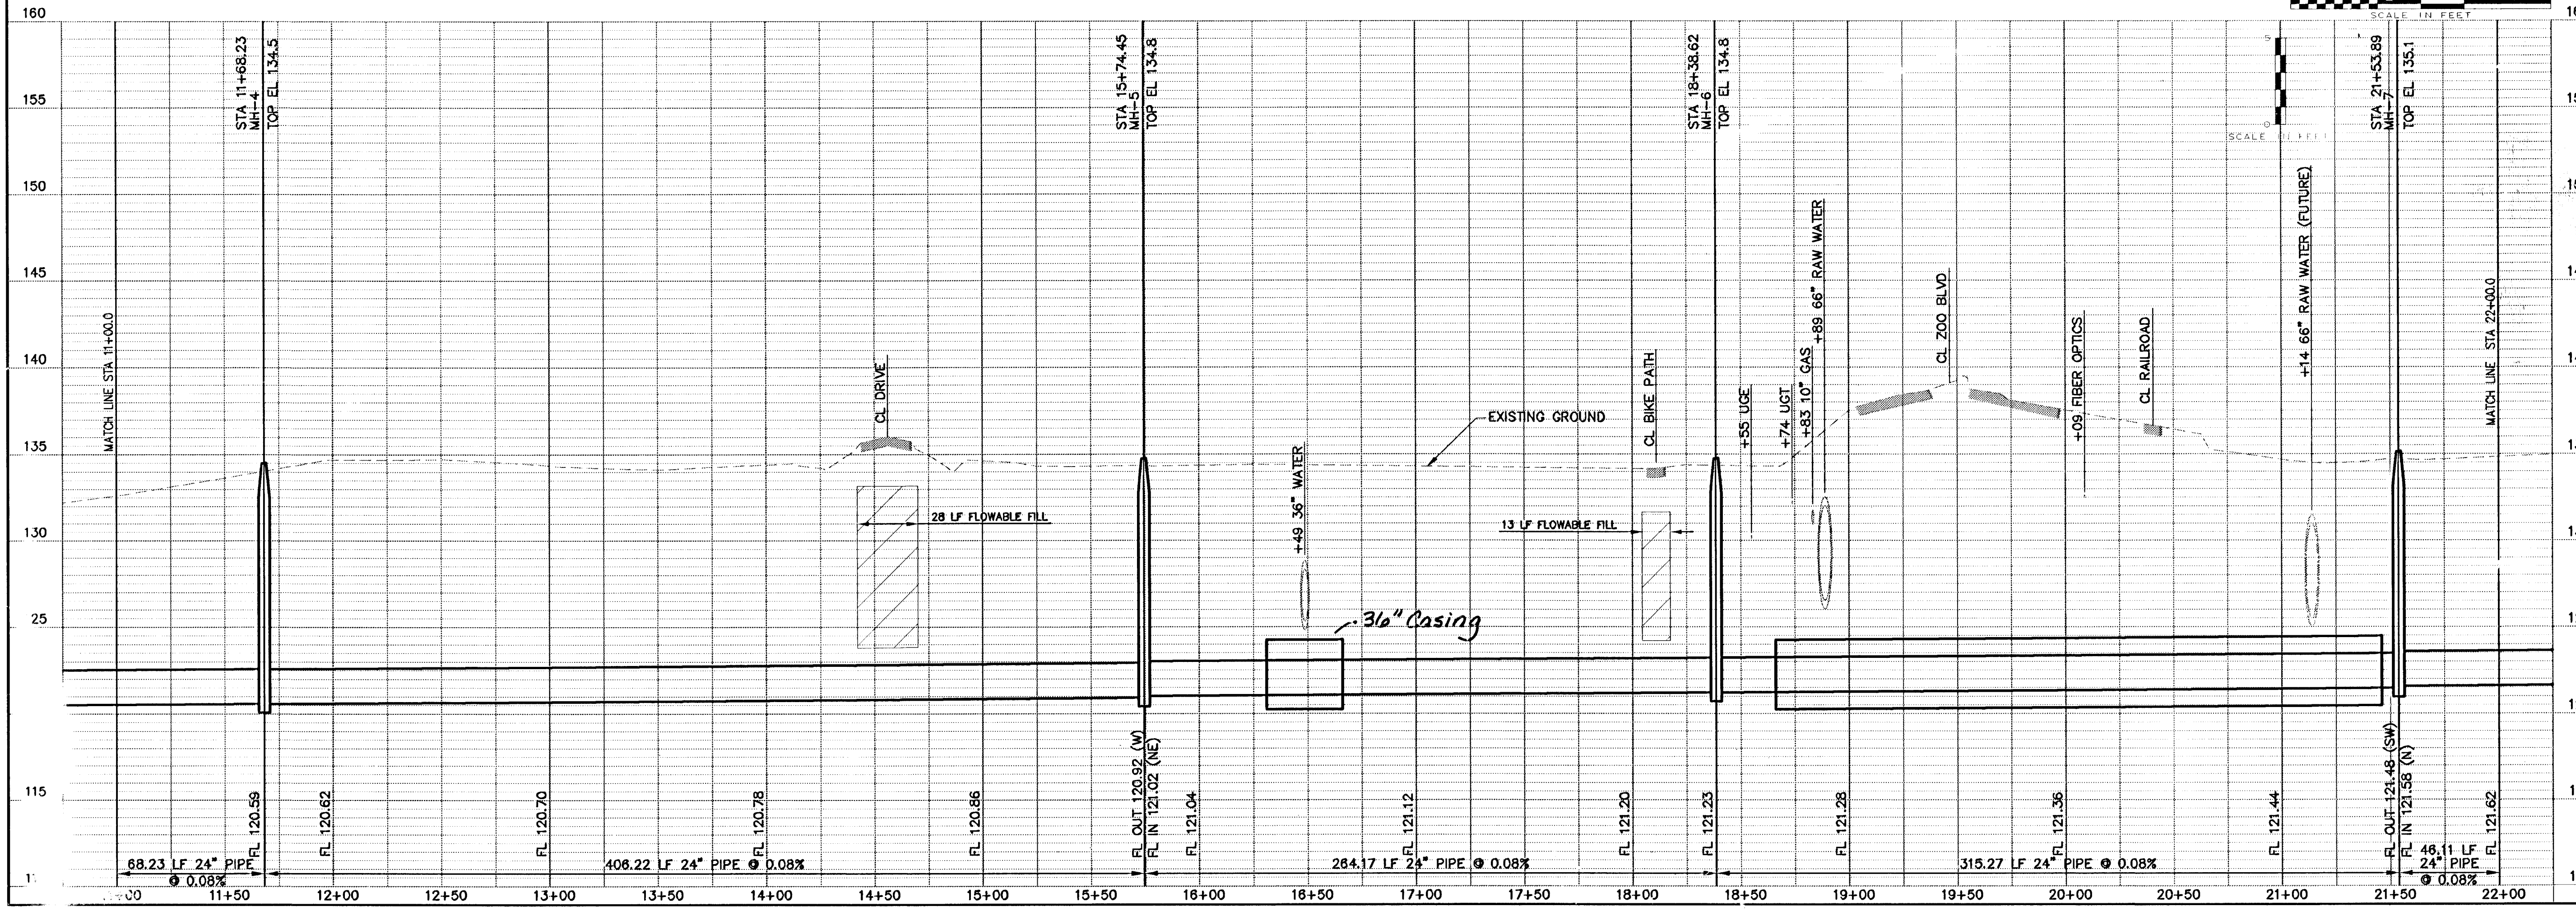

	NO. _____		DATE _____
WILSON & COMPANY			
CITY OF WICHITA, KANSAS MAIN 20 SOUTHWEST INTERCEPTOR SEWER PLAN & PROFILE STA. 11+00.0 TO STA. 22+00.0 <small>JIM L. ARMOUR, P.E. - CITY ENGINEER</small>			
DESIGN	DWH	CHECKED	JLM
DRAWN: MEK/KMD			
DATE: APRIL 2004			
FILE NO.: X1460002			
SHEET NO.: 4			