
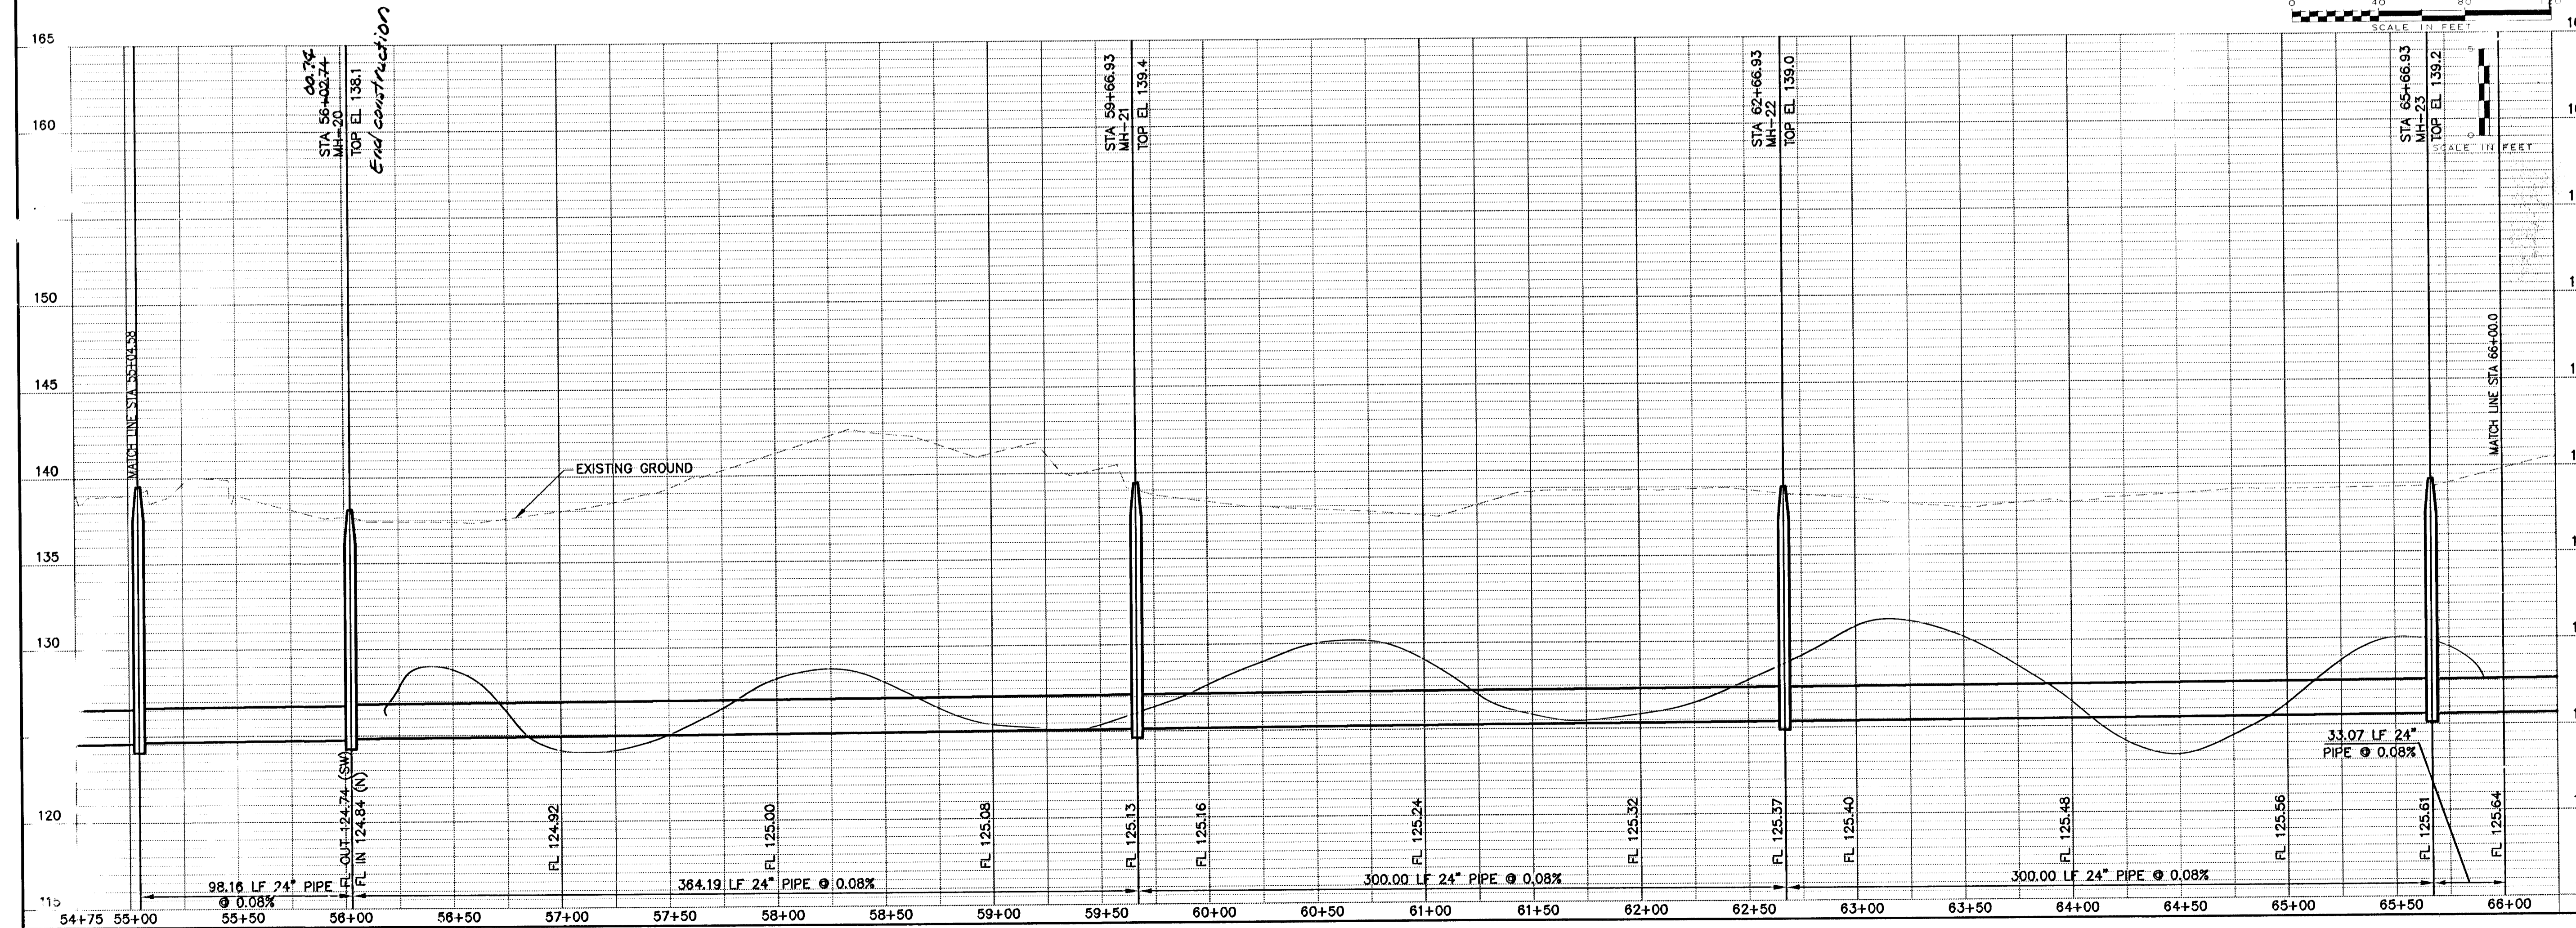


Note: There shall be NO CONSTRUCTION beyond MH-20 as part of this project.

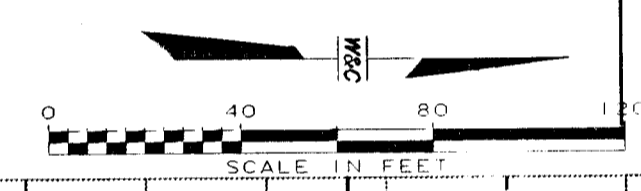

NO.	REVISION	DATE	BY

WILSON & COMPANY
WICHITA, KANSAS

CITY OF WICHITA, KANSAS
 MAIN 20 SOUTHWEST INTERCEPTOR SEWER
 #68-83186
 PLAN & PROFILE
 STA. 55+04.58 TO STA. 66+00.0
 JIM L. ARMOUR, P.E. CITY ENGINEER

DESIGN	DWH	CHECKED	JLM
DRAWN	MEK/KMD	DATE	APRIL 2004
FILE NO.	X1460002	SHEET NO.	8

WILSON & COMPANY
WICHITA, KANSAS