REFER TO SHEET G-0.01 FOR STANDARD DRAWING LEGEND

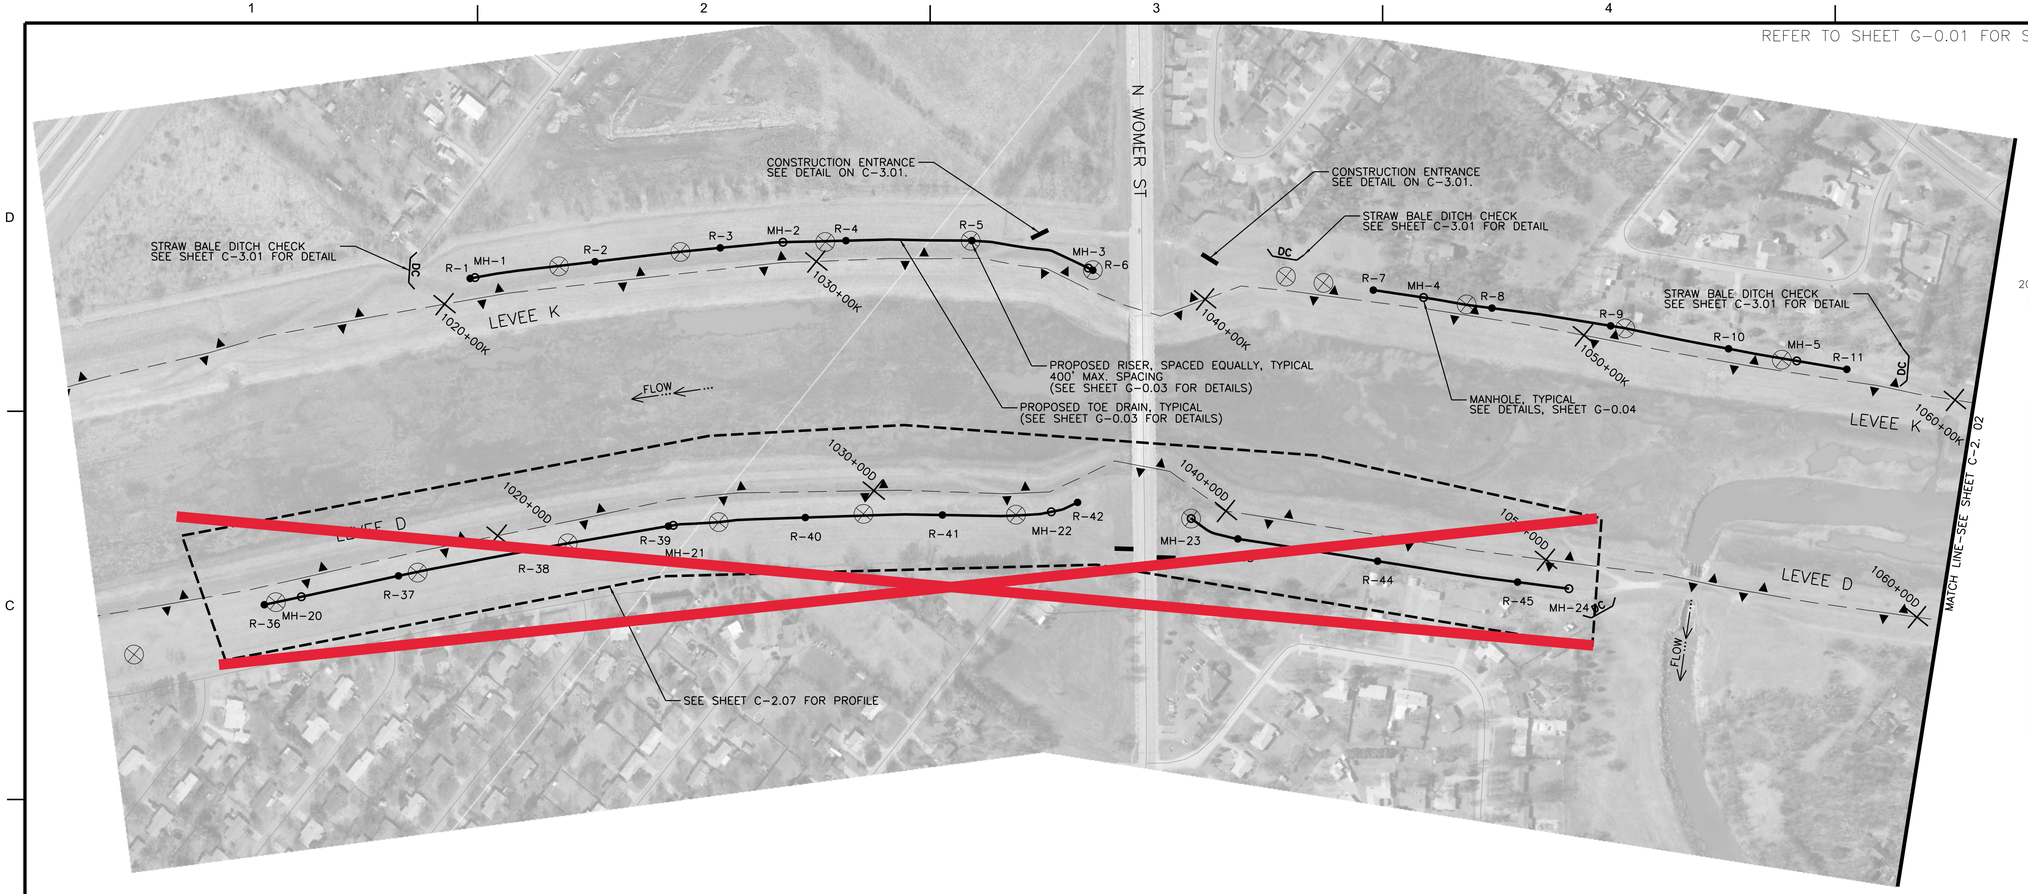

200' 100' 0 200'
GRAPHIC SCALE

RISER/MANHOLE COORDINATES		
POINT NAME	NORTHING	EASTING
MH-1	1706949	1638735
MH-2	1707534	1639308
MH-3	1707988	1639978
MH-4	1708485	1640715
MH-5	1708975	1641586
R-1	1706940	1638727
R-2	1707181	1638955
R-3	1707418	1639189
R-4	1707641	1639435
R-5	1707851	1639693
R-6	1707991	1639991
R-7	1708416	1640599
R-8	1708577	1640873
R-9	1708738	1641146
R-10	1708886	1641426
R-11	1709041	1641703

RISER/MANHOLE COORDINATES AND TOE-DRAIN PIPE INVERT ELEVATIONS ARE BASED LIDAR TOPOGRAPHIC DATA AND MAY REQUIRE MINOR HORIZONTAL AND VERTICAL ADJUSTMENTS TO BE MADE IN THE FIELD. ANY FIELD CHANGES TO THE TOE-DRAIN ALIGNMENT OR PIPE INVERTS SHALL BE APPROVED BY THE CITY OF WICHITA'S STORMWATER ENGINEER.

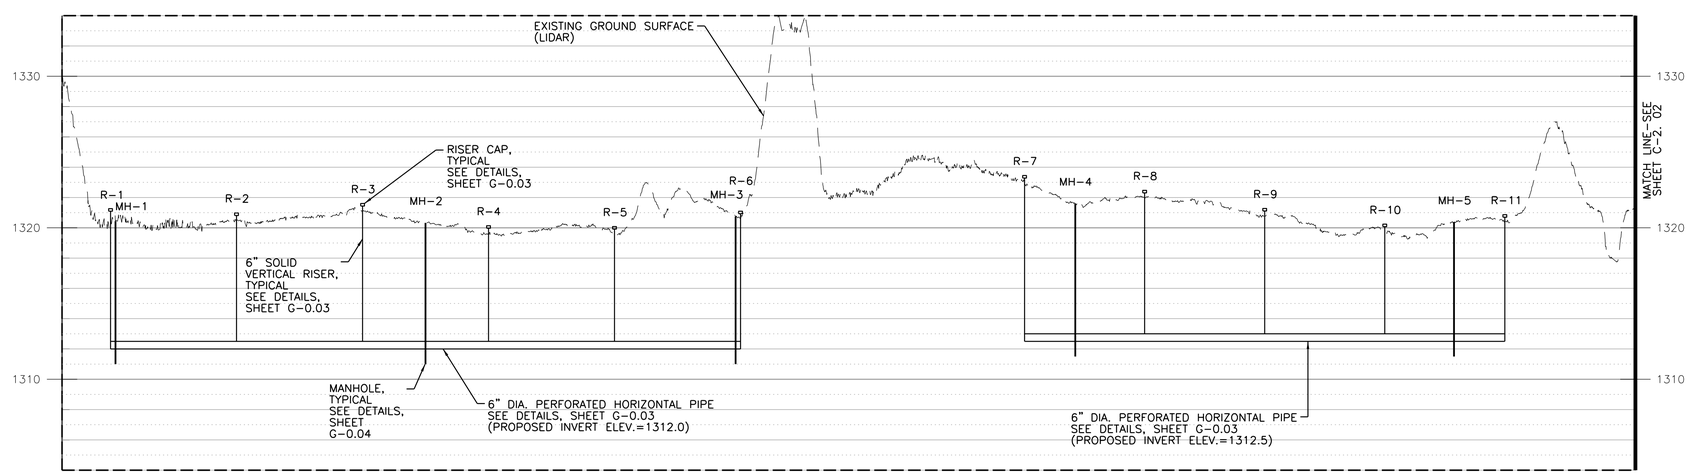

LEVEE K

PROFILE SCALE (40:1 EXAGGERATION):
HORIZONTAL: 1"=200'
VERTICAL: 1"=5'

MARK	DESCRIPTION	DATE	APPR.

amec
AMEC Earth & Environmental, Inc.
1129 SW Wanamaker
Topeka, Kansas 66604
Phone: (785) 272-4630
Fax: (785) 272-4678

CITY OF WICHITA

UPPER LEVEE "D" LEVEES "K", "L", "M", "N" AND "P" TOE DRAIN INSTALLATION
WICHITA-VALLEY CENTER LOCAL FLOOD PROTECTION PROJECT
WICHITA, KANSAS

PREPARED FOR
THE CITY OF WICHITA, KANSAS
455 N. Main
Wichita, KS 67202

LAWRENCE J. SAMPLE
LICENSED
15855
8/13/12
KANSAS
PROFESSIONAL ENGINEER

DESIGNED BY: Larry Sample, PE		DATE: 08-13-2012
DWN BY: RES	CKD BY: LBK	APP BY: L. SAMPLE
FILE NAME: 07_C-2.01.dgn		

AMEC PROJ. NO. 5-6150-0001

LEVEE TOE DRAIN PLAN AND PROFILE

C-2.01

SHEET 7 OF 21