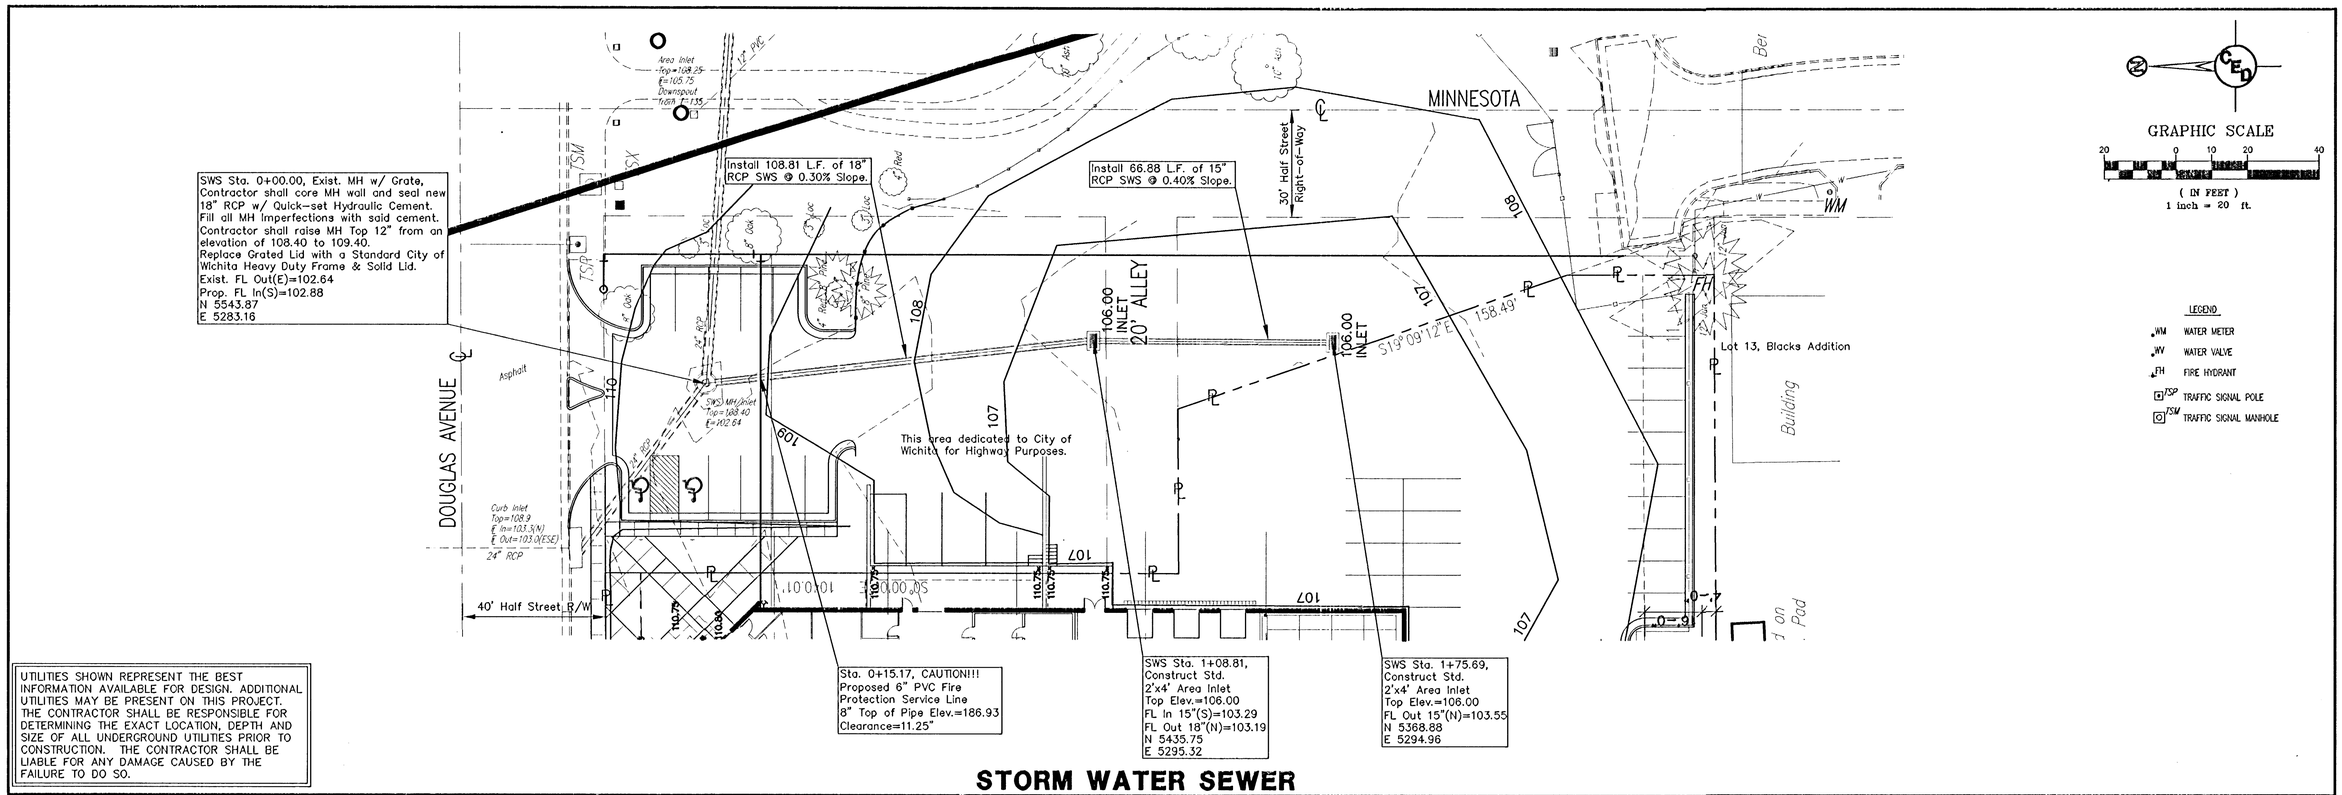

UTILITIES SHOWN REPRESENT THE BEST INFORMATION AVAILABLE FOR DESIGN. ADDITIONAL UTILITIES MAY BE PRESENT ON THIS PROJECT. THE CONTRACTOR SHALL BE RESPONSIBLE FOR DETERMINING THE EXACT LOCATION, DEPTH AND SIZE OF ALL UNDERGROUND UTILITIES PRIOR TO CONSTRUCTION. THE CONTRACTOR SHALL BE LIABLE FOR ANY DAMAGE CAUSED BY THE FAILURE TO DO SO.

STORM WATER SEWER

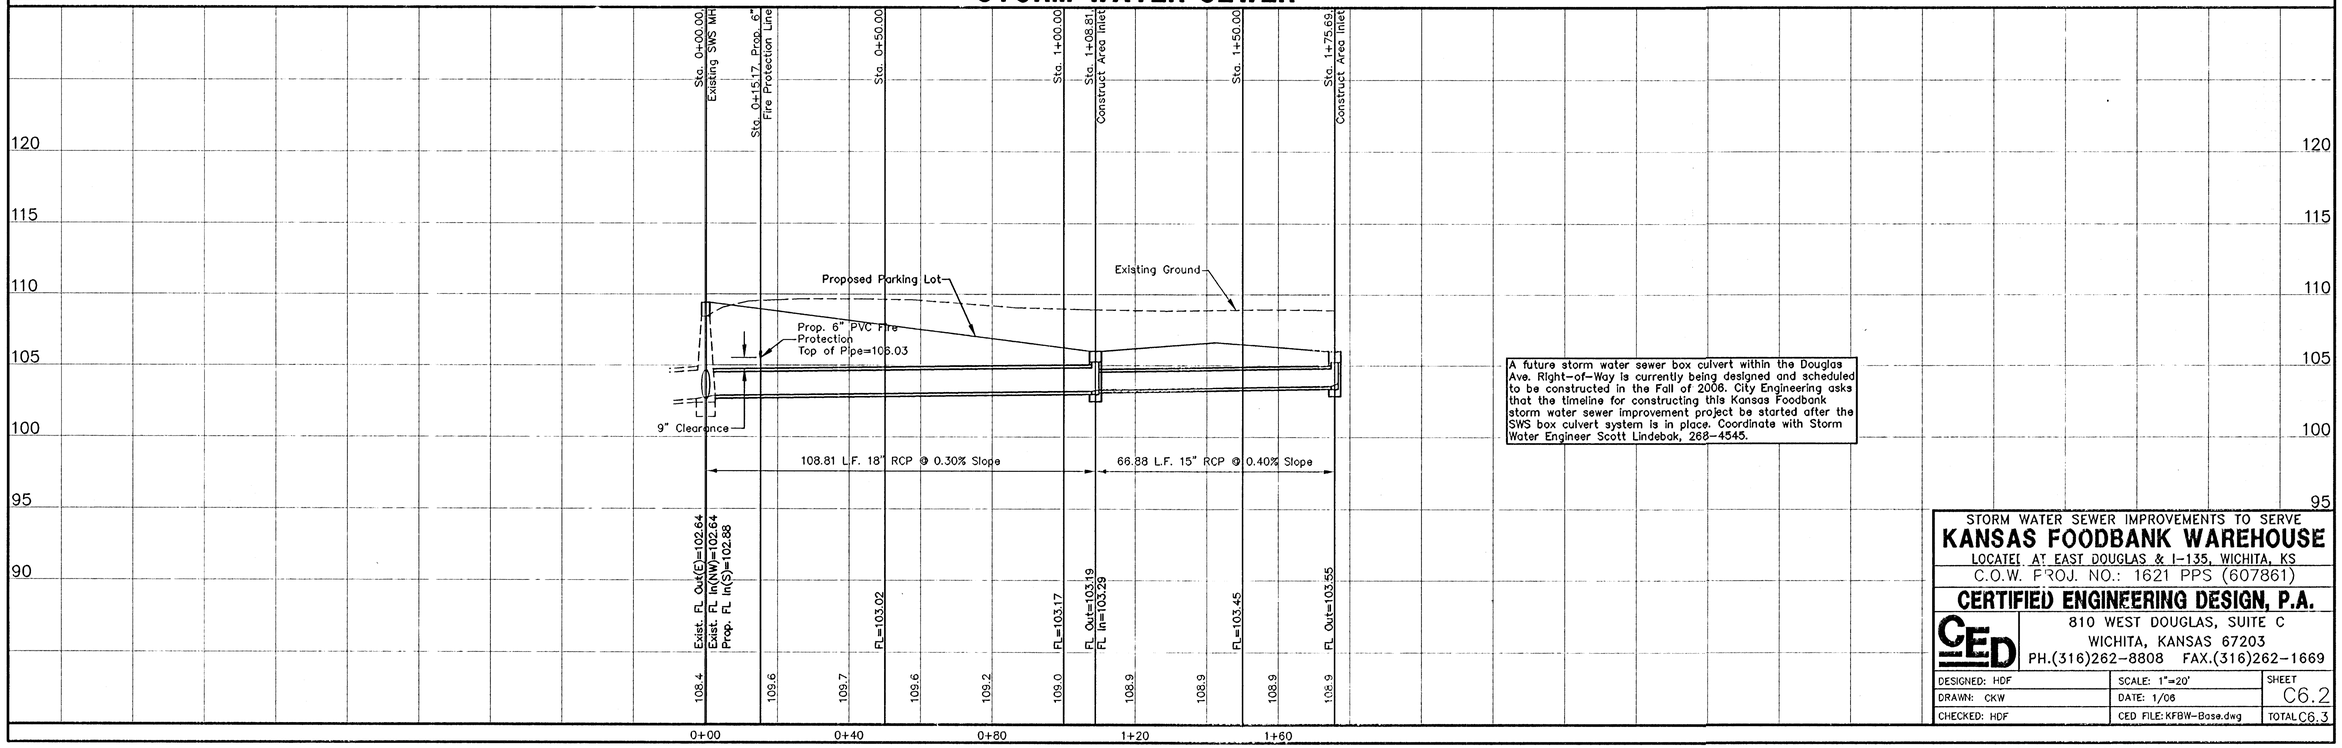

A future storm water sewer box culvert within the Douglas Ave. Right-of-Way is currently being designed and scheduled to be constructed in the Fall of 2006. City Engineering asks that the timeline for constructing this Kansas Foodbank storm water sewer improvement project be started after the SWS box culvert system is in place. Coordinate with Storm Water Engineer Scott Lindebak, 268-4545.

STORM WATER SEWER IMPROVEMENTS TO SERVE

KANSAS FOODBANK WAREHOUSE

LOCATED AT EAST DOUGLAS & I-135, WICHITA, KS

C.O.W. PROJ. NO.: 1621 PPS (607861)

CERTIFIED ENGINEERING DESIGN, P.A.

810 WEST DOUGLAS, SUITE C
WICHITA, KANSAS 67203
PH.(316)262-8808 FAX.(316)262-1669

DESIGNED: HDF	SCALE: 1"=20'	SHEET C6.2
DRAWN: CKW	DATE: 1/06	
CHECKED: HDF	CED FILE: KFBW-Base.dwg	TOTAL C6.3

AS-BUILT 6-13-06 HDF w/CED

SPANGENBERG PHILLIPS ARCHITECTURE
121 N. Mead, Suite 201, Wichita, KS 67202
TEL: 316.267.4002 FAX: 316.2657.1509
www.spangenbergphillips.com

KANSAS FOODBANK WAREHOUSE
STORM WATER SEWER IMPROVEMENTS
DOUGLAS AND I-135 WICHITA KANSAS

PERMIT
00 JAN 06

PLAN & PROFILE

C6.2