


SCALE: 1"=20'

REV. AS BUILT 1-10-07

UNIVERSAL MOTOR FUELS, INC.
 SITE GRADING PLAN
 WICHITA, KANSAS

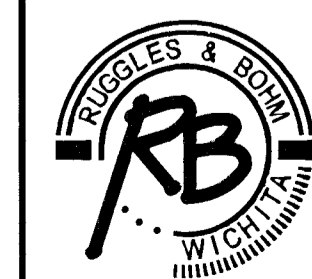

Ruggles & Bohm, P.A.
 Engineering, Surveying, Land Planning
 924 North Main Wichita, Kansas 67203
 www.rbkansas.com (316) 264-8008
 (316) 264-4821 fax E-mail: info@rbkansas.com

DRAWING FILE: Engineering Base [Grading] PROJECT NUMBER: 1641 PPS (607861) DATE: Mar. 8, 2006

DESIGN	TCR	SHEET 2 OF 4
DRAWN	EJB	
REVIEW		
UTILITY		