
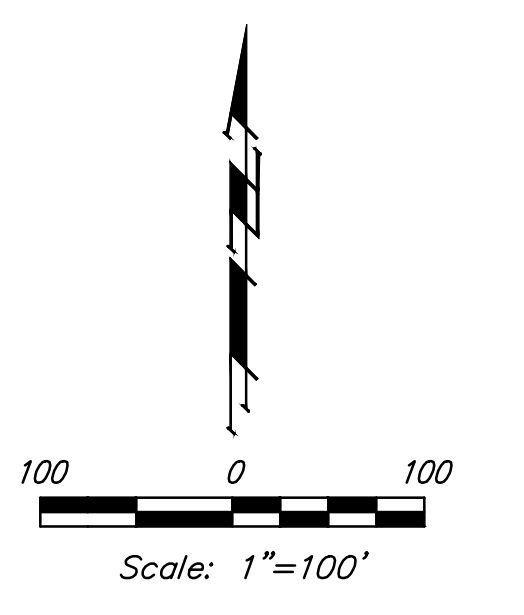


IRONS

Point Table			
Point #	Northing	Easting	Raw Description
1	1660033.06	1628888.69	iron
2	1659949.07	1628889.95	iron
3	1659950.12	1628959.94	iron
4	1659971.18	1629030.64	iron
5	1659972.05	1629088.63	iron
6	1659749.80	1629033.95	iron
7	1659750.67	1629091.94	iron
8	1659976.27	1629370.60	iron
9	1659977.14	1629428.59	iron
10	1659756.34	1629373.89	iron
11	1659757.21	1629431.88	iron
12	1659980.00	1629619.76	iron
13	1660043.99	1629618.80	iron
14	1659999.95	1629681.91	iron
15	1660044.22	1629719.39	iron
16	1660034.87	1629730.43	iron
17	1659990.61	1629692.95	iron
18	1659952.45	1629710.99	iron
19	1659953.31	1629768.99	iron
20	1659763.74	1629771.82	iron
21	1659762.87	1629713.83	iron
22	1660092.70	1629666.08	iron
23	1660093.66	1629730.07	iron
24	1660164.69	1629665.00	iron
25	1660806.62	1629655.39	iron
26	1660807.58	1629719.39	iron
27	1660677.59	1629721.33	iron
28	1660613.60	1629722.29	iron
29	1660616.48	1629914.27	iron
30	1660680.02	1629913.98	iron
31	1660550.46	1630047.27	iron
32	1660549.50	1629983.28	iron
33	1660117.53	1629989.75	iron
34	1660118.49	1630053.74	iron
35	1660047.44	1630070.68	iron
36	1660019.41	1630013.15	iron
37	1659948.36	1630030.09	iron
38	1659949.32	1630094.08	iron
39	1659757.21	1630096.96	iron
40	1659756.25	1630032.97	iron
41	1659653.59	1630104.24	iron
42	1659713.21	1630127.51	iron
43	1659611.10	1630198.60	iron
44	1659609.87	1630134.61	iron
45	1659529.99	1630136.32	iron
46	1659531.21	1630200.31	iron
47	1659515.83	1629396.54	iron
48	1659506.26	1628896.58	iron
49	1660153.05	1628886.90	iron
50	1660814.66	1630192.52	iron
51	1660606.36	1630253.39	iron
52	1660115.68	1630408.50	iron
53	1659668.80	1630560.92	iron
54	1659538.99	1630606.82	iron

WATER DISTRIBUTION SYSTEM

Point Table			
Point #	Northing	Easting	Raw Description
6000	1659955.77	1628869.85	0+00
6001	1659956.66	1628929.45	0+59.60
6002	1659978.16	1629029.68	1+62.12
6003	1659978.27	1629036.53	1+68.97
6004	1659979.12	1629093.52	2+25.97
6005	1659983.36	1629376.49	5+08.97
6006	1659984.21	1629433.49	5+65.97
6007	1659987.23	1629635.14	7+67.64
6008	1660004.64	1629675.46	8+11.56
6009	1660011.48	1629682.09	8+21.09
6010	1660041.00	1629710.75	8+62.23
6011	1660050.57	1629714.54	8+72.53
6012	1660072.85	1629723.38	8+96.50
6013	1660180.05	1629721.78	10+03.71
6014	1660205.04	1629721.41	10+28.71
6015	1659968.27	1629036.68	0+10
6016	1659742.35	1629040.06	2+35.95
6017	1659725.37	1629023.59	2+59.60
6018	1659692.46	1629024.08	2+92.51
6019	1659669.54	1629047.70	3+25.43
6020	1659670.03	1629080.60	3+58.34
6021	1659693.65	1629103.52	3+91.25
6022	1659736.65	1629102.88	4+34.25
6023	1659973.36	1629376.64	0+10
6024	1659748.89	1629380.00	2+34.50
6025	1659731.91	1629363.53	2+58.15
6026	1659699.00	1629364.02	2+91.06
6027	1659676.08	1629387.64	3+23.97
6028	1659676.58	1629420.54	3+56.88
6029	1659700.19	1629443.47	3+89.80
6030	1659743.19	1629442.82	4+32.80
6031	1659977.98	1629716.61	0+48.10
6032	1659755.41	1629719.94	2+70.69
6033	1659738.44	1629703.47	2+94.35
6034	1659705.53	1629703.96	3+27.26
6035	1659682.61	1629727.58	3+60.17
6036	1659683.10	1629760.48	3+93.08
6037	1659706.72	1629783.41	4+25.99
6038	1659749.72	1629782.76	4+68.99

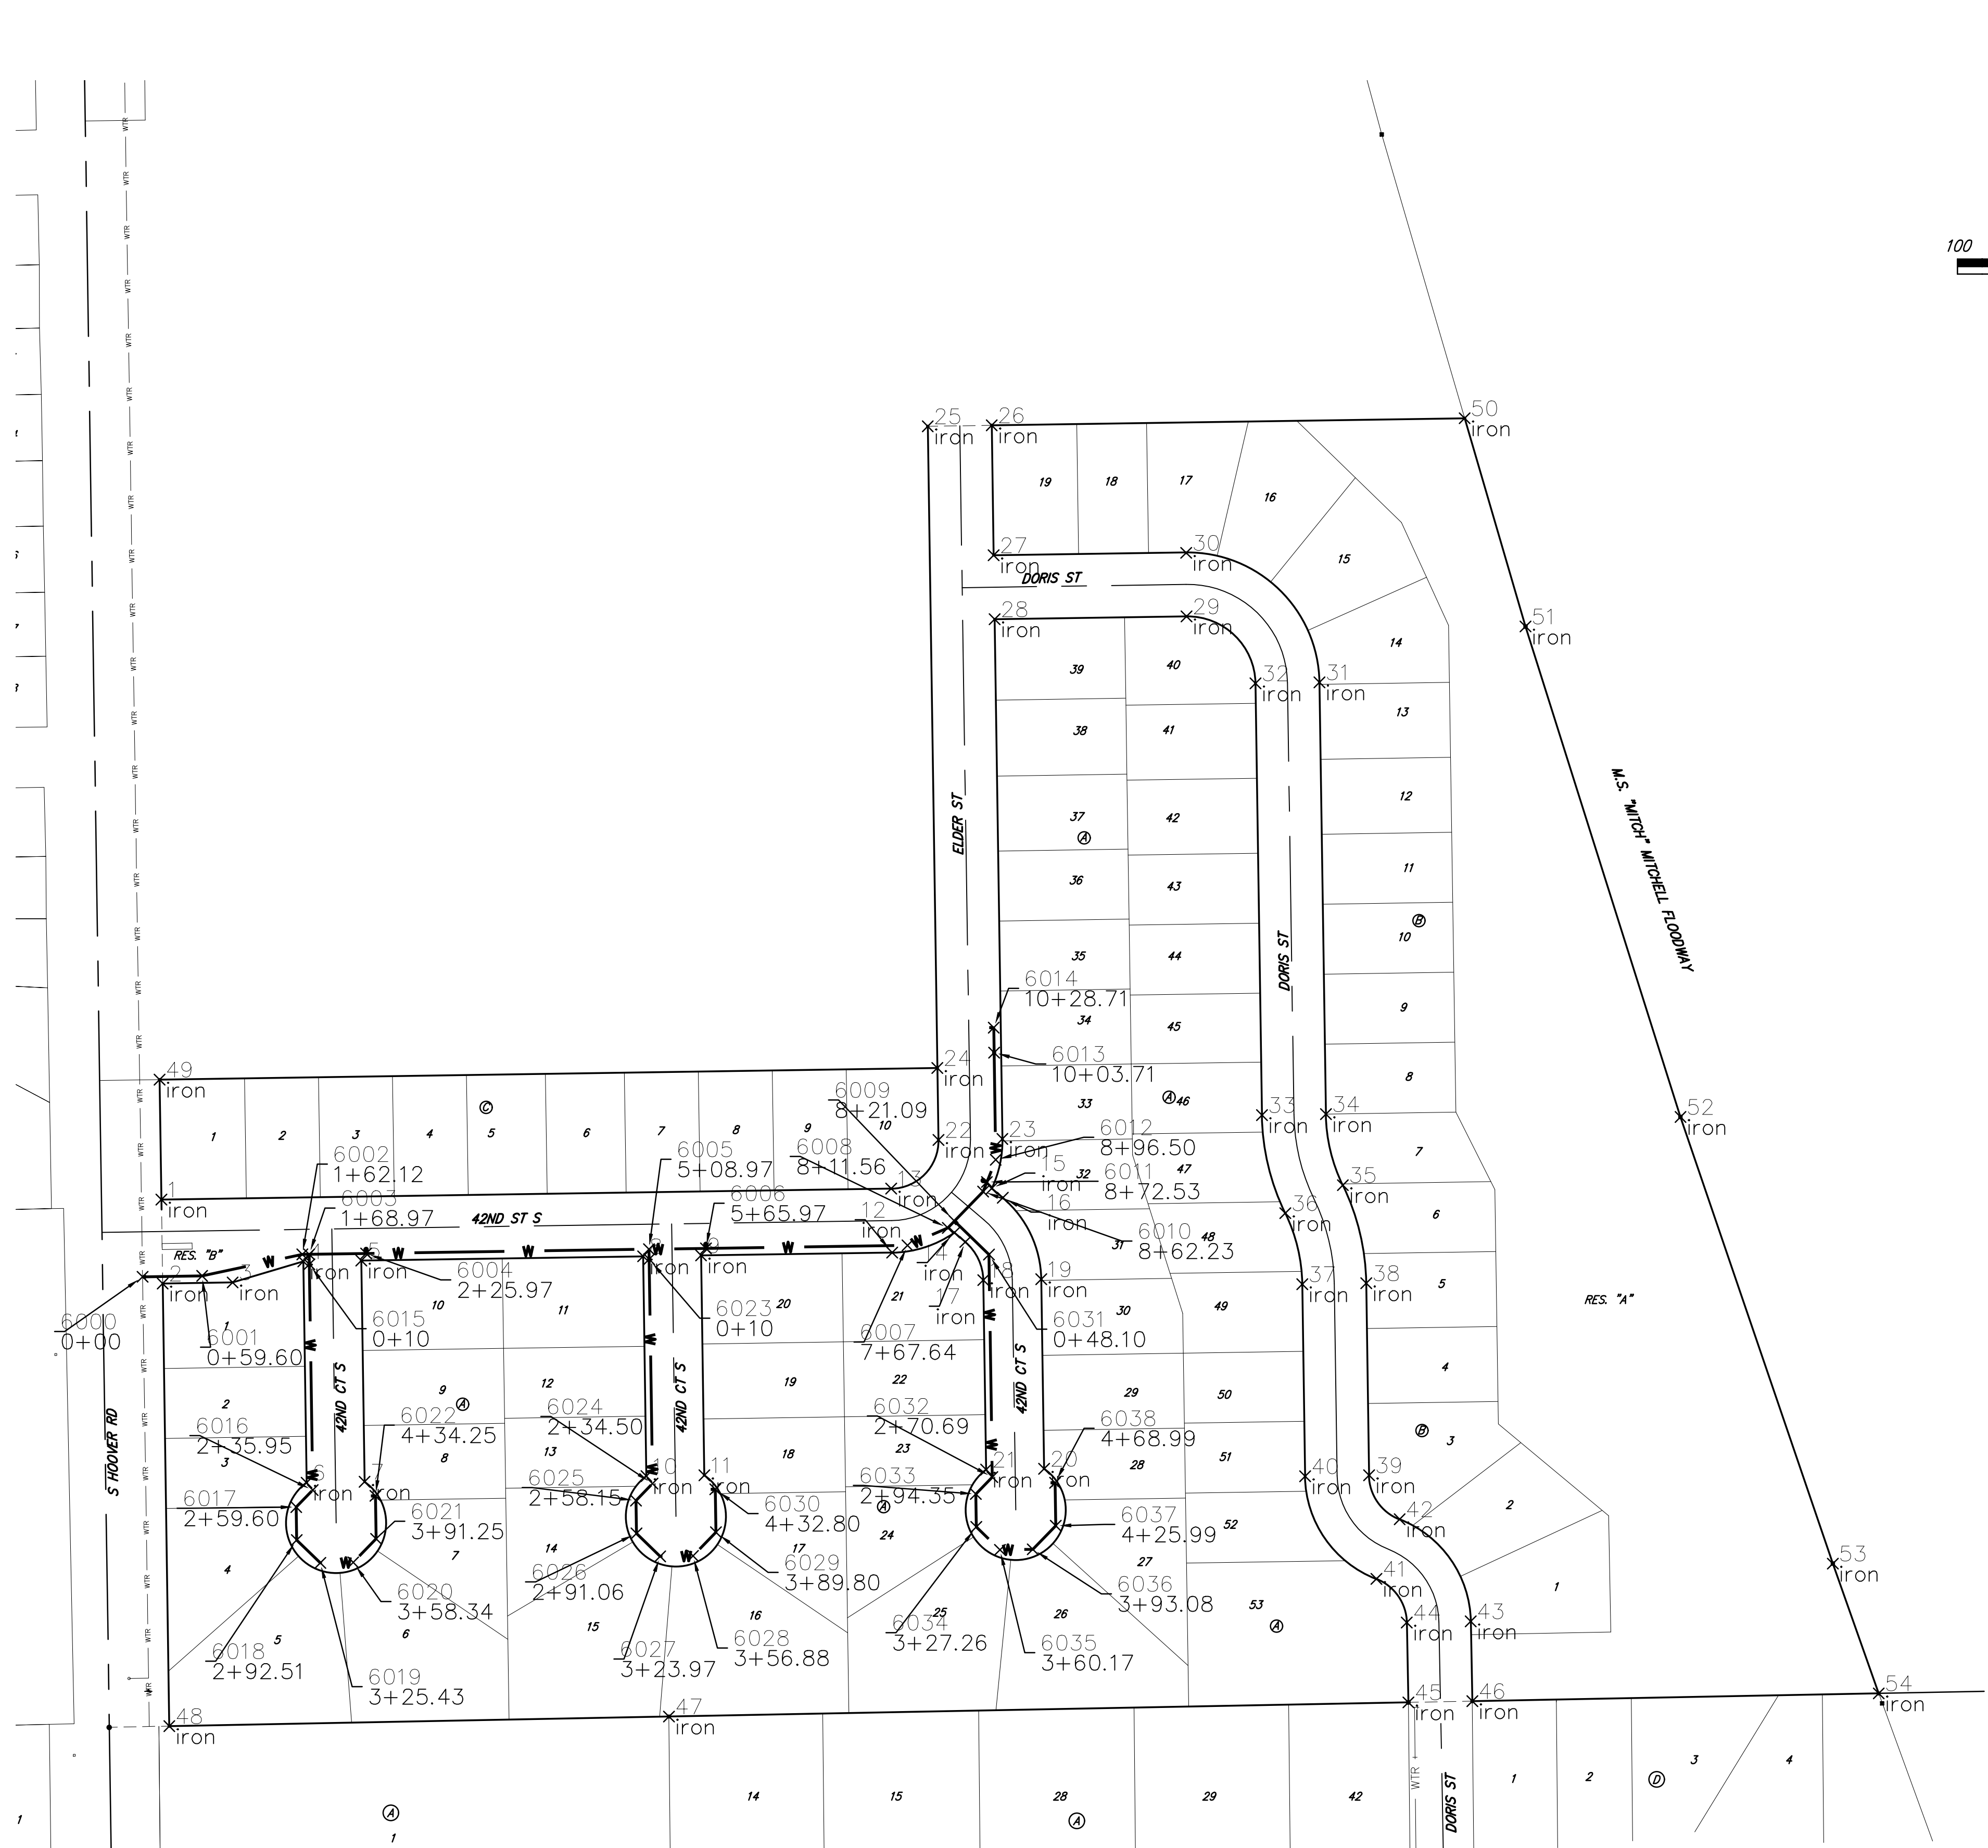





**BAUGHMAN  
COMPANY**

315 Ellis St.  
Wichita, KS 67211  
316-262-7271  
BaughmanCo.com

COLT MEADOWS ADD.  
Phase 1

**COORDINATE  
SHEET**

WATER DISTRIBUTION  
SYSTEM

PROJECT NUMBER:  
22-04-E165

DESIGN: NBW DRAWN: TMS  
DATE: April 14, 2022

SHEET **15** OF **16**

File: E:\Projects\Colt Meadows Addition\_21-01-P622\Engineering\Phase 1\Water\_22-04-E165\Water.dwg