

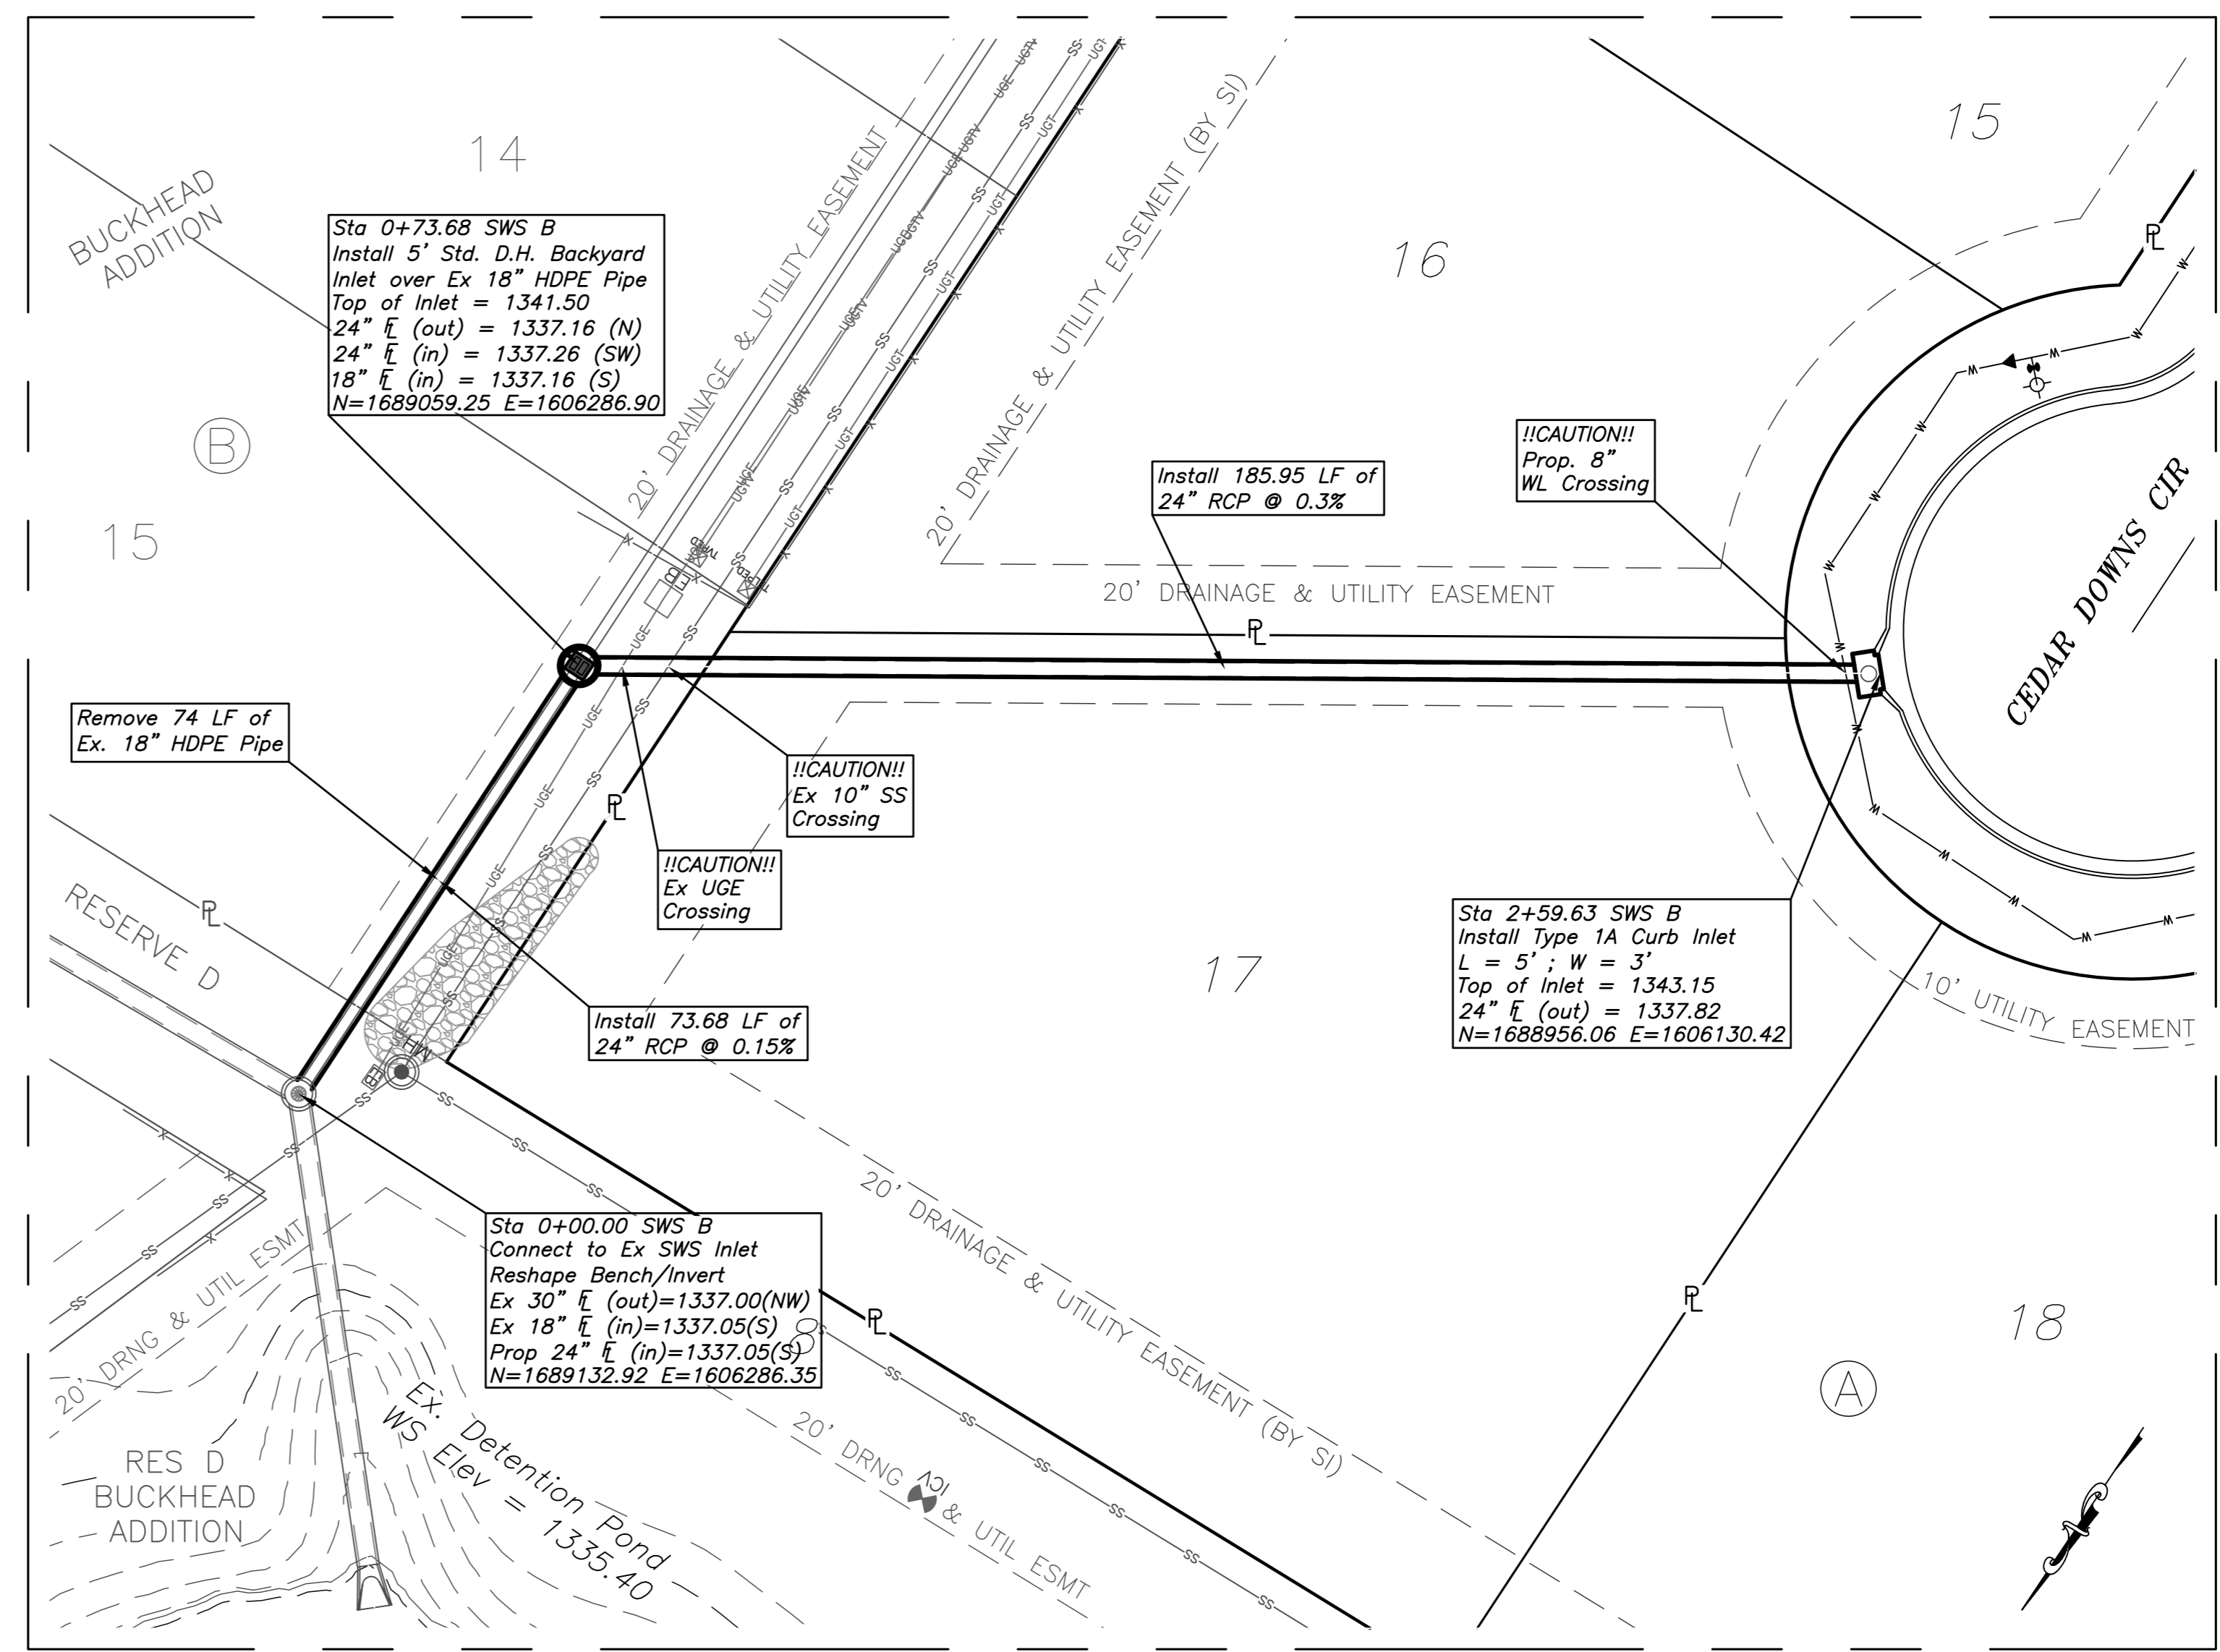
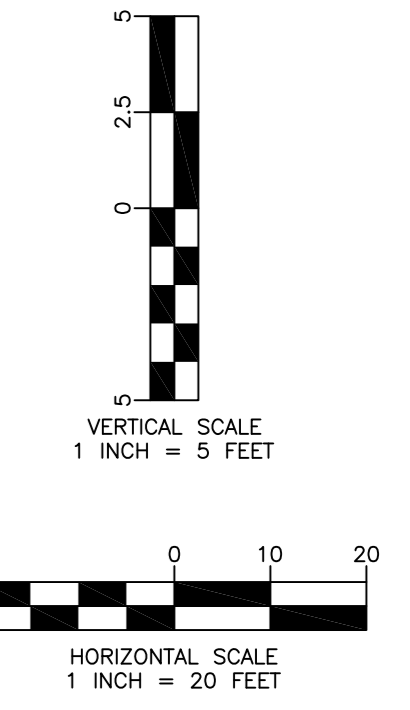
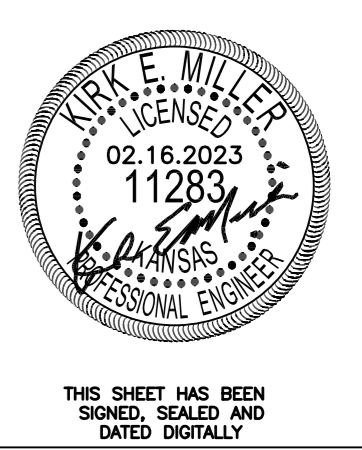


LINE A

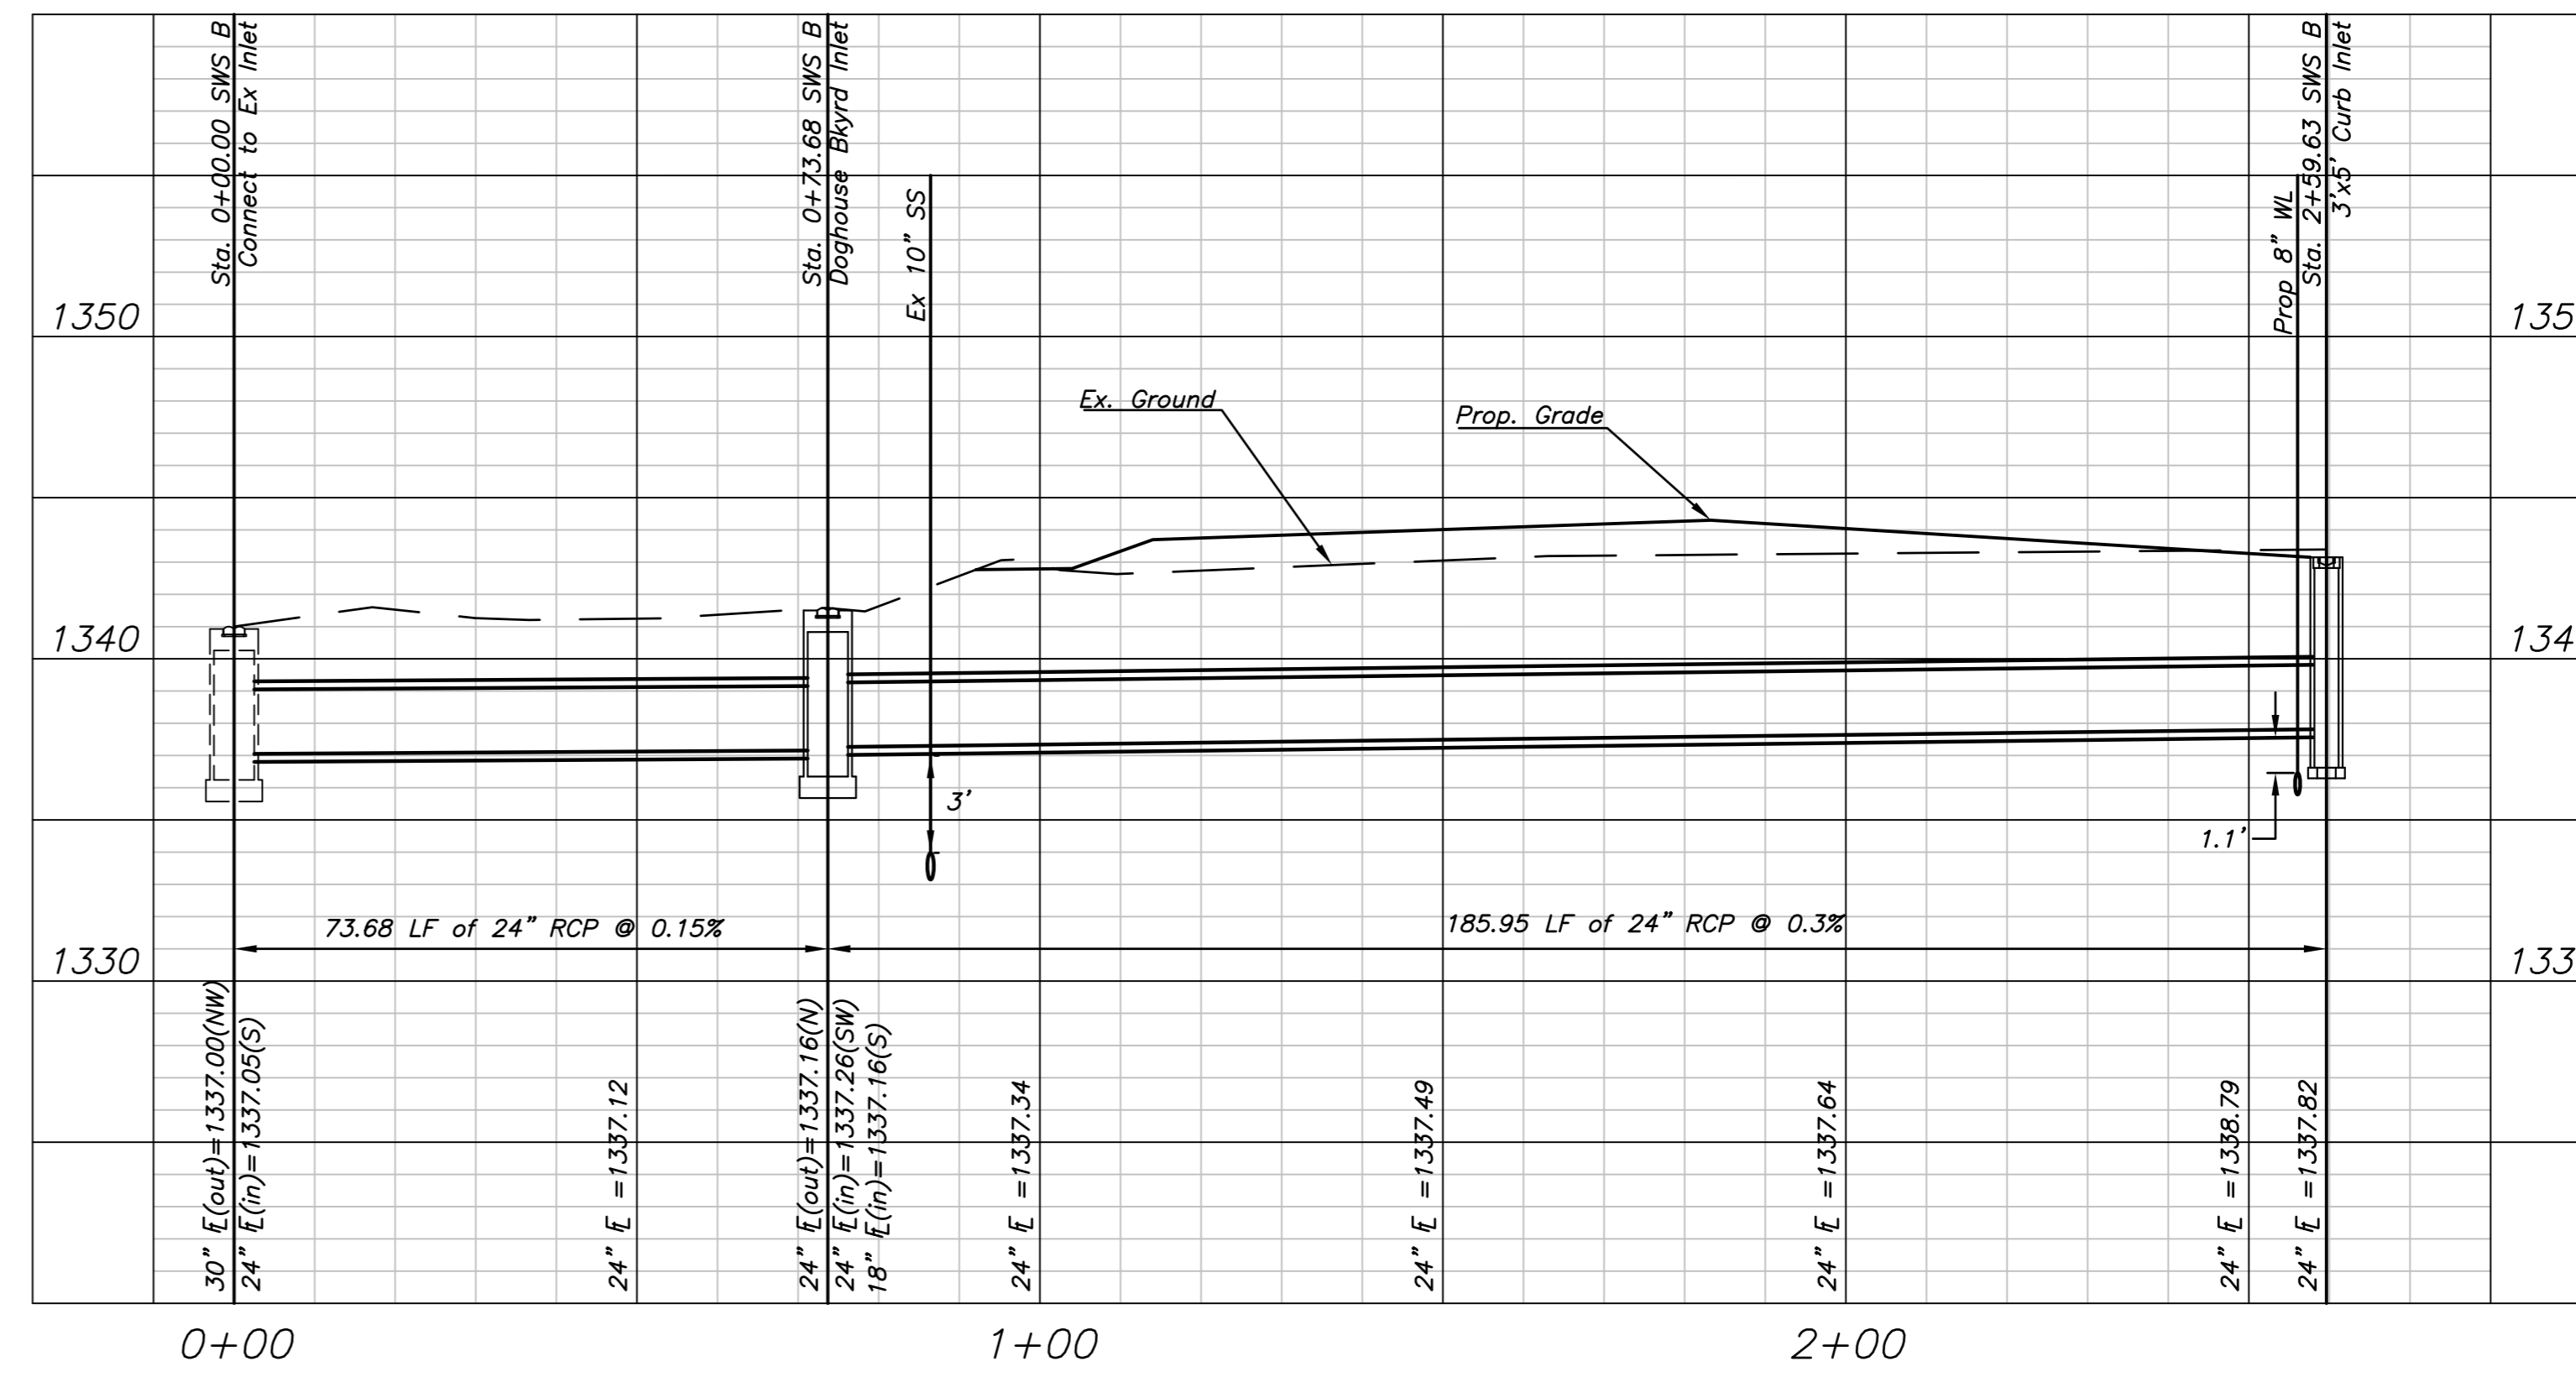

LINE B

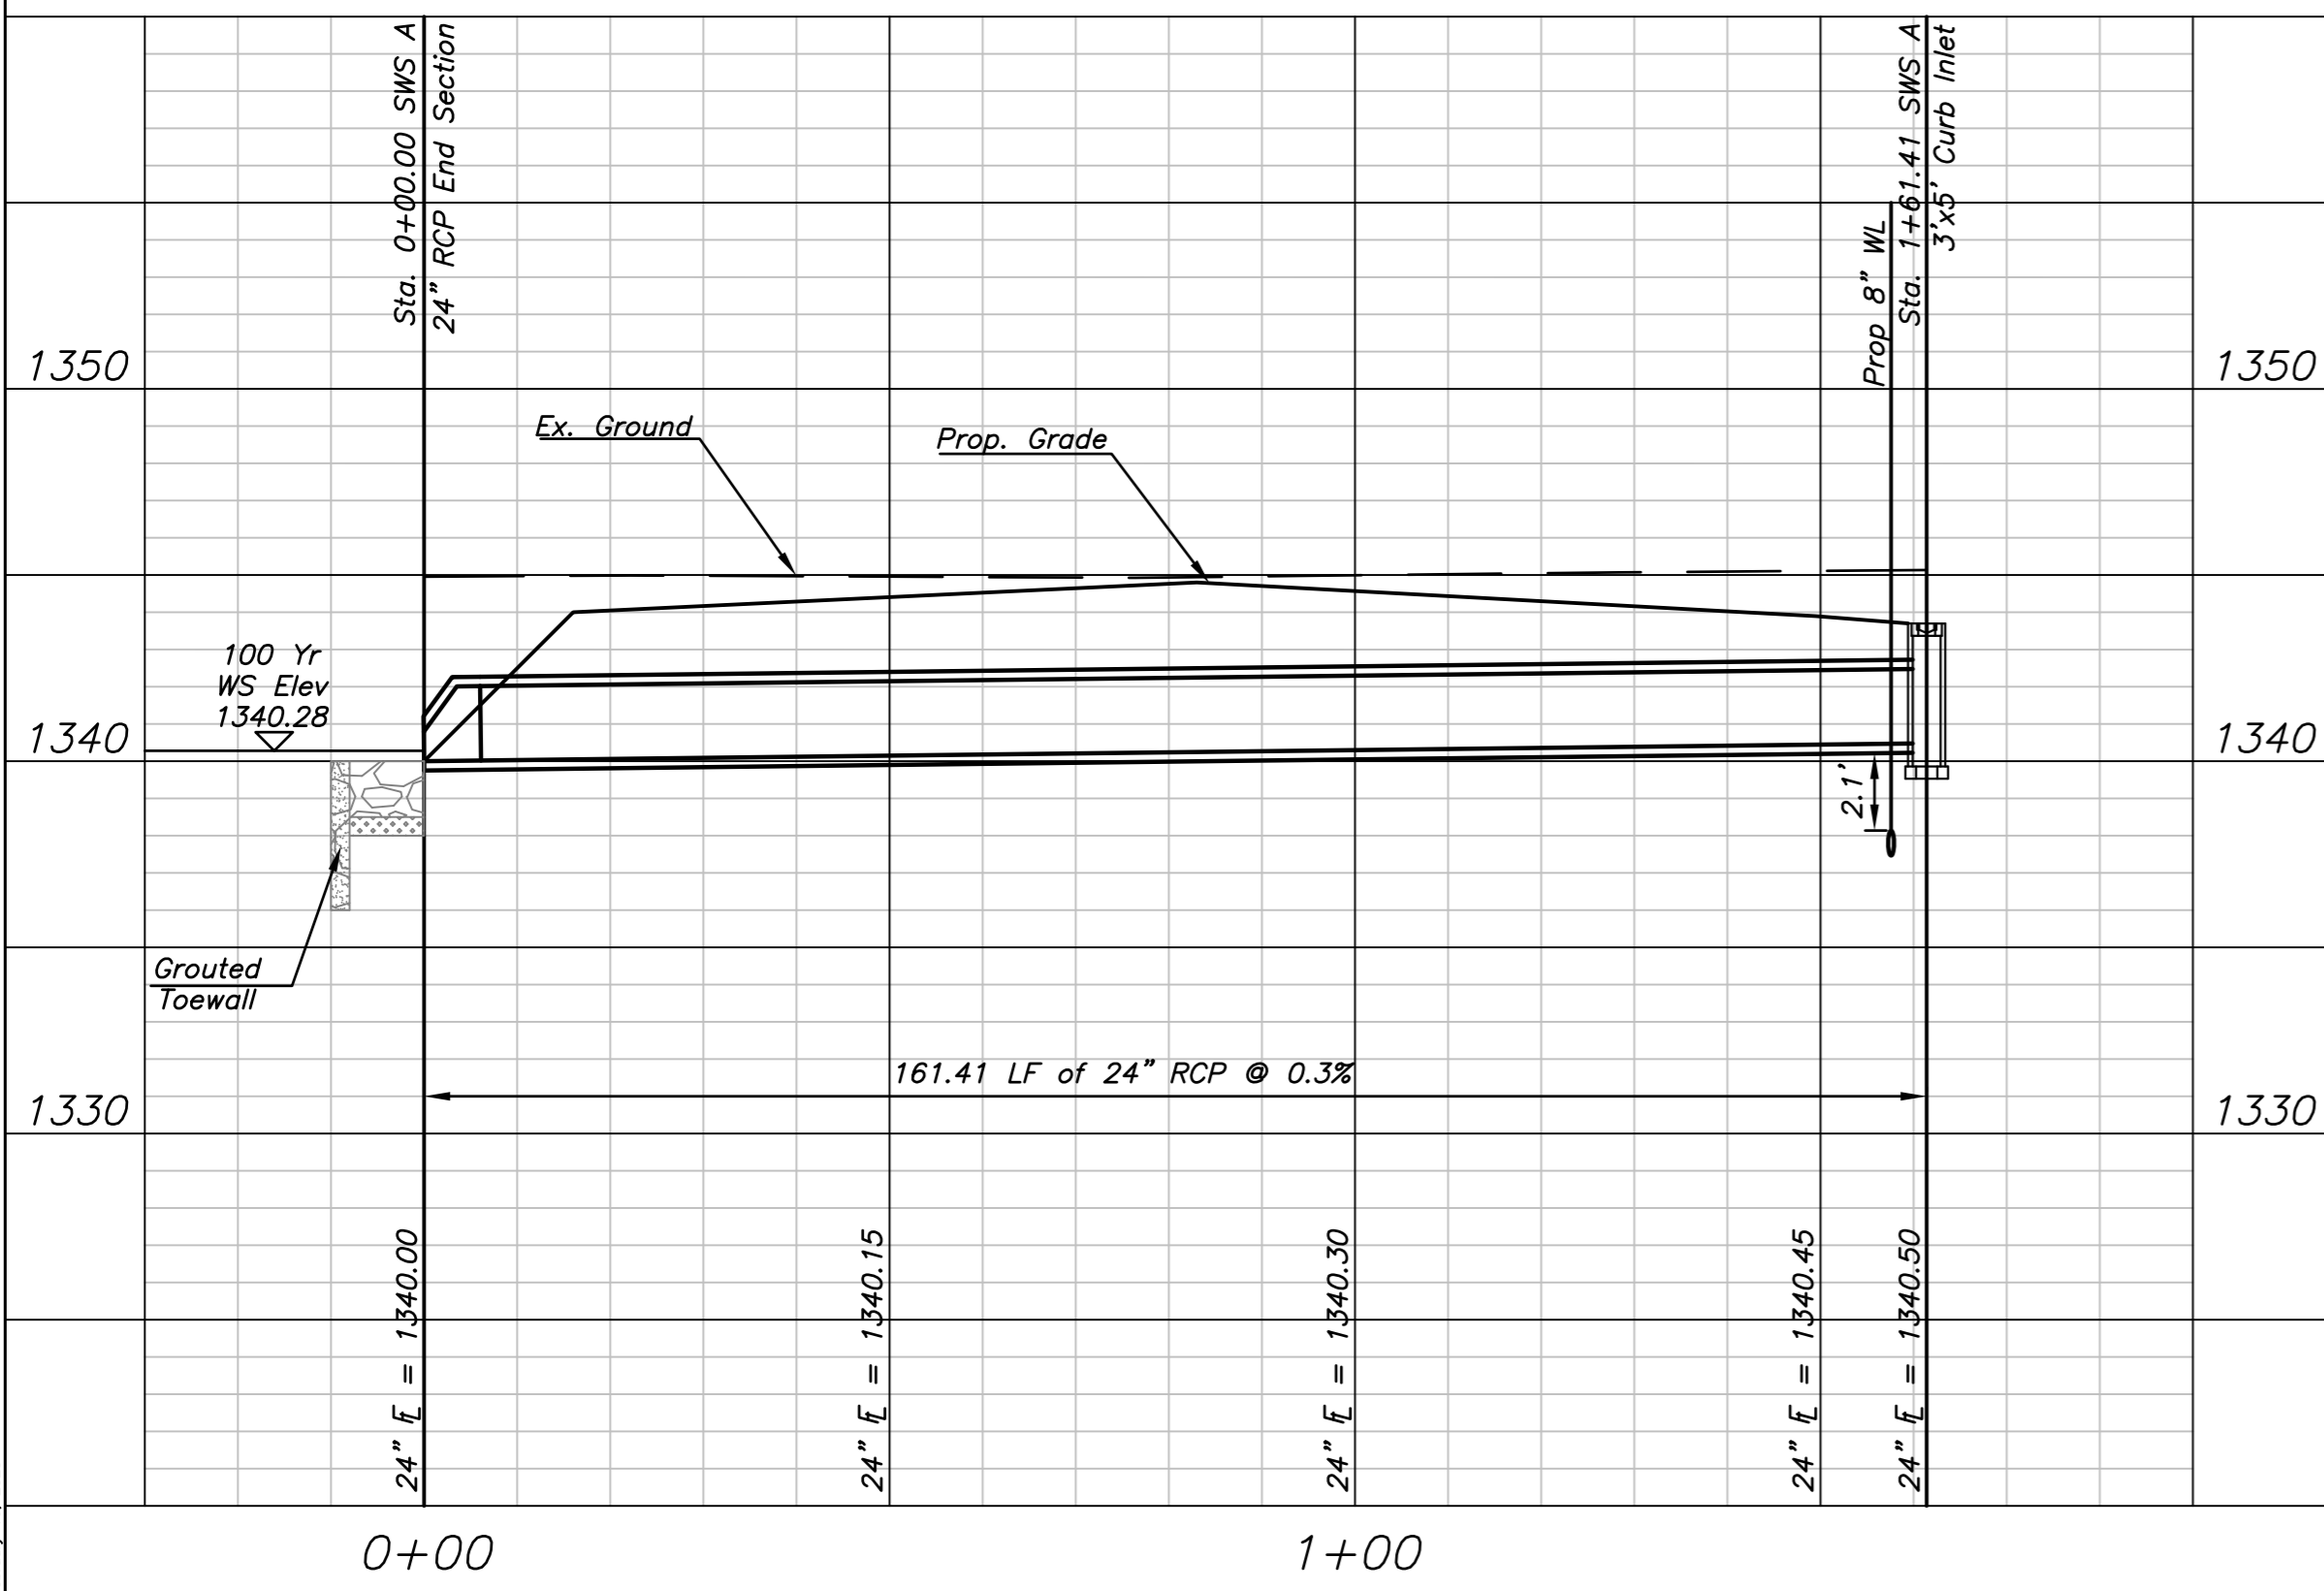

REVISED
Cedar Dale Addition
SWS Plan & Profile
Wichita, Kansas

KEMILLER ENGINEERING
117 E. Lewis, Wichita, KS 67202 (316)284-0242

KEM PROJ. 20130	DATE 02.2023	SHEET 3.0
DESIGN KEM	DRAWN ZJS	

February 16, 2023