BENCHMARKS:
BM-1#:
SQUARE CUT ON TOP OF CURB 119.3'± N. & 6.4'± W. OF SE. COR., LOT 7, BLOCK 2, TURTLE RUN 3RD ADDITION.
ELEV. = 1390.32 NAVD88

BM-2#:
SQUARE CUT ON TOP OF CURB 118.4'± N. OF SE. COR., LOT 6, BLOCK 2, TURTLE RUN 2ND ADDITION.
ELEV. = 1391.04 NAVD88

TOWNE PARC 10TH ADDITION

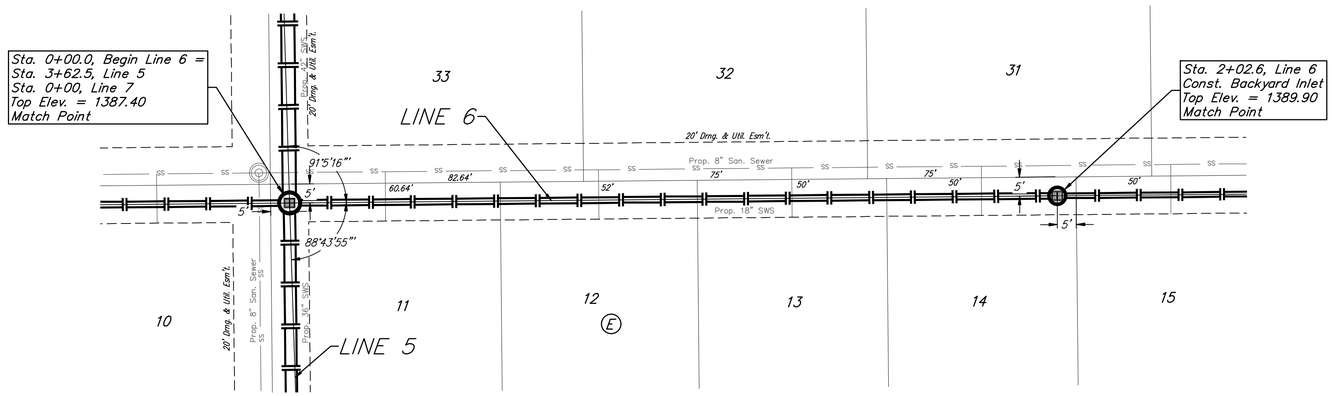

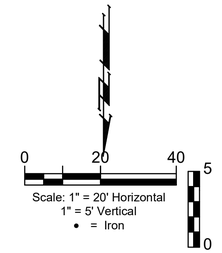

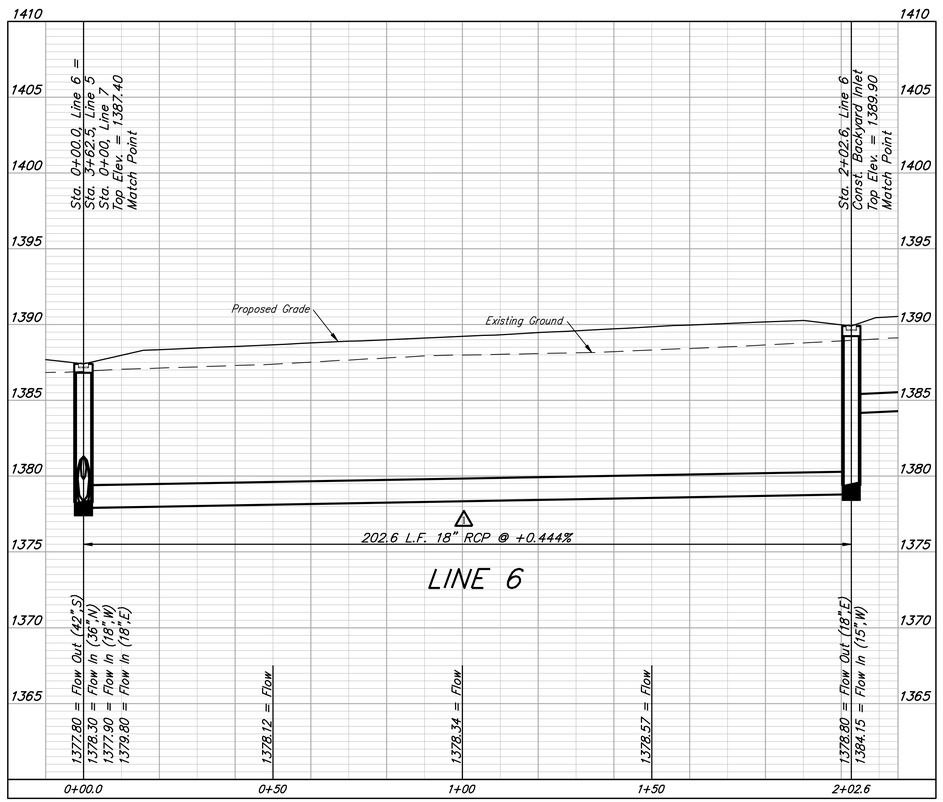

BRENT WOOTEN
LICENSED
8470
06/23/2023
KANSAS
PROFESSIONAL ENGINEER

BAUGHMAN COMPANY

315 Ellis St.
Wichita, KS 67211
316-262-7271
BaughmanCo.com

TOWNE PARC 10TH ADDITION

LINE 6

STORM WATER DRAIN IMPROVEMENTS

PROJECT NUMBER:
468-2023-085536

DESIGN: NBW DRAWN: JLD

DATE: June 22, 2023

SHEET 11R OF 37

△ Adjusted Pipe to Clear Proposed Sanitary Sewer Services.

File: E:\Projects\Towne Parc 10th Addition_22-01-P743\Engineering\PHASE 1\SWD_22-11-E352\SWS-SWD.dwg