

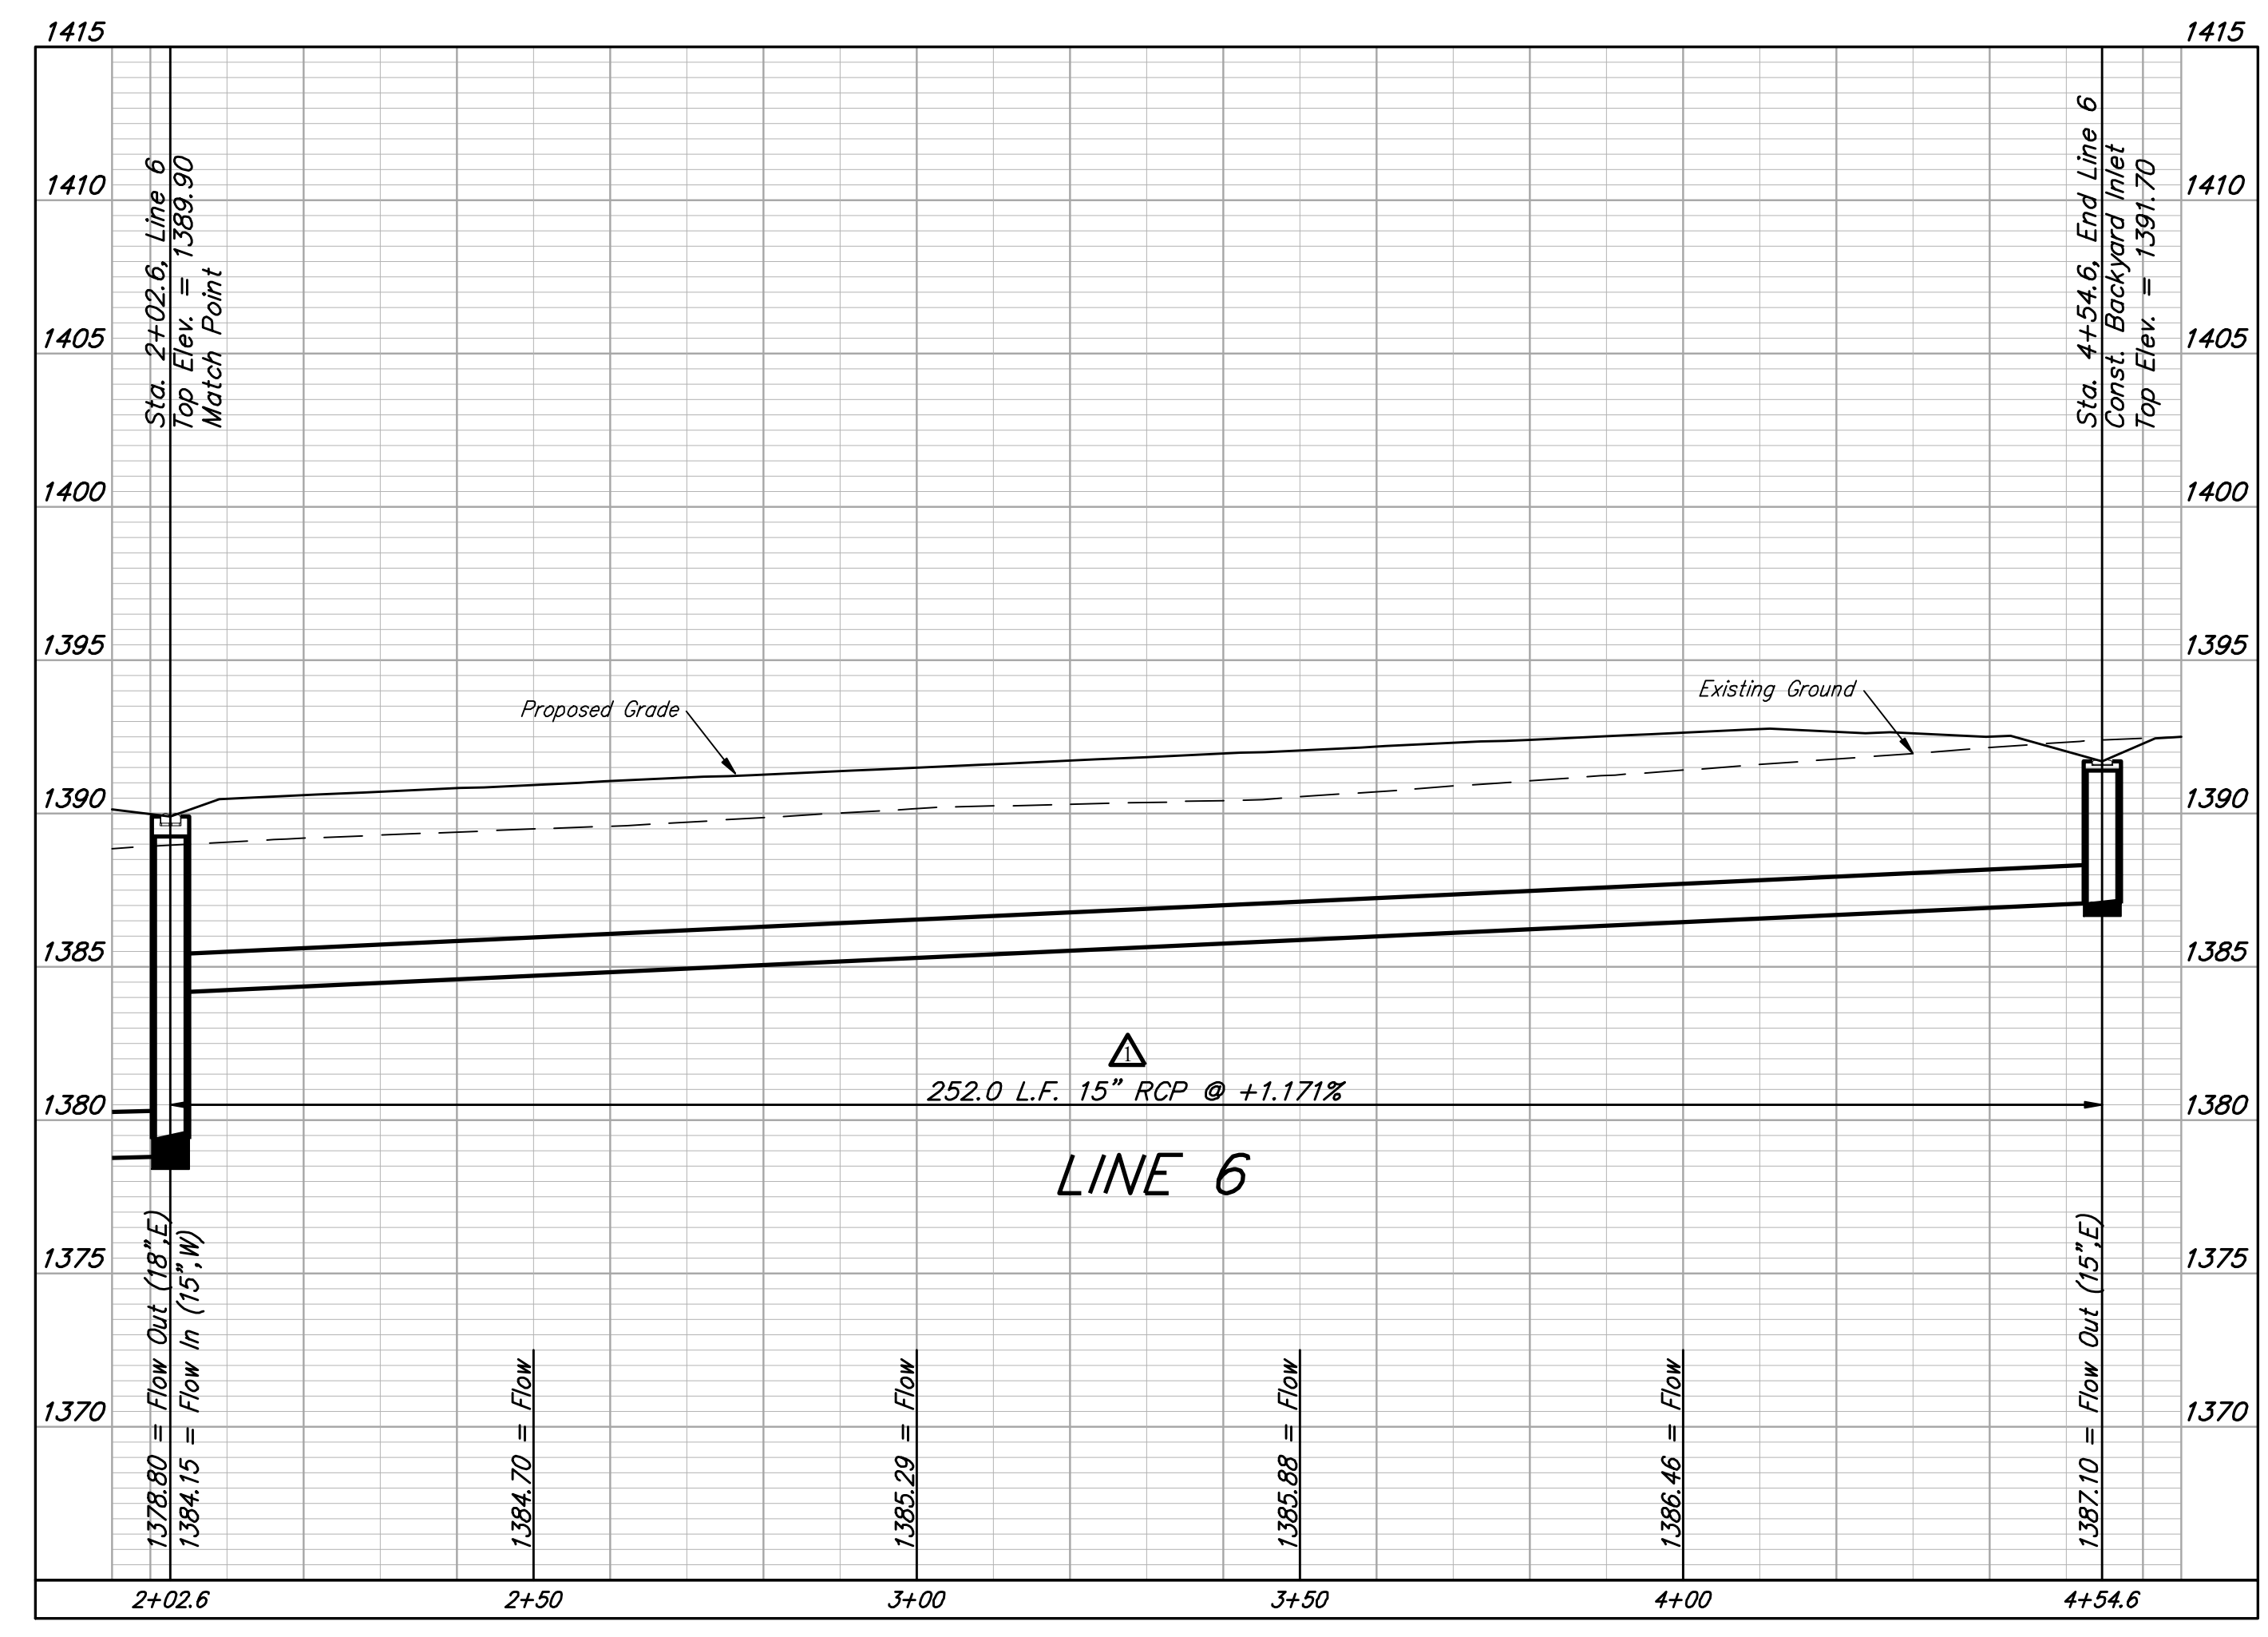


BENCHMARKS:
BM-1#:
 SQUARE CUT ON TOP OF CURB 119.3± N.
 ± 6.4± W. OF SE. COR., LOT 7, BLOCK 2,
 TURTLE RUN 3RD ADDITION.
 ELEV. = 1390.32 NAVD88

BM-2#:
 SQUARE CUT ON TOP OF CURB 118.4± N.
 OF SE. COR., LOT 6, BLOCK 2, TURTLE
 RUN 2ND ADDITION.
 ELEV. = 1391.04 NAVD88

TOWNE PARC 10TH ADDITION

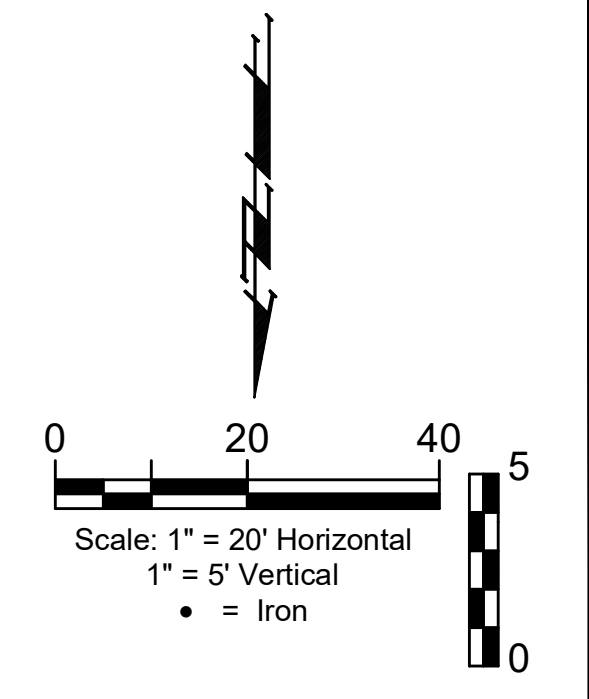

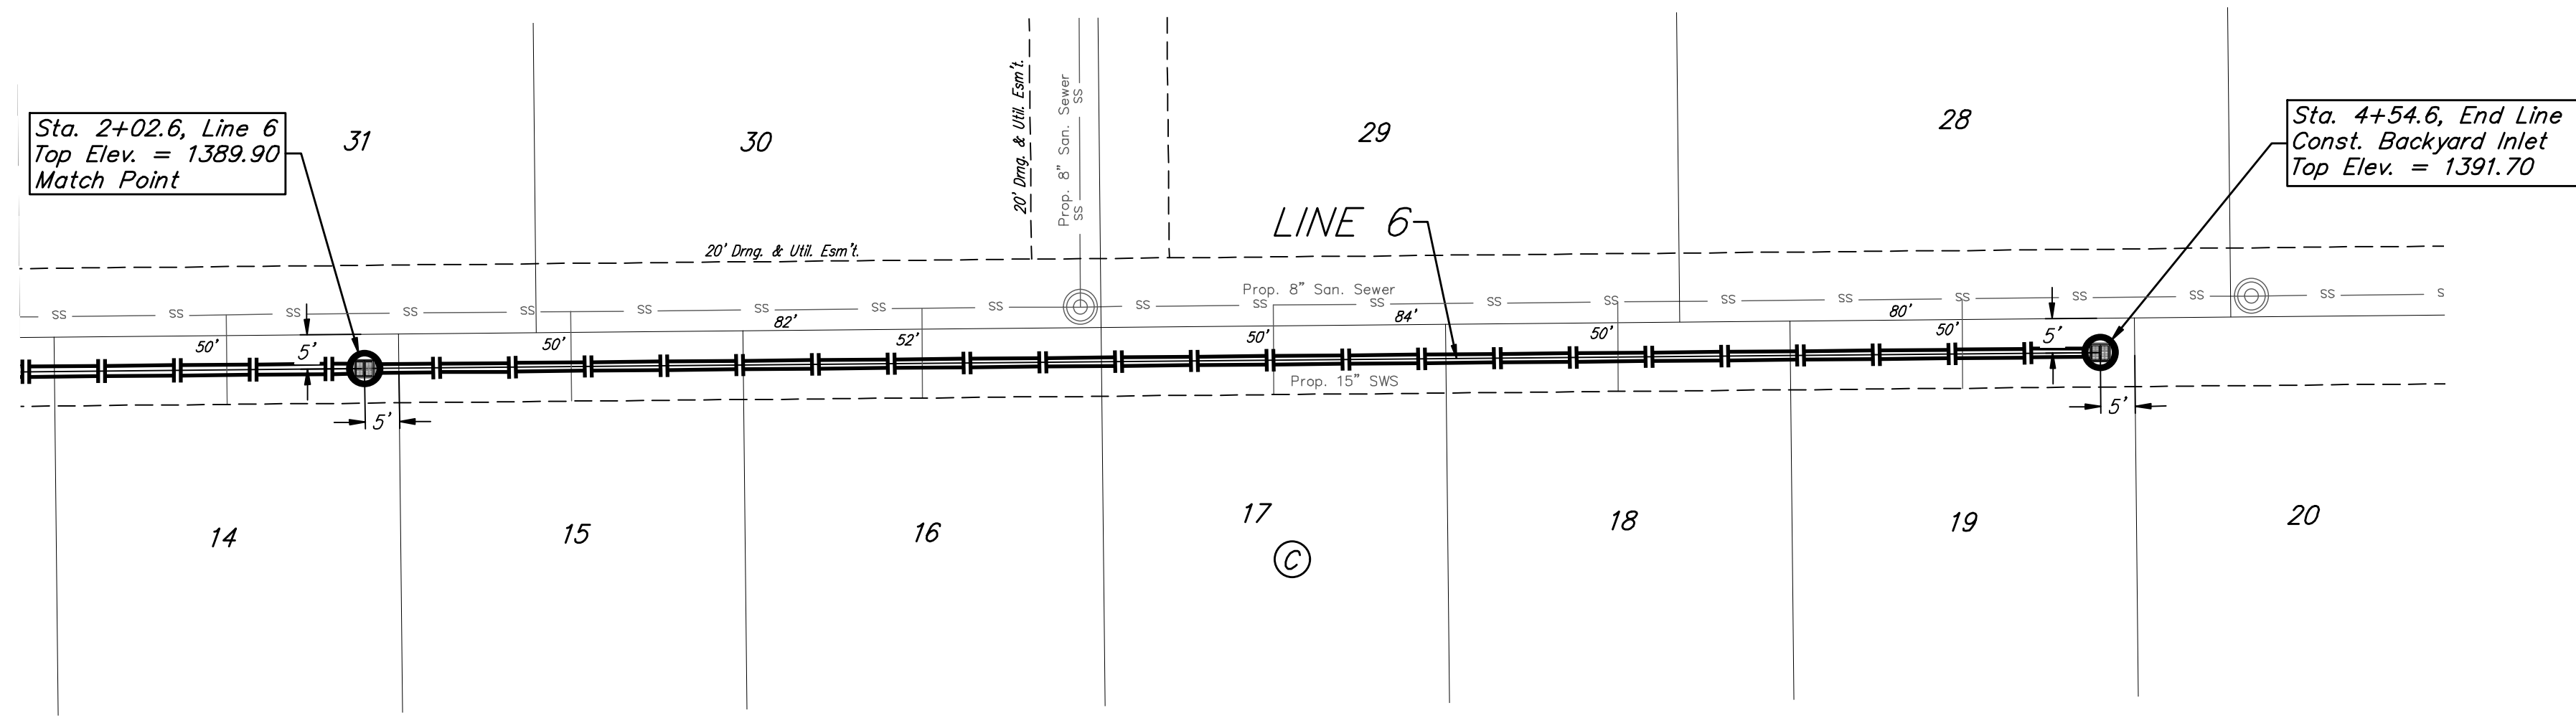

BAUGHMAN COMPANY
 315 Ellis St.
 Wichita, KS 67211
 316-262-7271
 BaughmanCo.com

TOWNE PARC 10TH ADDITION

LINE 6

STORM WATER DRAIN IMPROVEMENTS

PROJECT NUMBER: 468-2023-085536
 DESIGN: NBW DRAWN: JLD
 DATE: June 22, 2023

SHEET OF
12R 37

Adjusted Pipe to Clear Proposed Sanitary Sewer Services.

File: E:\Projects\Towne Parc 10th Addition_22-01-P743\Engineering\PHASE 1\SWD_22-11-E352\SWS-SWD.dwg