
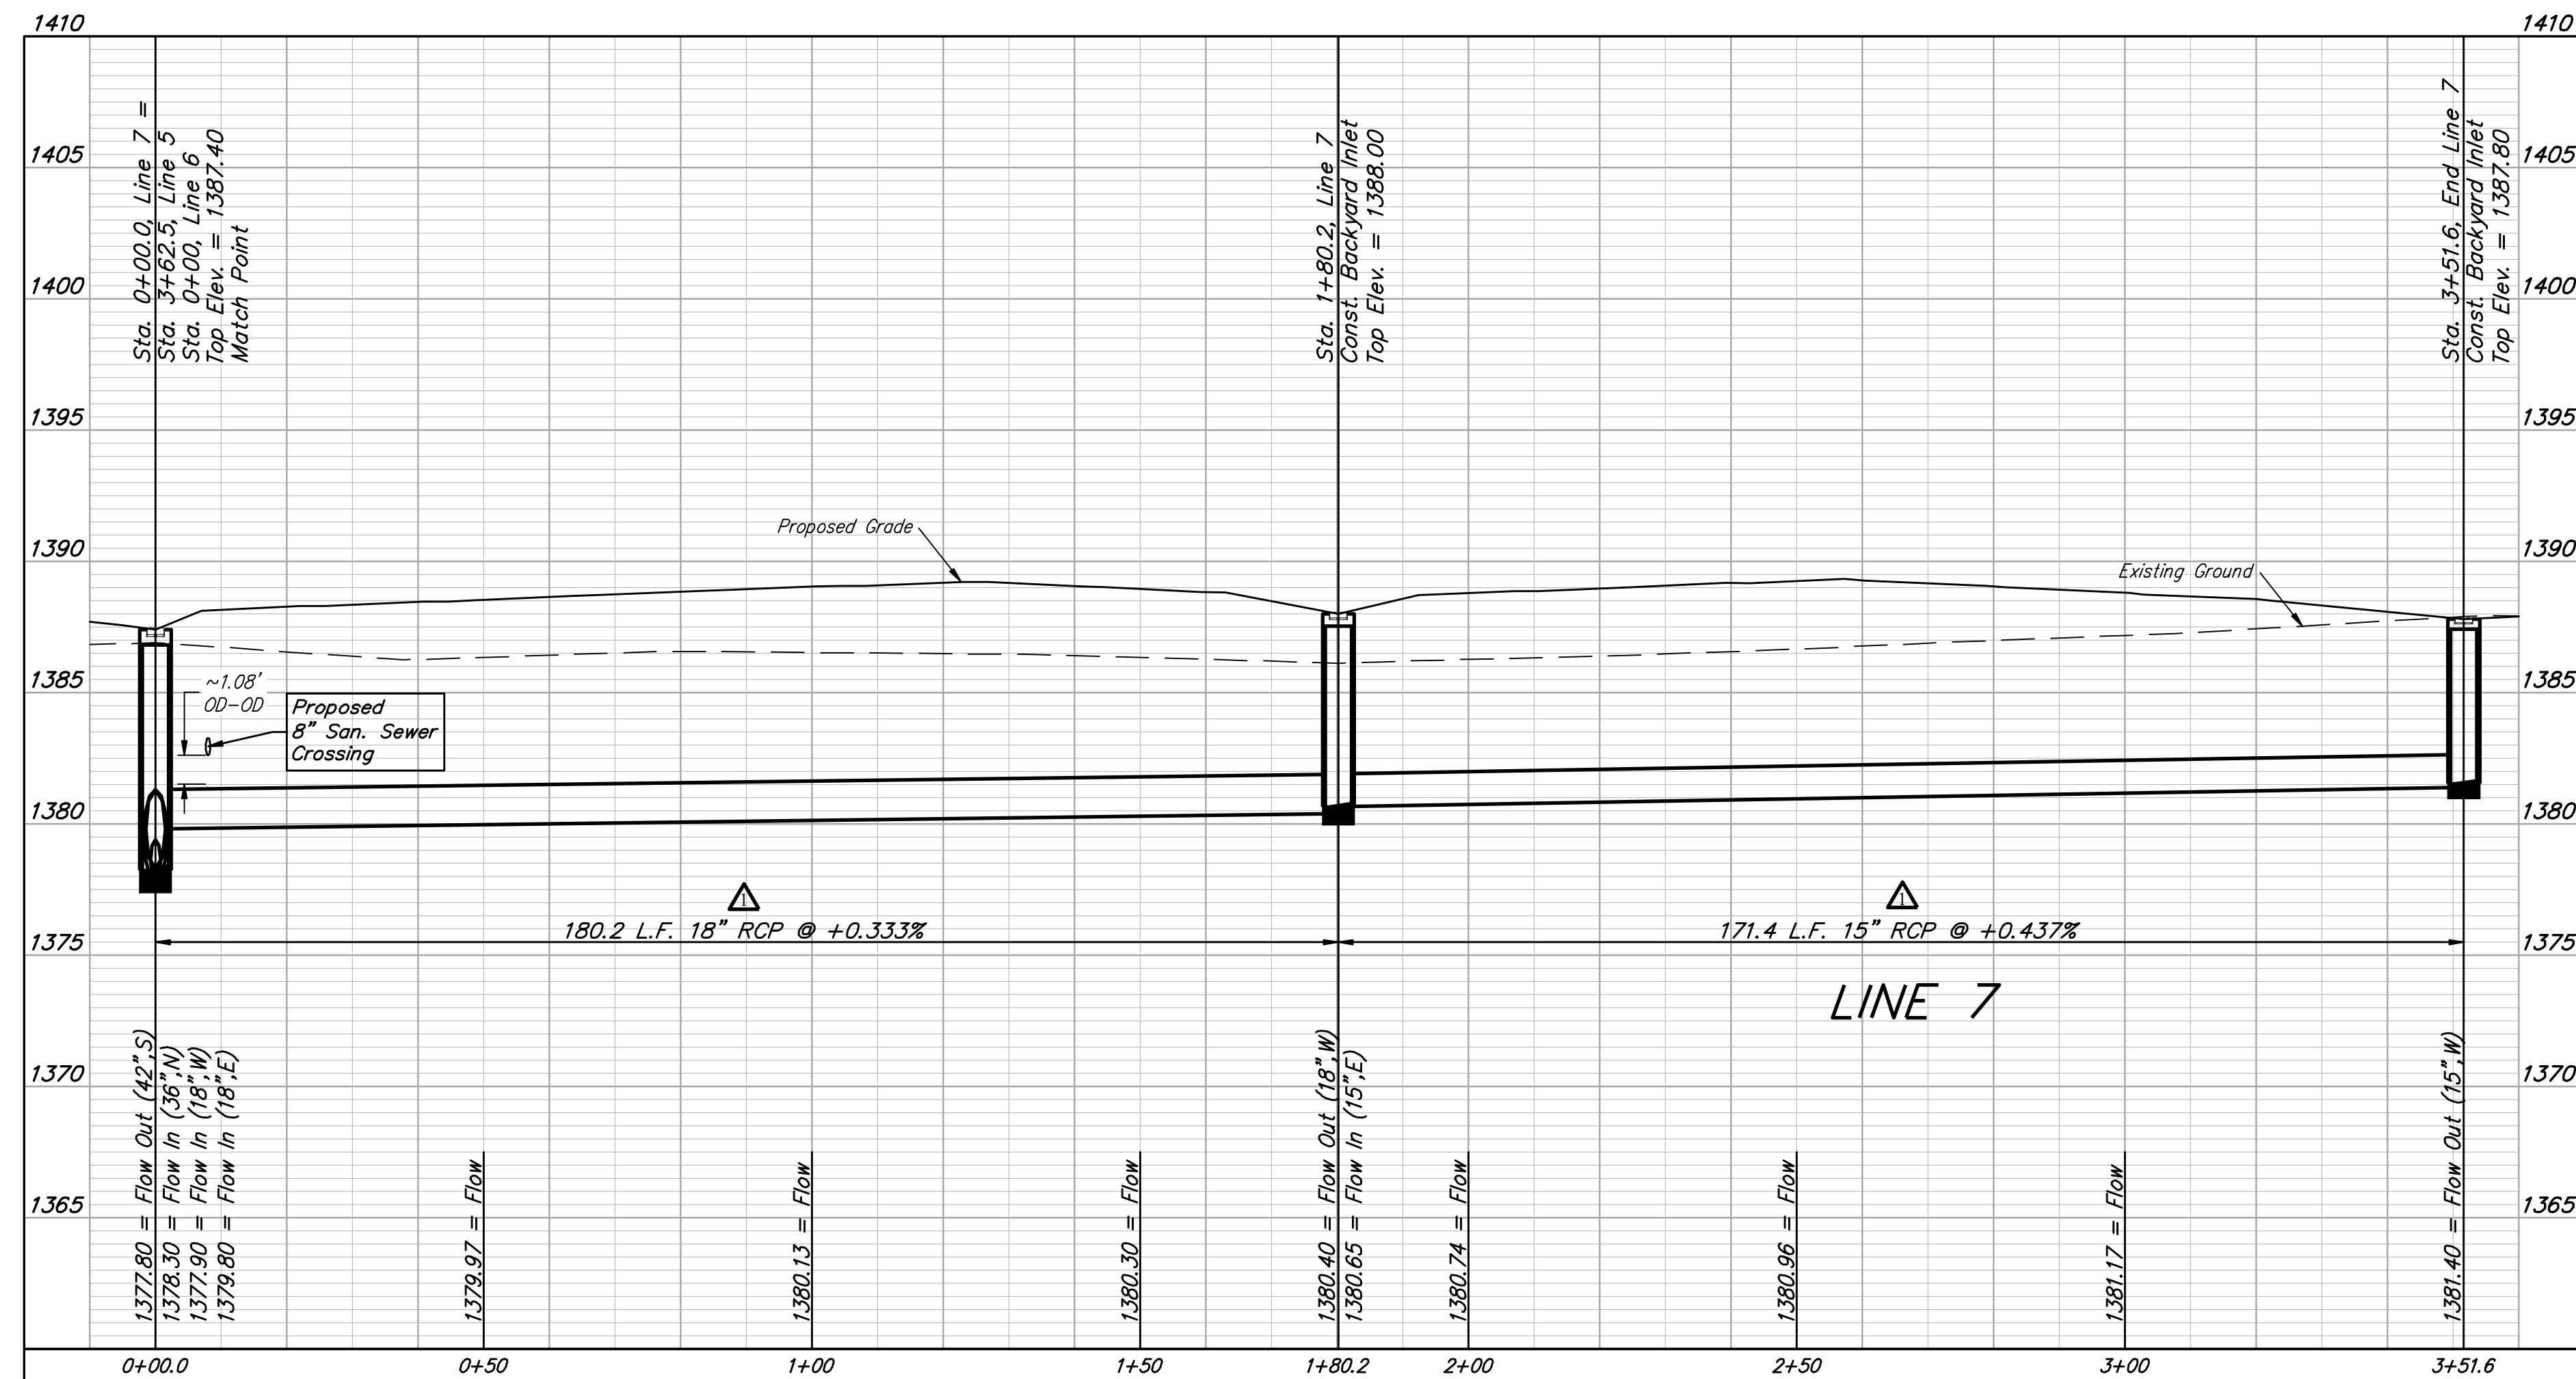
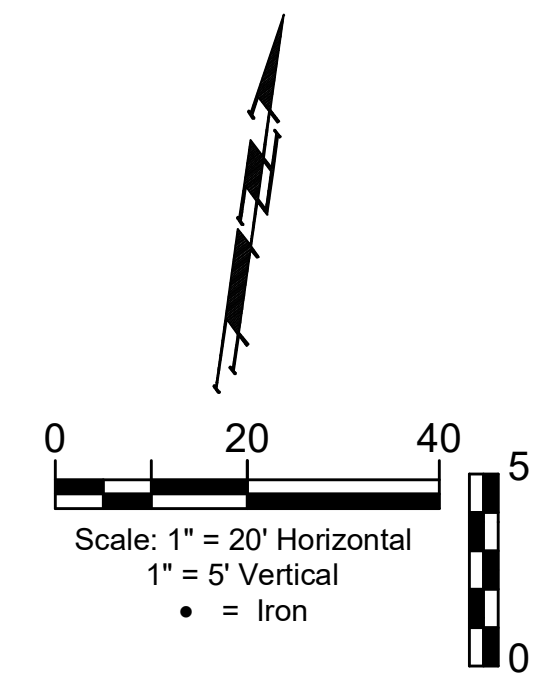


**BENCHMARKS:**  
**BM-1#:**  
 SQUARE CUT ON TOP OF CURB 119.3± N.  
 ± 6.4± W. OF SE. COR., LOT 7, BLOCK 2,  
 TURTLE RUN 3RD ADDITION.  
 ELEV. = 1390.32 NAVD88  
**BM-2#:**  
 SQUARE CUT ON TOP OF CURB 118.4± N.  
 OF SE. COR., LOT 6, BLOCK 2, TURTLE  
 RUN 2ND ADDITION.  
 ELEV. = 1391.04 NAVD88

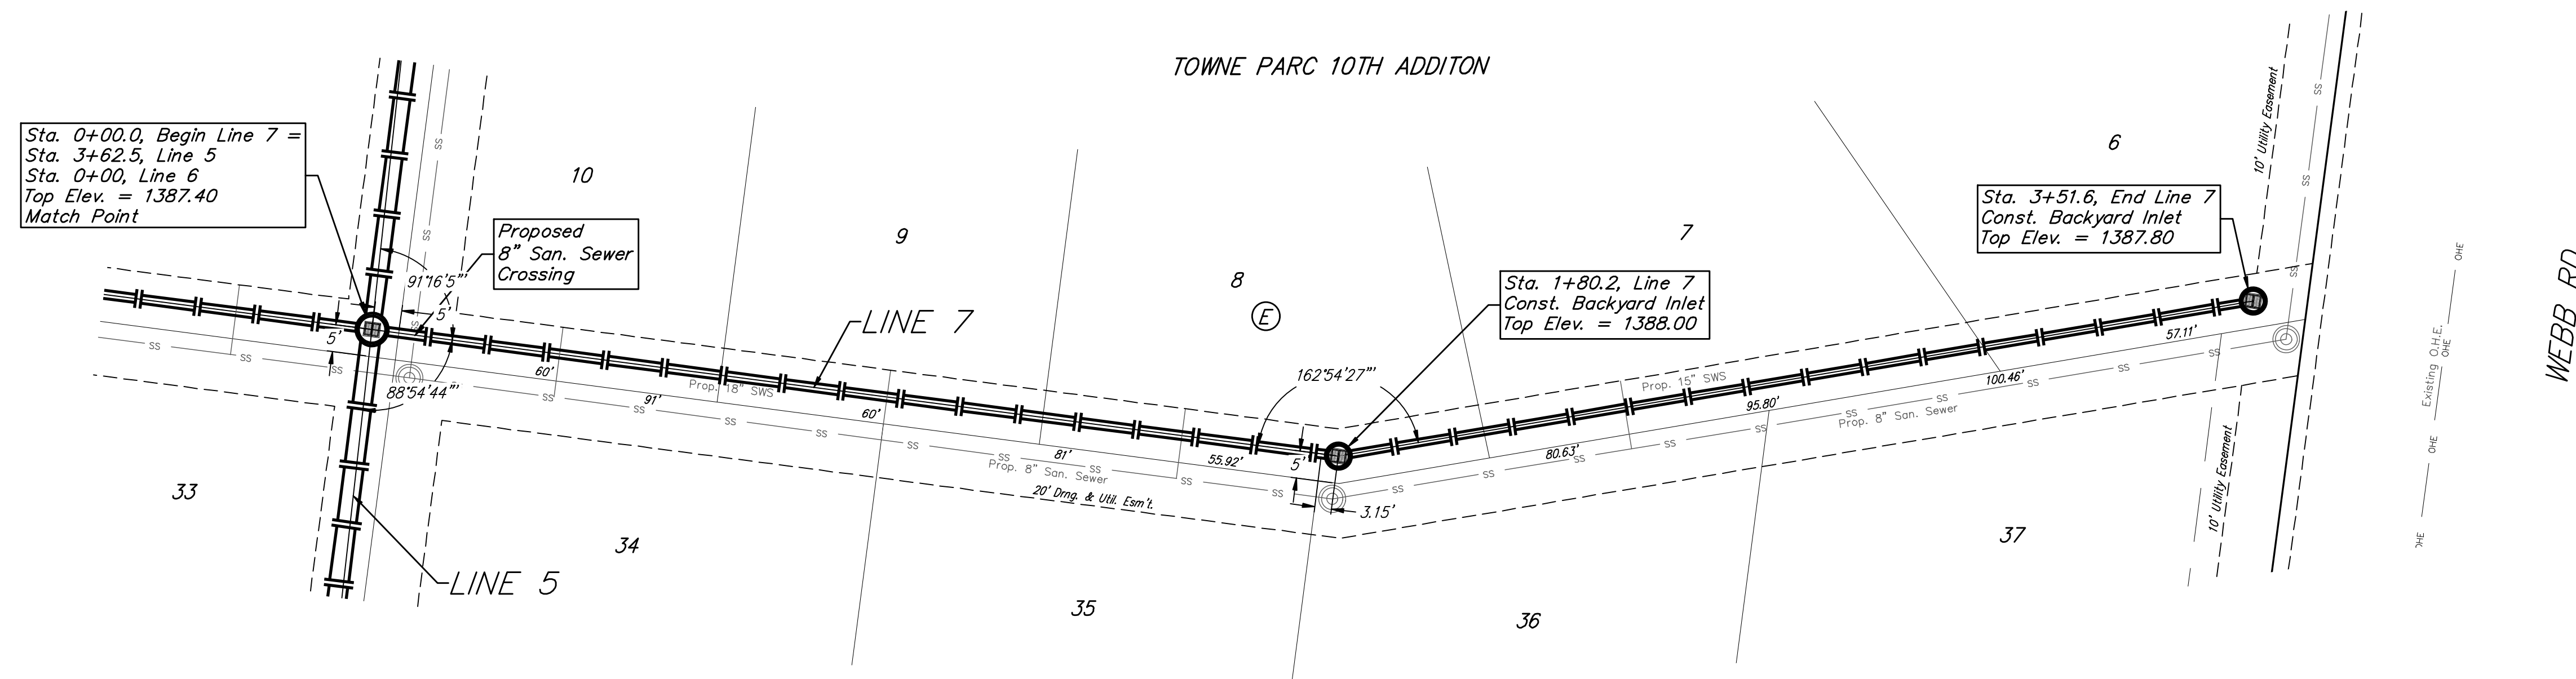

**BRENT WOOLLEN**  
 LICENSED PROFESSIONAL ENGINEER  
 8470  
 06/23/2023  
 KANSAS

**BAUGHMAN COMPANY**  
 315 Ellis St.  
 Wichita, KS 67211  
 316-262-7271  
 BaughmanCo.com

TOWNE PARC 10TH ADDITION

**LINE 7**

STORM WATER DRAIN IMPROVEMENTS

PROJECT NUMBER:  
468-2023-085536

DESIGN: NBW DRAWN: JLD

DATE: June 22, 2023

SHEET OF  
**13R 37**

Adjusted Pipe to Clear Proposed Sanitary Sewer Services.

File: E:\Projects\Towne Parc 10th Addition\_22-01-P743\Engineering\PHASE 1\SWD\_22-11-E352\SWS-SWD.dwg