



TRAFFIC CONTROL PLAN - PHASE 1A
FOR
SEWAGE FLOW CONTROL - PHASE 1

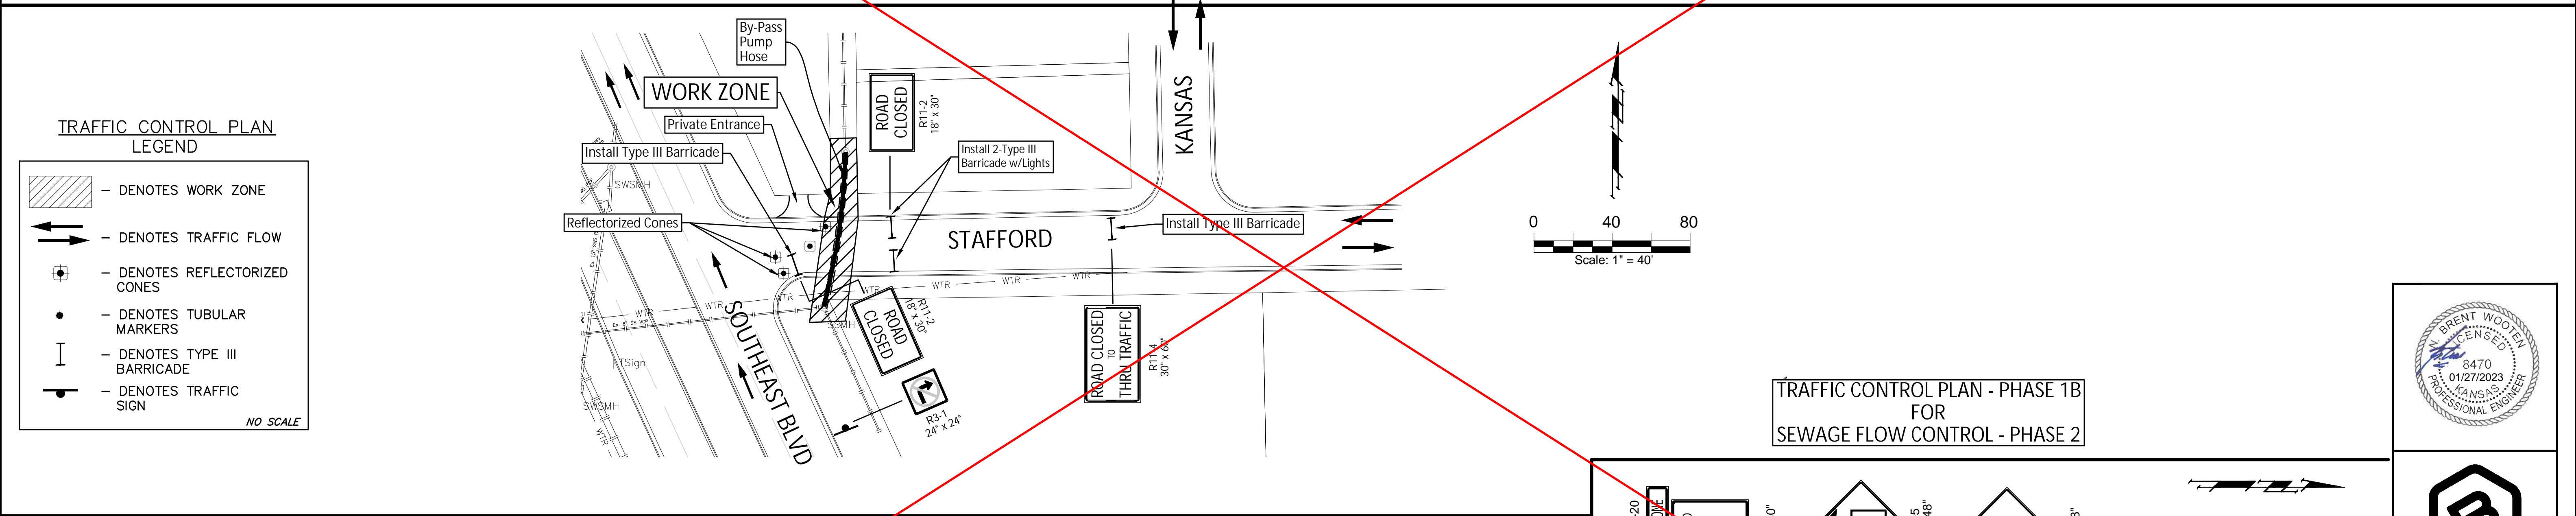

TRAFFIC CONTROL PLAN - PHASE 1B
FOR
SEWAGE FLOW CONTROL - PHASE 2

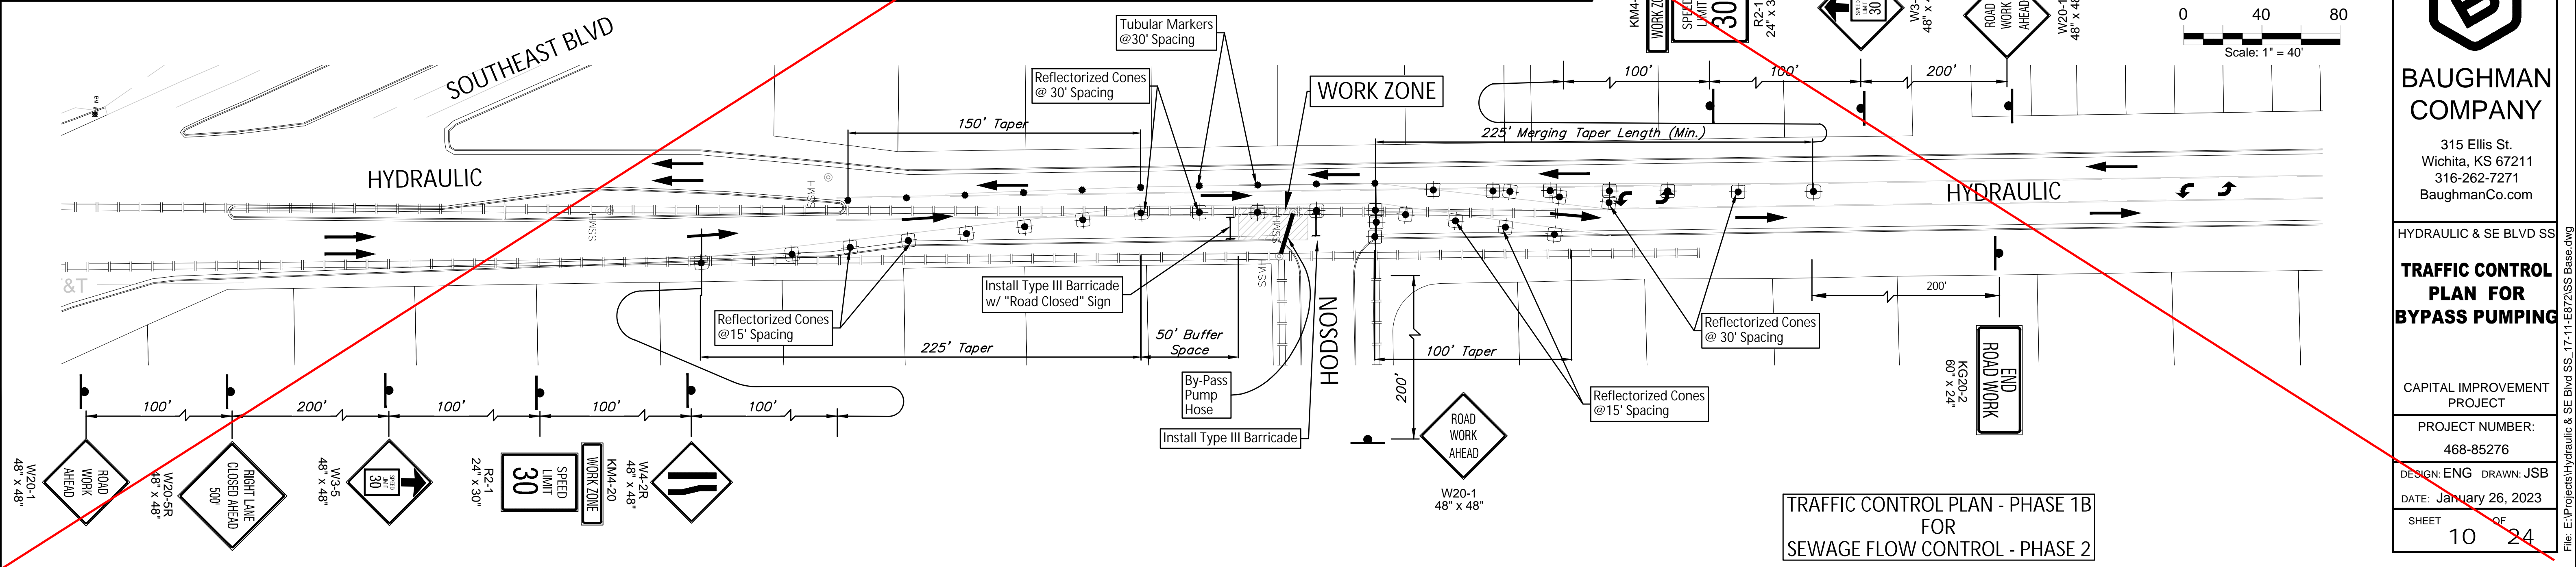

TRAFFIC CONTROL PLAN - PHASE 1B
FOR
SEWAGE FLOW CONTROL - PHASE 2

- TRAFFIC CONTROL PLAN LEGEND**
- DENOTES WORK ZONE
 - DENOTES TRAFFIC FLOW
 - DENOTES REFLECTORIZED CONES
 - DENOTES TUBULAR MARKERS
 - DENOTES TYPE III BARRICADE
 - DENOTES TRAFFIC SIGN
- NO SCALE



BAUGHMAN COMPANY
315 Ellis St.
Wichita, KS 67211
316-262-7271
BaughmanCo.com

HYDRAULIC & SE BLVD SS
TRAFFIC CONTROL PLAN FOR BYPASS PUMPING
CAPITAL IMPROVEMENT PROJECT
PROJECT NUMBER: 468-85276
DESIGN: ENG DRAWN: JSB
DATE: January 26, 2023
SHEET 10 OF 24

File: E:\Projects\Hydraulic & SE Blvd SS-17-11-E872\SS Base.dwg