
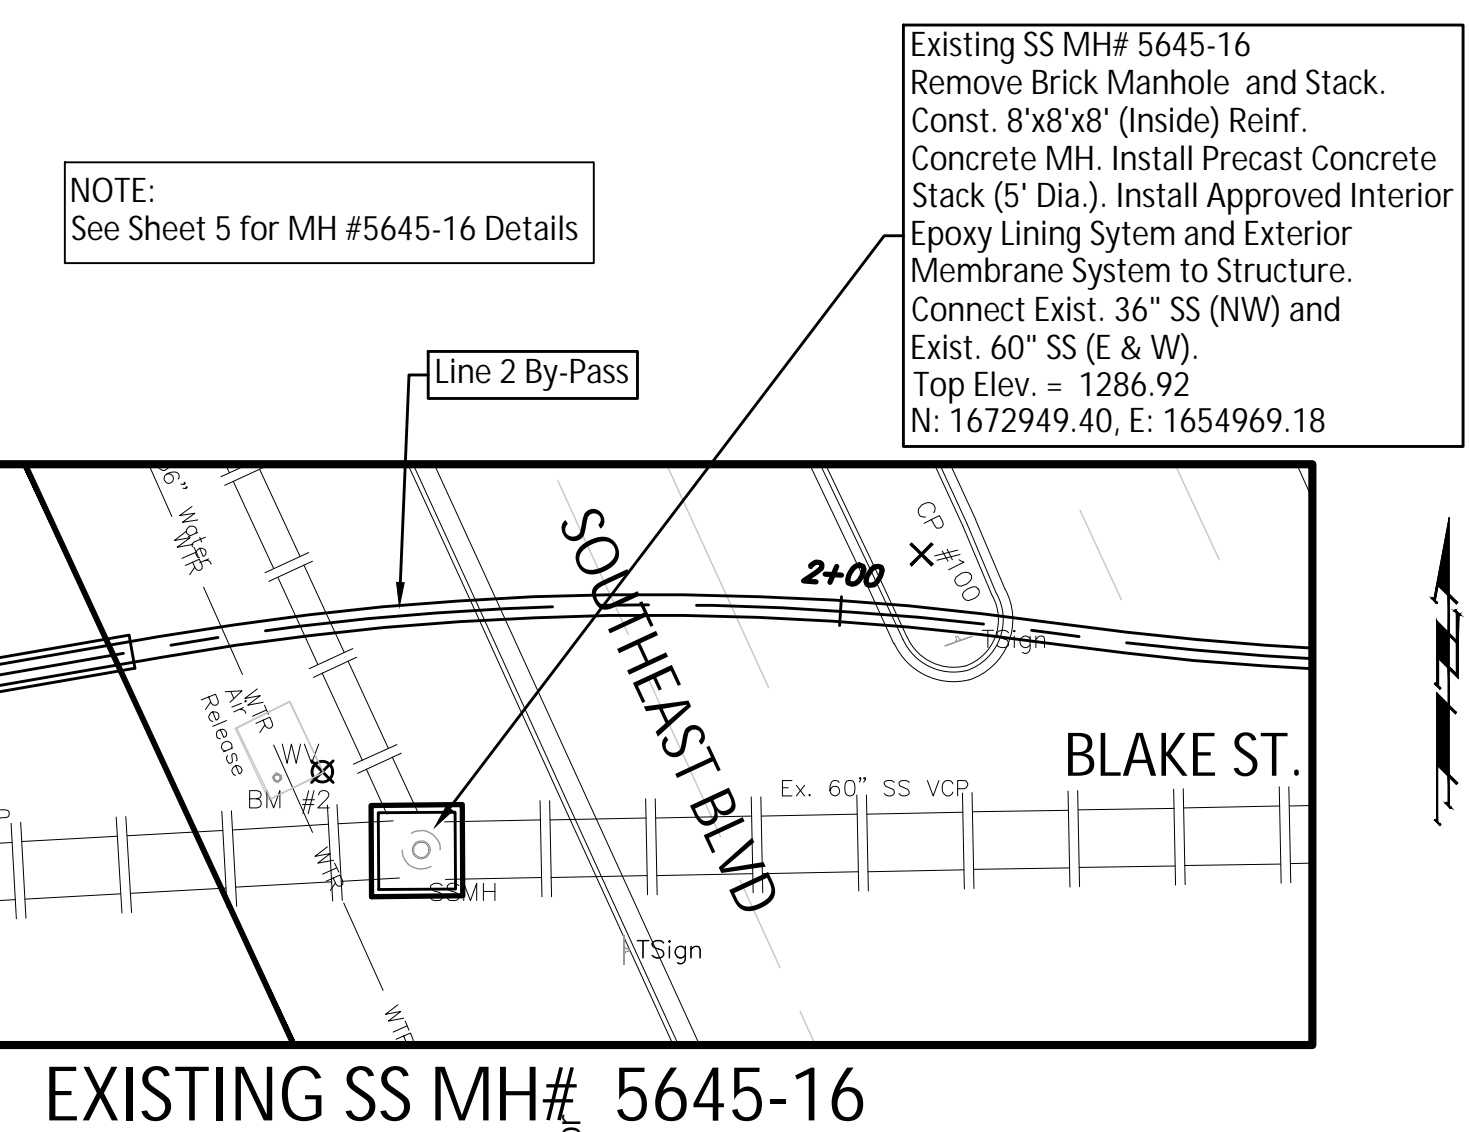
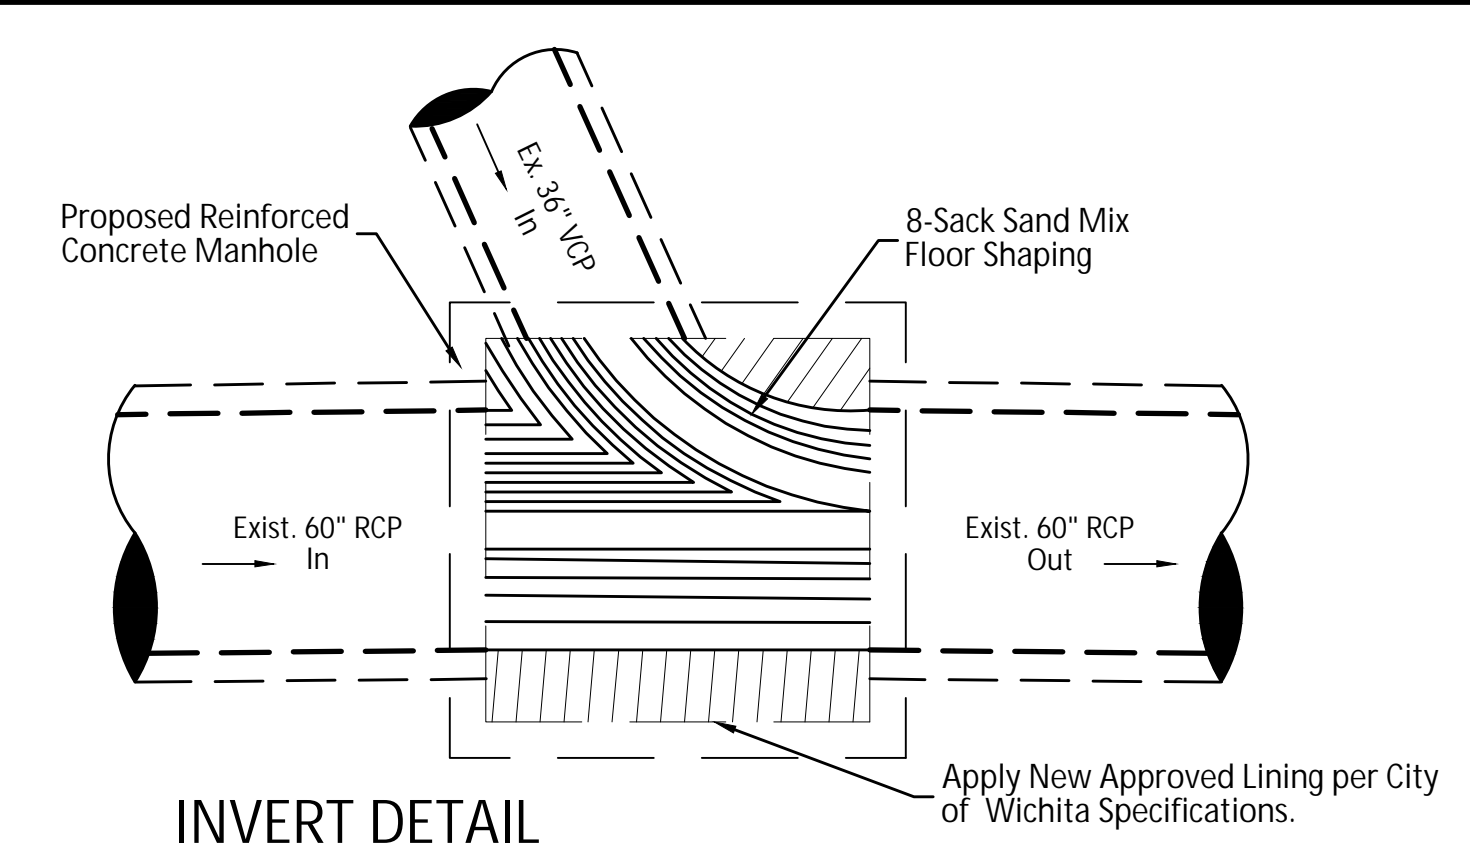
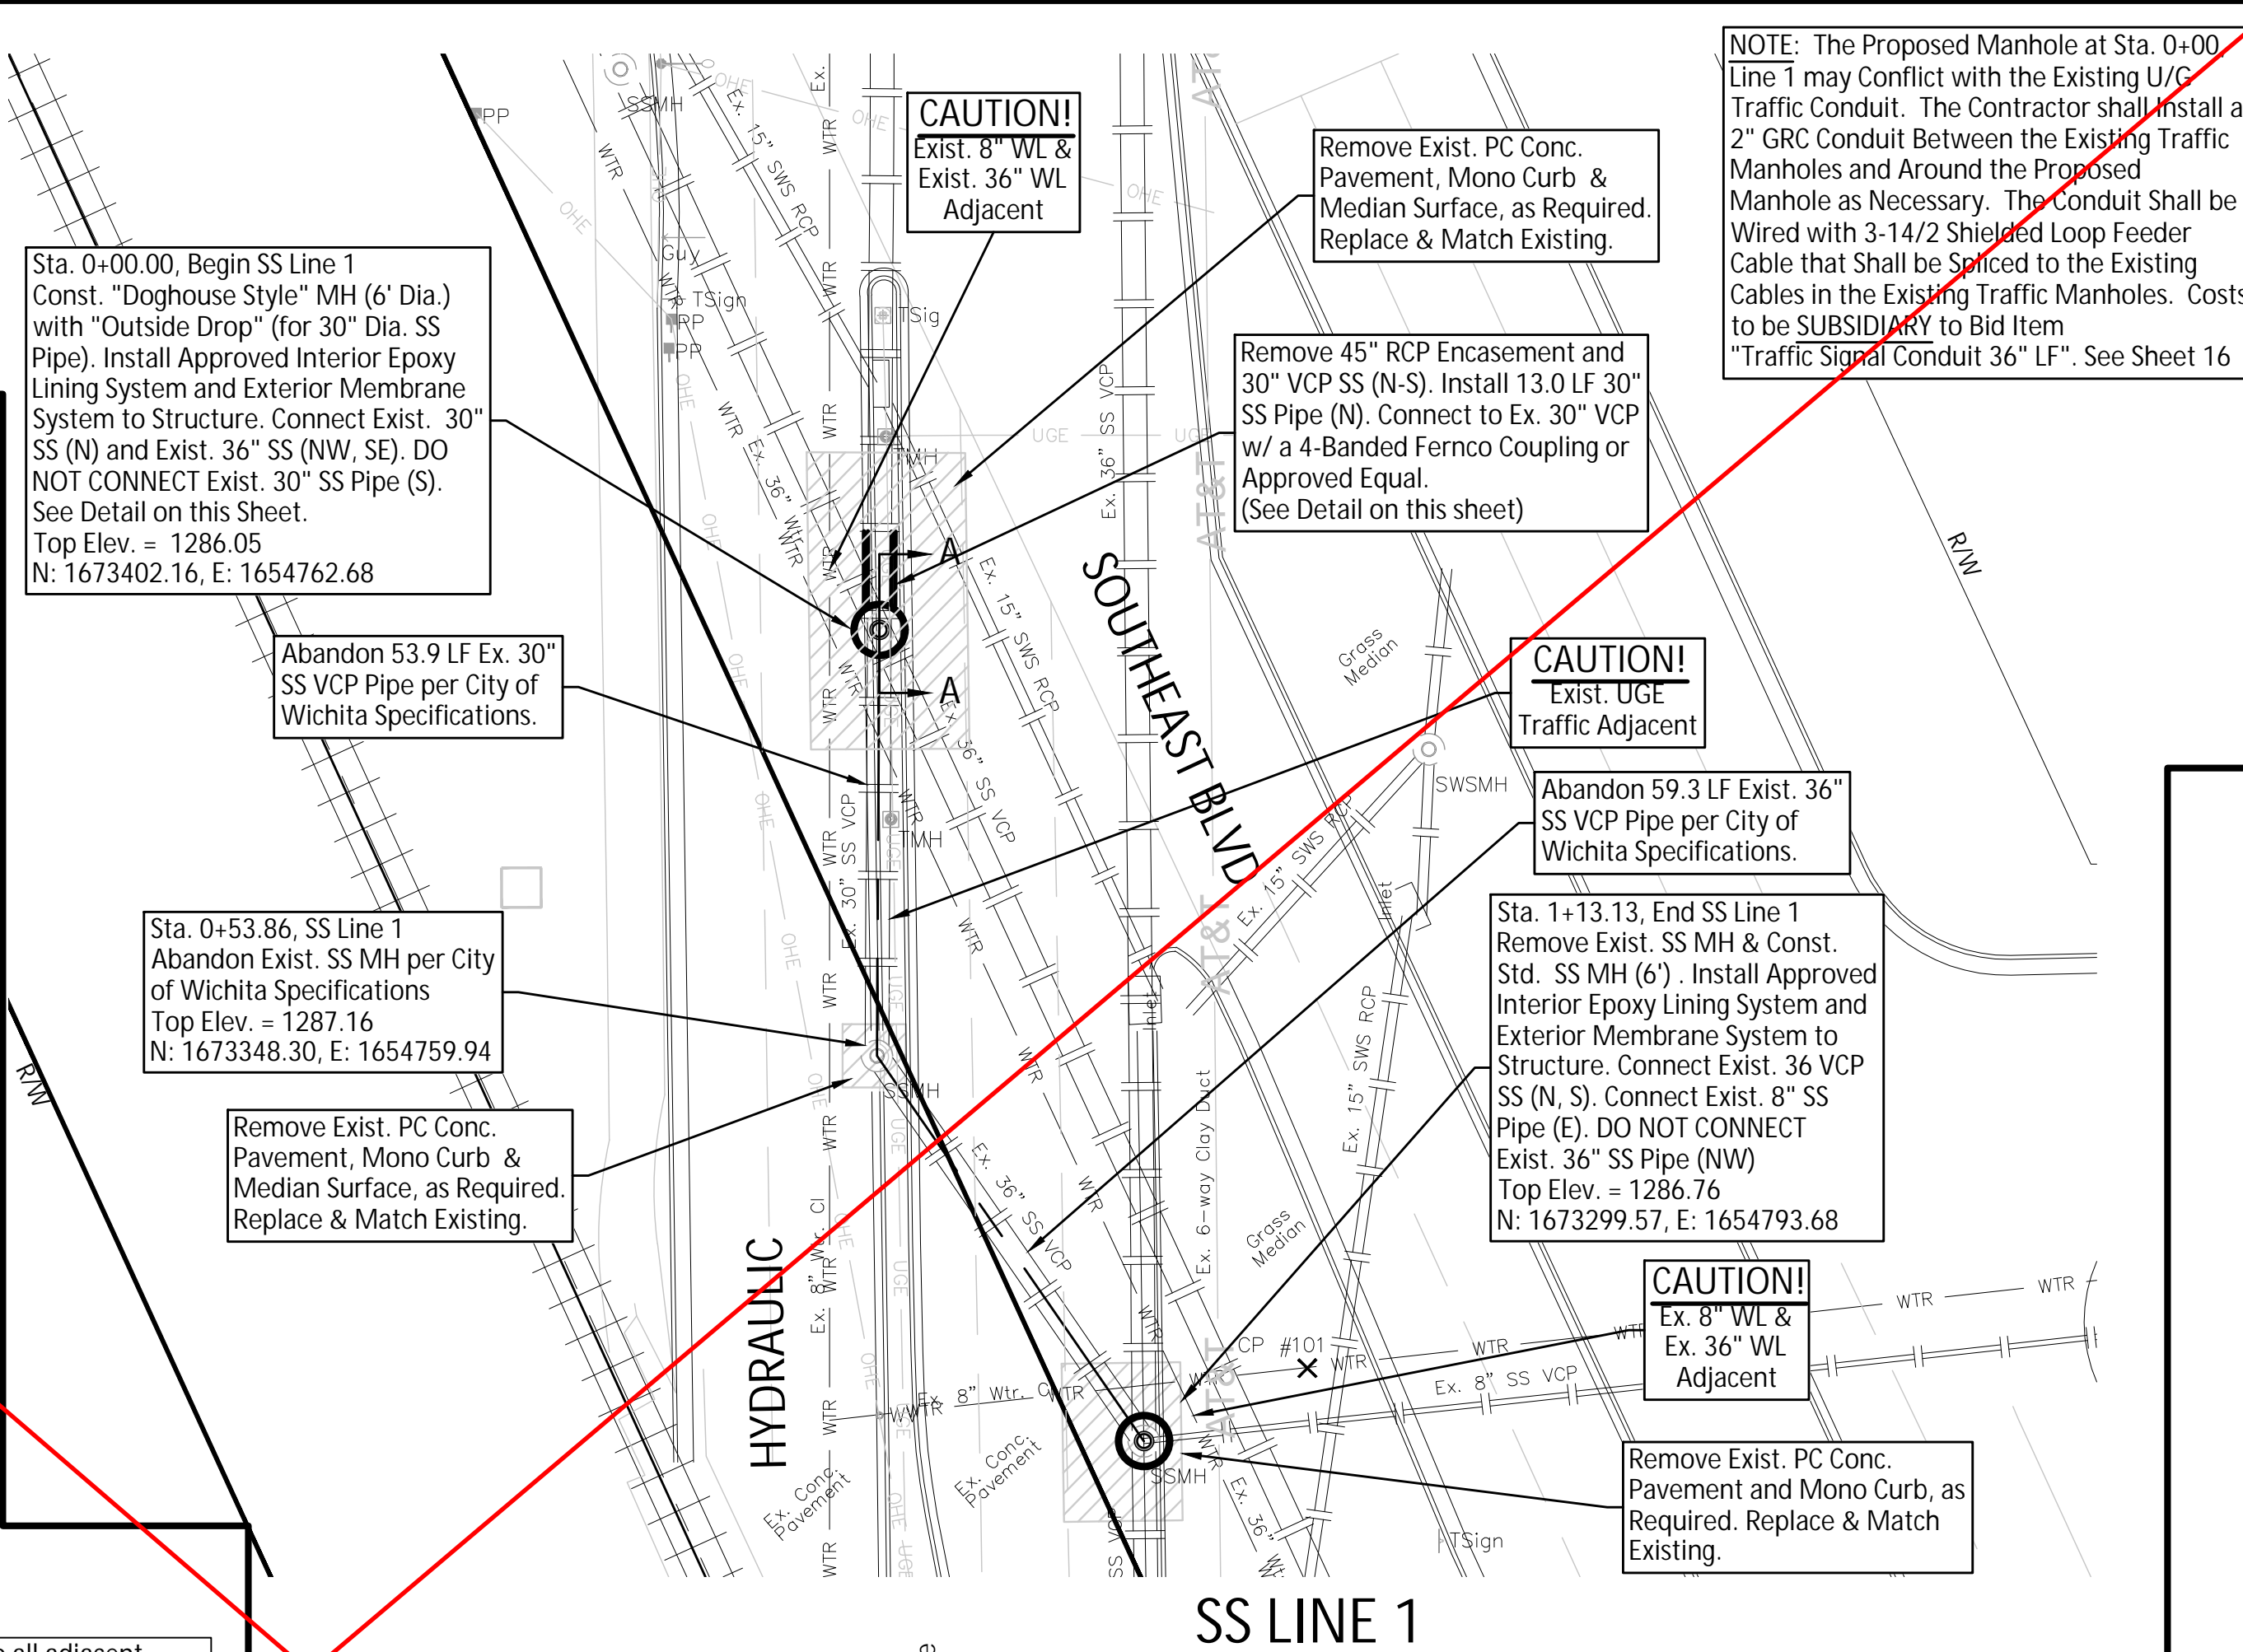
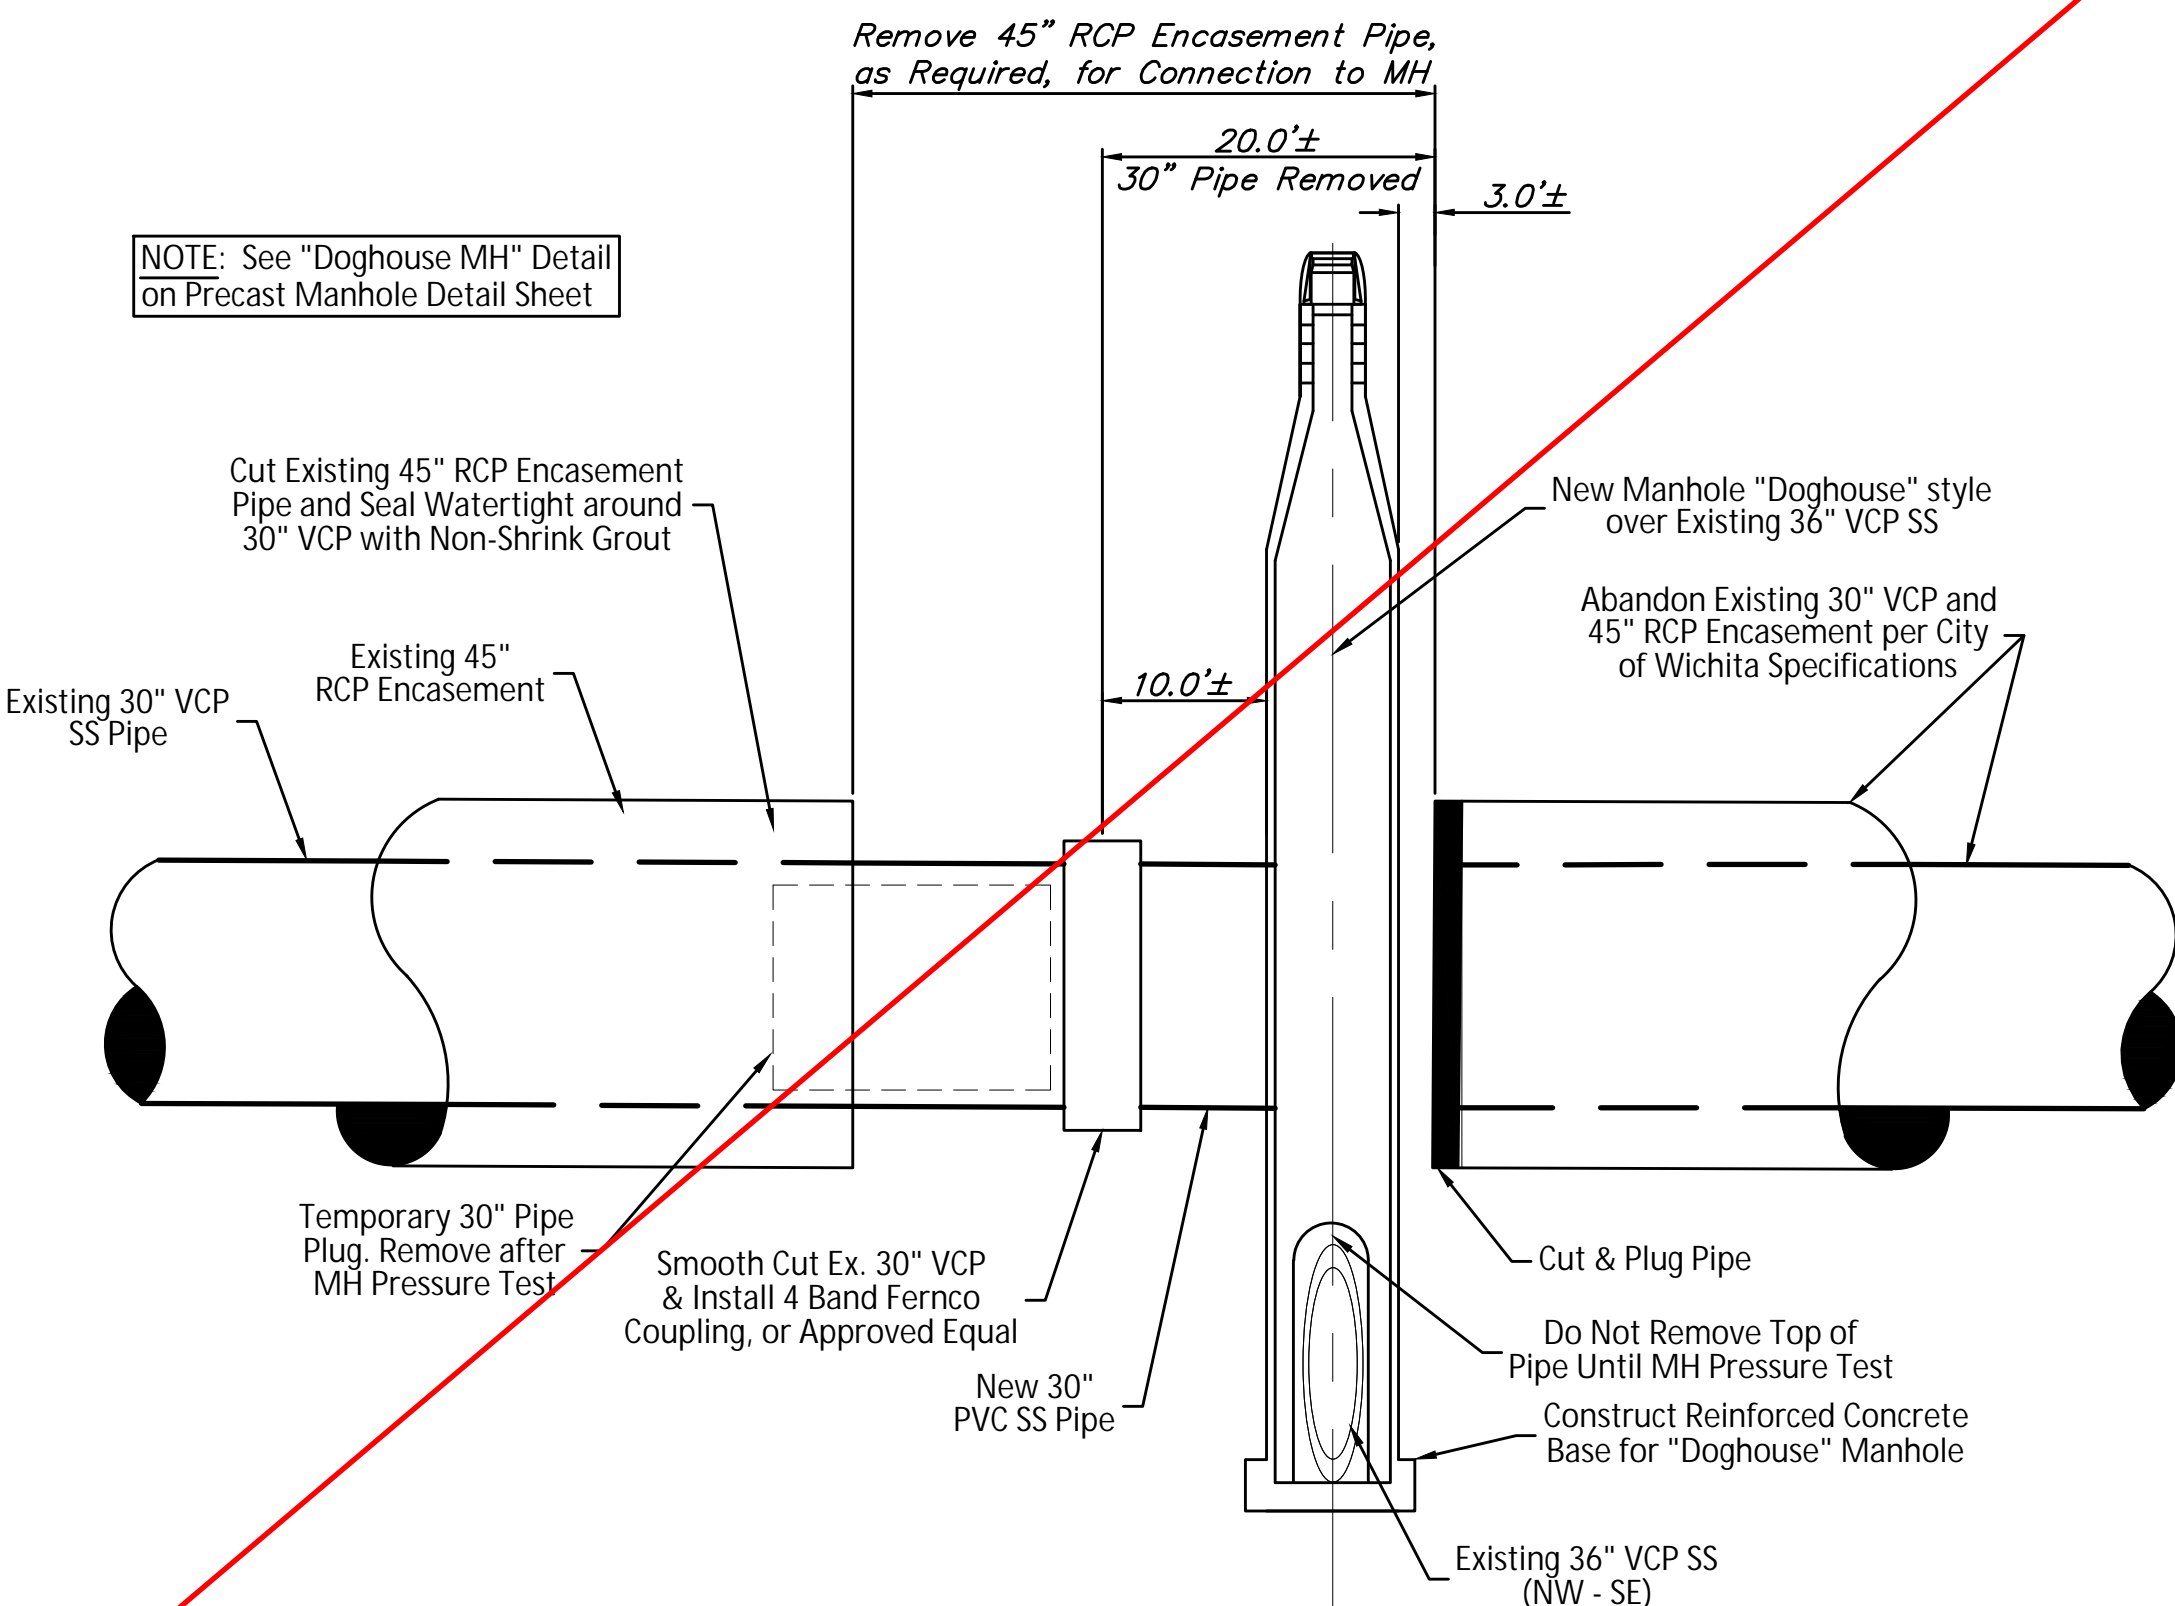
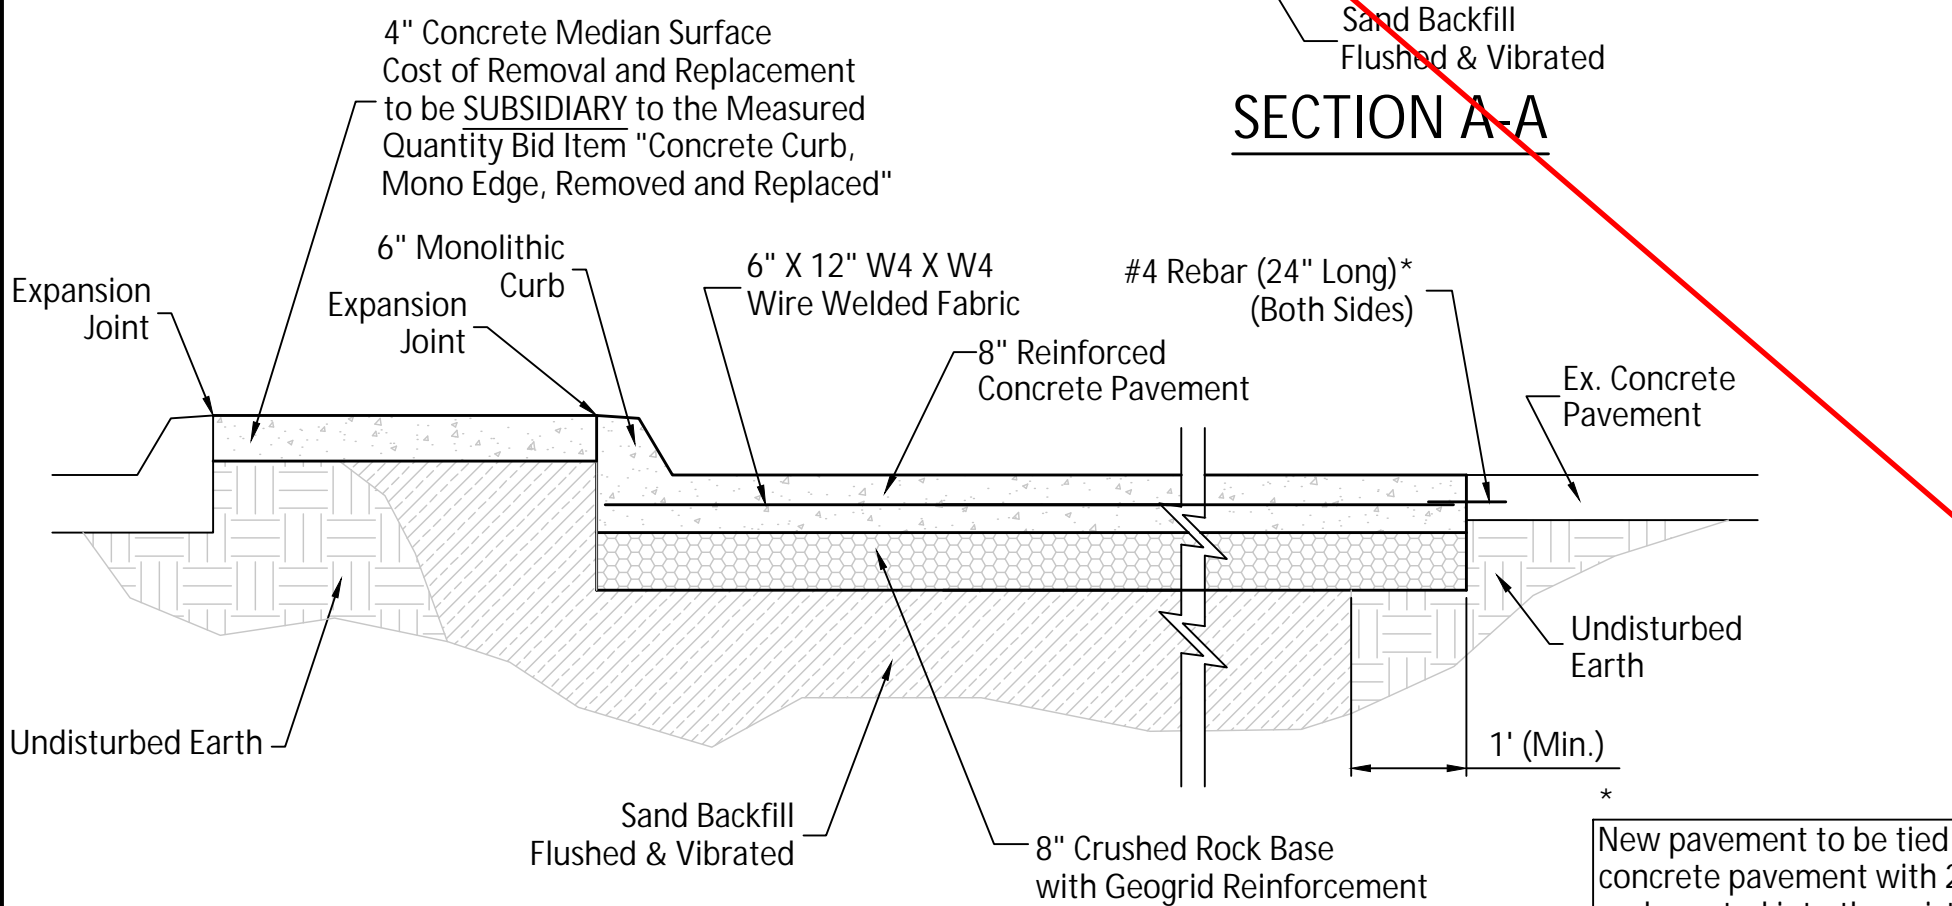
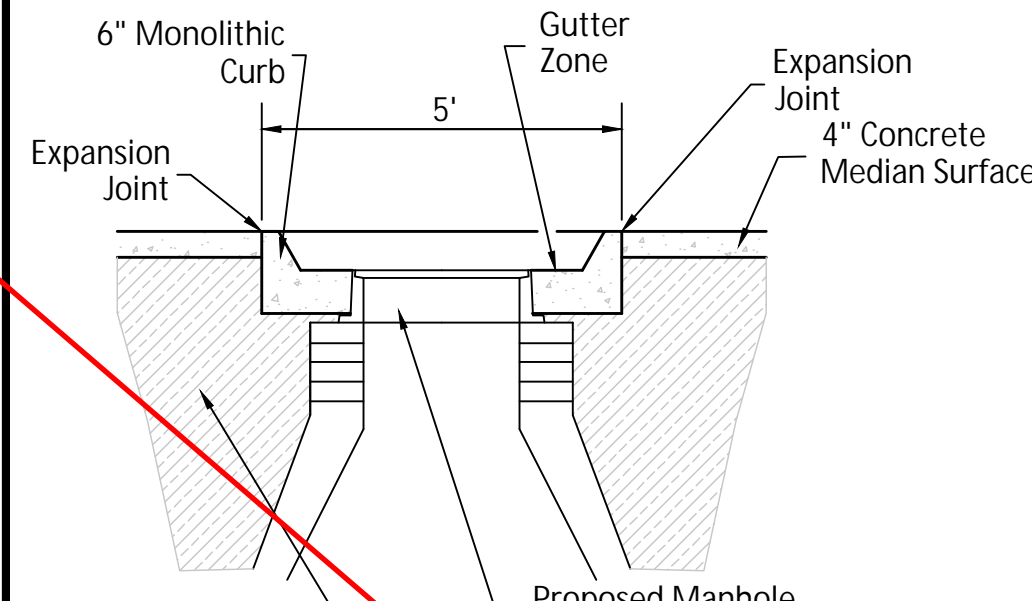
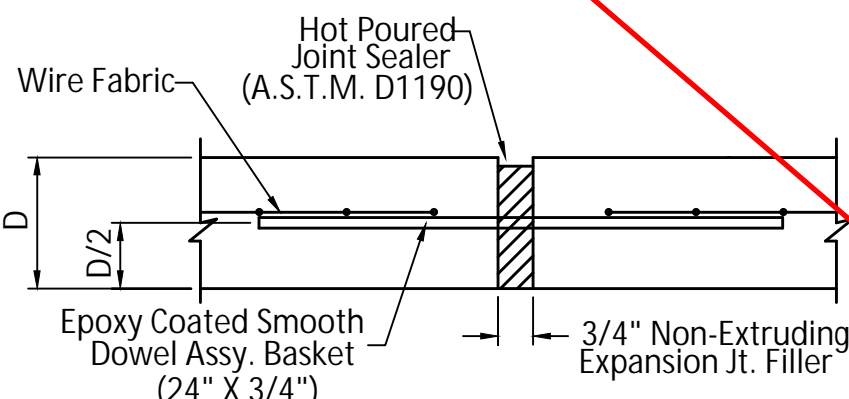


BENCHMARKS

BM #1 - Chiseled "C" in the Top of Curb Located at the Southwest Corner of the Intersection of Hydraulic & Southeast Blvd. 6' East of Fire Hydrant.
Elev. = 1286.43 (NAVD 88)

BM #2 - Chiseled "X" on the Concrete Pad w/ a Vent Pipe Located 500' Southeast of the Intersection of Hydraulic & Southeast Blvd. on the Southwest Side of Southeast Blvd.
Elev. = 1285.59 (NAVD 88)

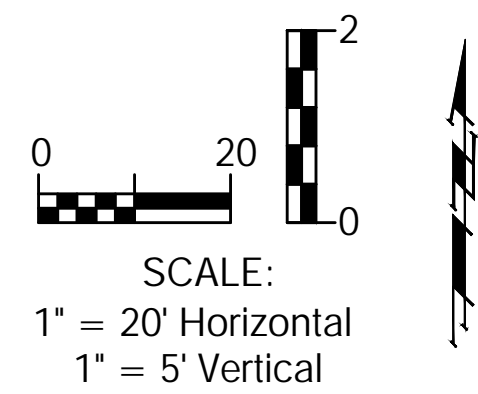

1295	1295	1295	1295
1290	1290	1290	1290
1285	1285	1285	1285
1280	1280	1280	1280
1275	1275	1275	1275
1270	1270	1270	1270
1265	1265	1265	1265

BAUGHMAN COMPANY
315 Ellis St.
Wichita, KS 67211
316-262-7271
BaughmanCo.com

HYDRAULIC & SE BLVD SS
SANITARY SEWER LINE 1 & MH REHABILITATION

CAPITAL IMPROVEMENT PROJECT
PROJECT NUMBER: 468-85276
DESIGN: ENG DRAWN: JSB
DATE: January 26, 2023
SHEET 3 OF 24