




1" = 40'

0 20 40 80 120 Feet

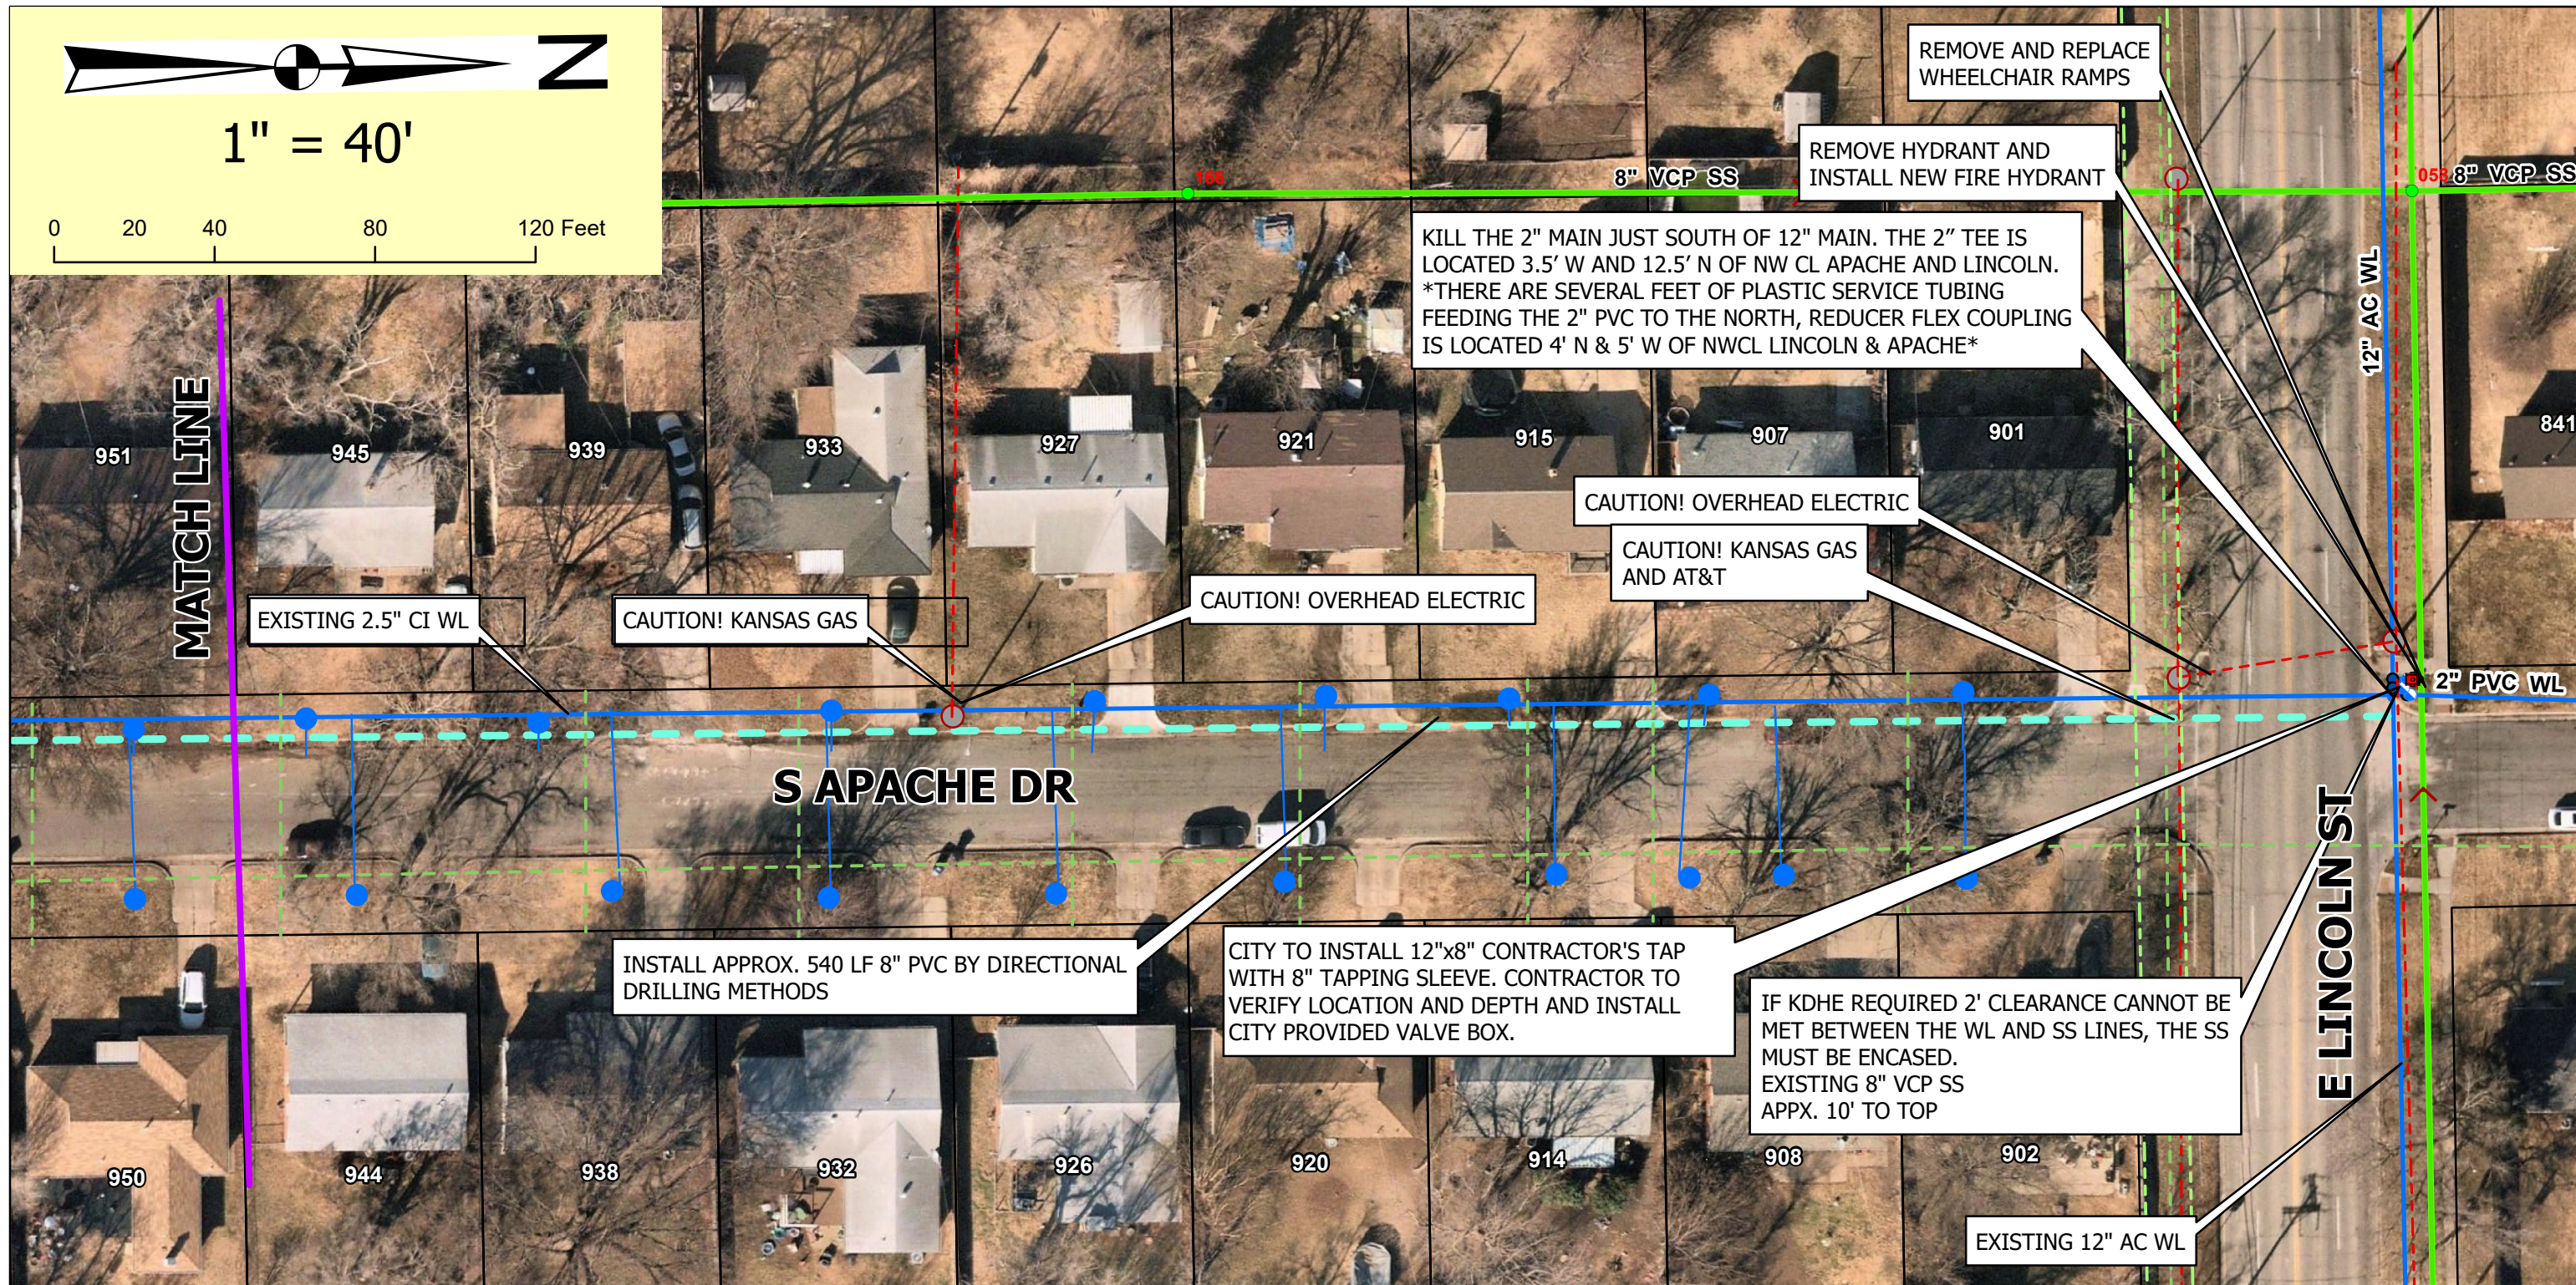

**SERVICE LINES:**

901 S APACHE 57293-100  
 902 S APACHE 57320-100  
 907 S APACHE 62348-100  
 908 S APACHE 117721-200  
 908 S APACHE 61582-100  
 914 S APACHE 61607-100  
 915 S APACHE 62349-100

**SERVICE LINES:**

920 S APACHE 61625-100  
 921 S APACHE 62350-100  
 926 S APACHE 61581-100  
 927 S APACHE 62351-100  
 932 S APACHE 61606-100  
 933 S APACHE 62352-100  
 938 S APACHE 61596-100

**SERVICE LINES:**

939 S APACHE 62353-100  
 944 S APACHE 61673-100  
 945 S APACHE 62256-100



**APACHE WATER MAIN REPLACEMENT**

448-2023-027449  
 MUNIS NO W3017  
 ORG CODE 54250023  
 SHEET 4 OF 12