UNOFFICIAL

FOR REFERENCE ONLY

Buena Vista Addition
Replat of Avila Luxury Townhomes Addition
Wichita, Sedgwick County, Kansas
Part of the NW ¼, Section 33, Township 27 South, Range 2 East

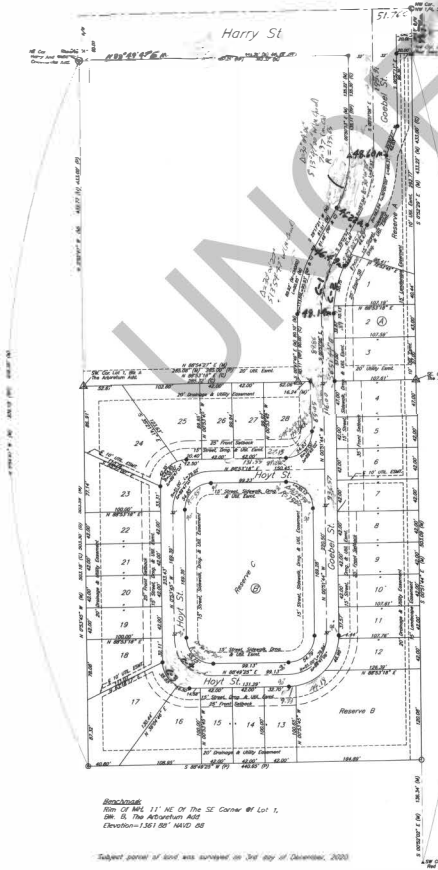
Harry St.
Hoyt St.
Hoyt St.
Reserve A
Reserve B
Reserve C
