



FOX RIDGE ADDITION

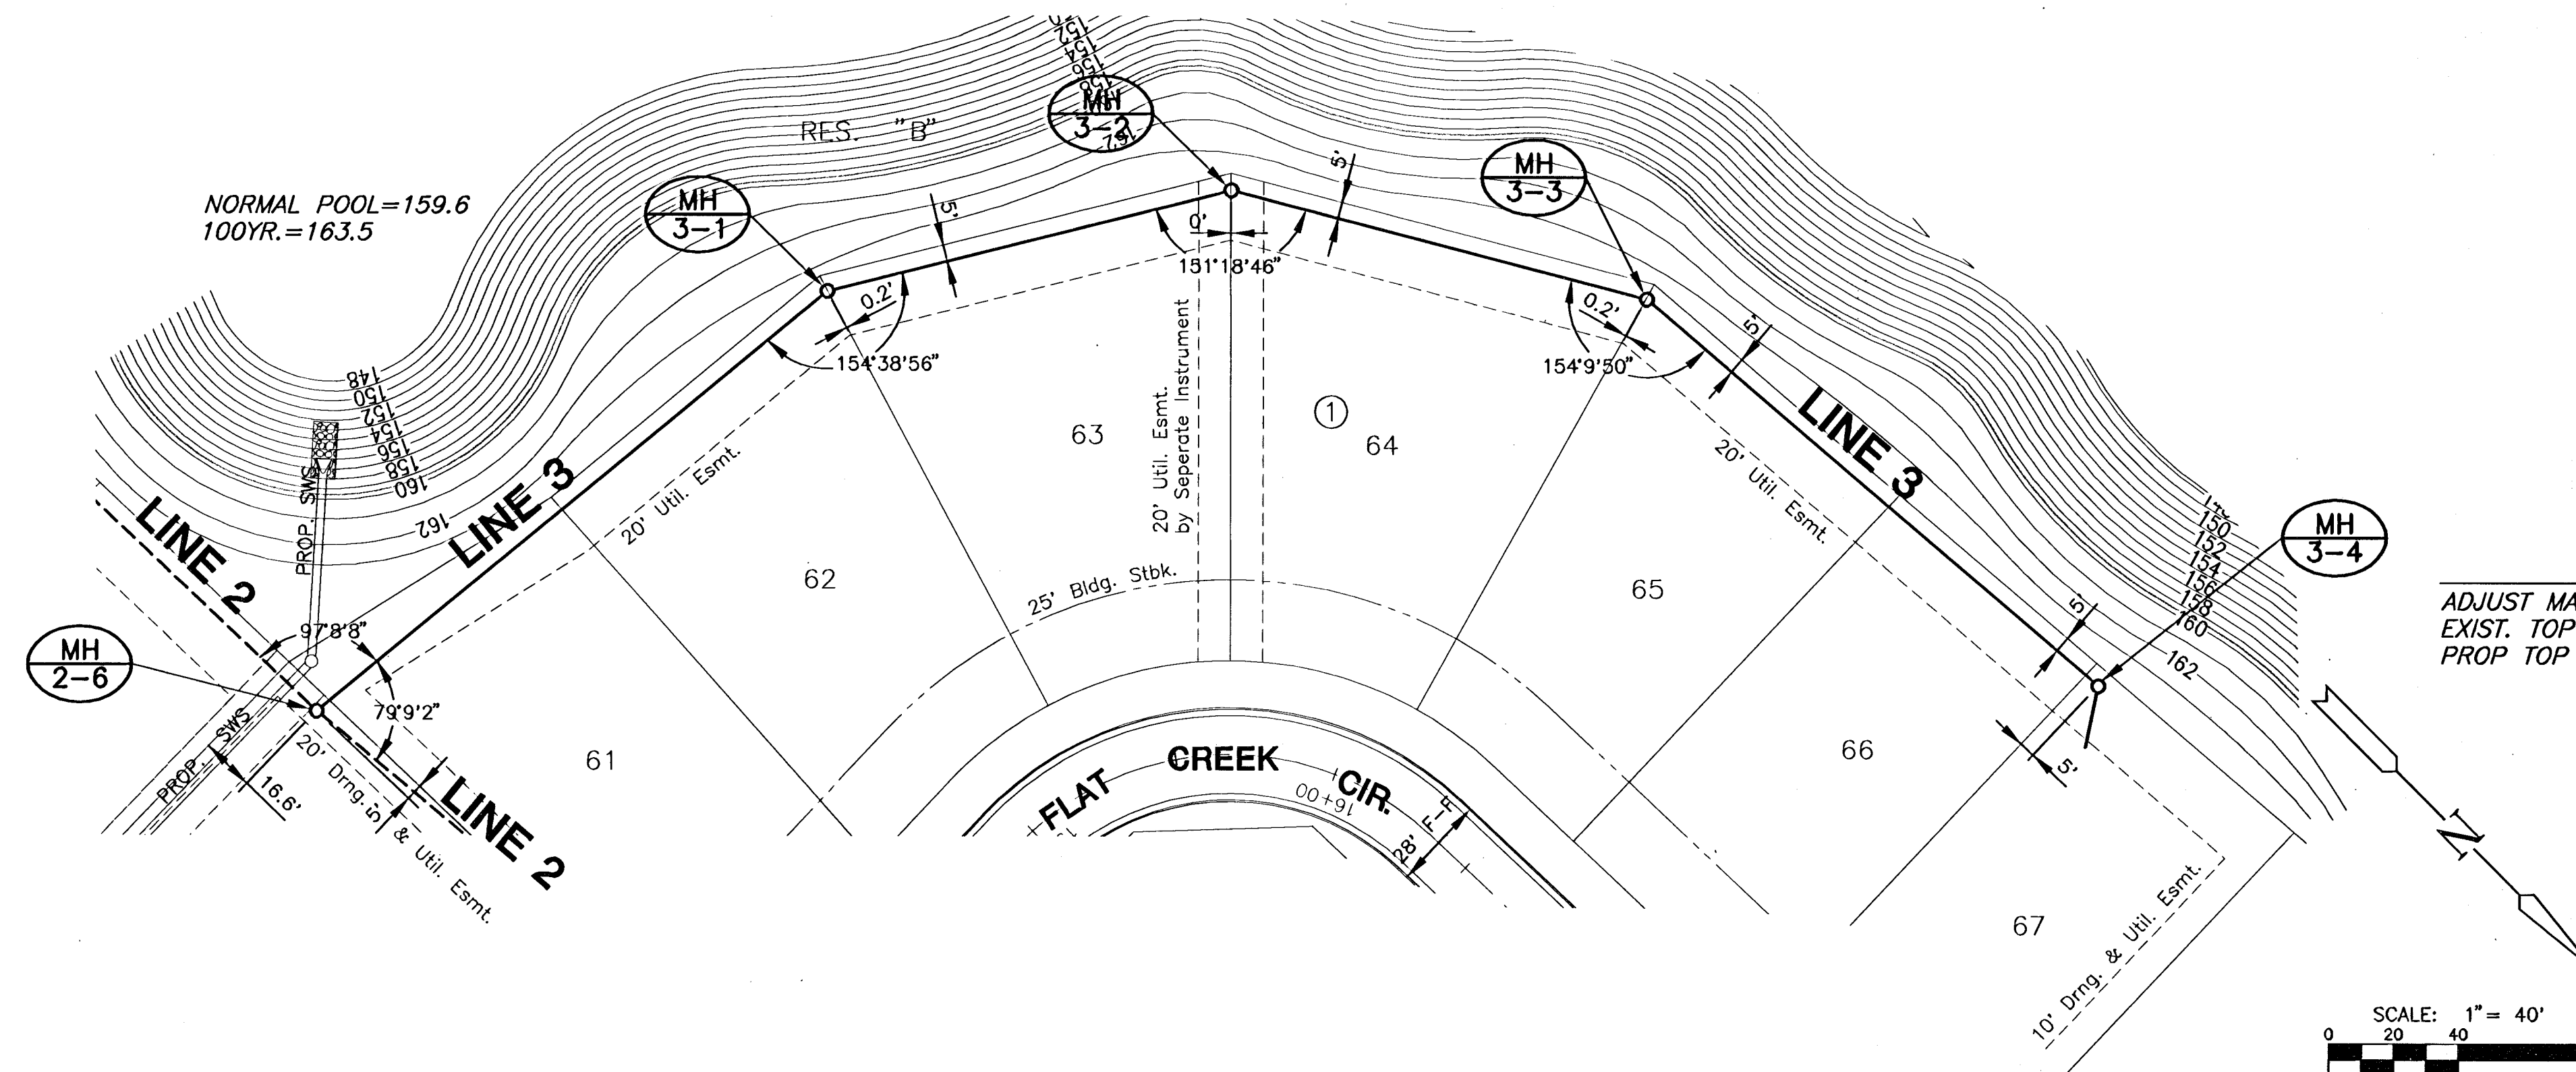


PLAN LINE 3

FOX RIDGE ADDITION

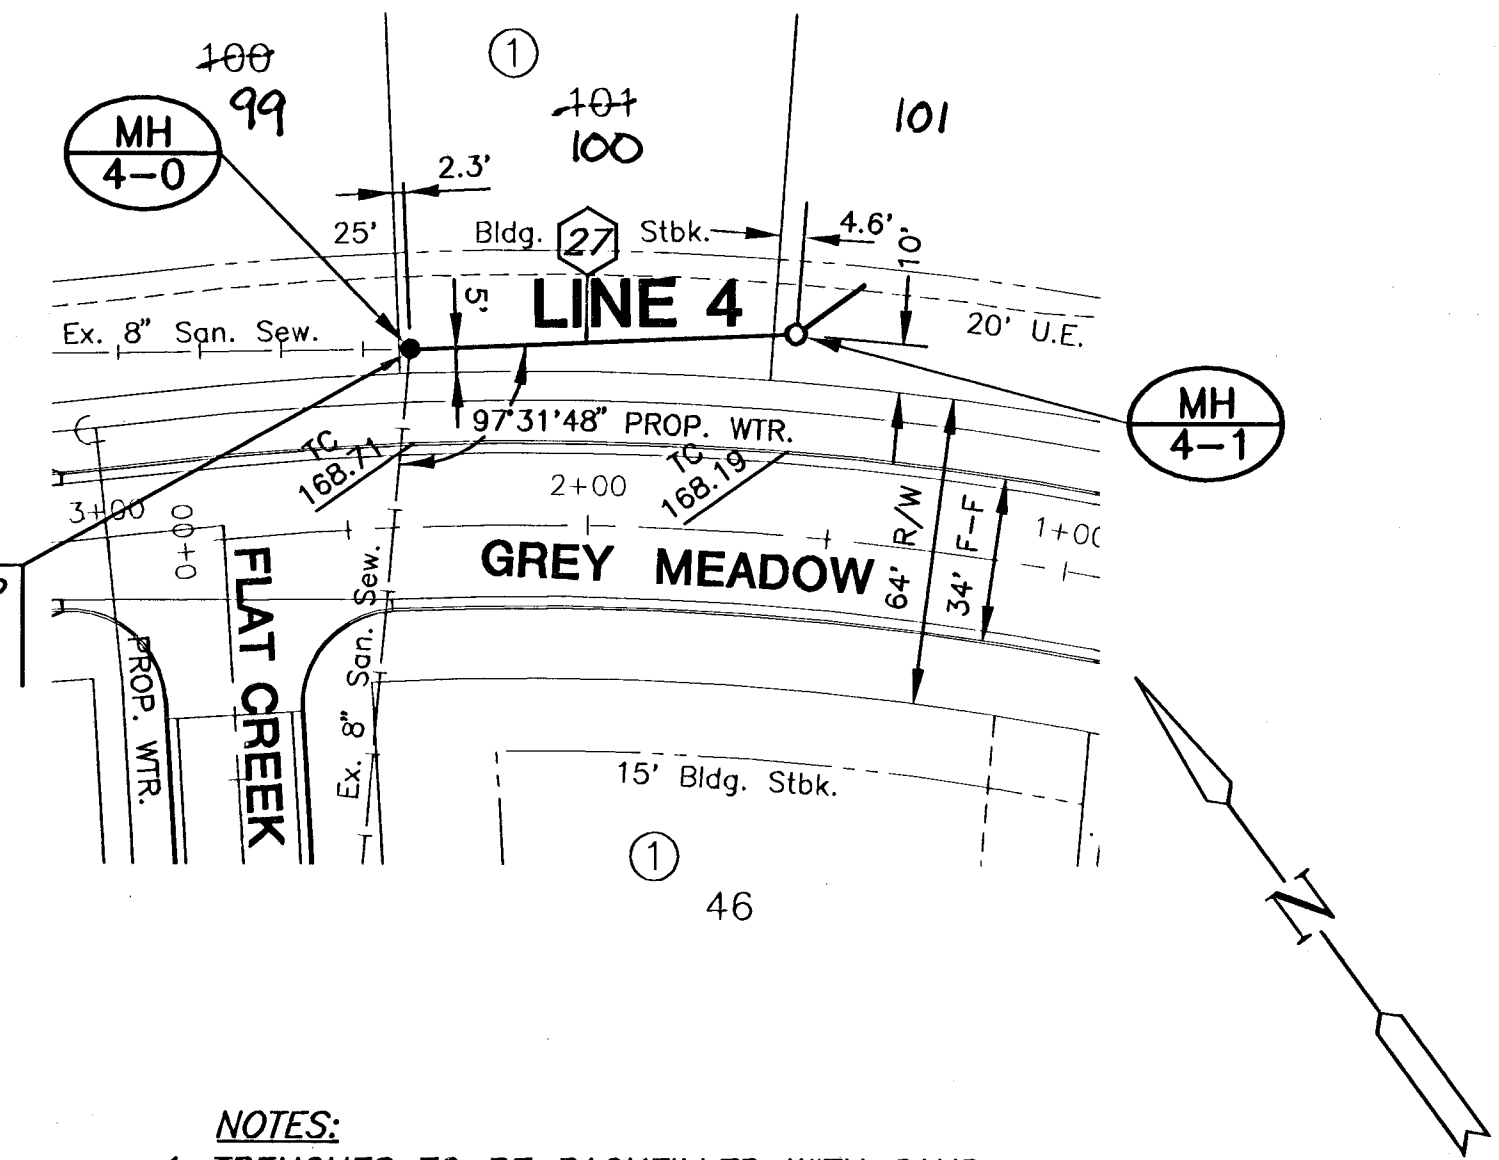

PLAN LINE 4

- NOTES:
- TRENCHES TO BE BACKFILLED WITH SAND AND FLUSHED WHEN SEWER LINE RUNS ALONG FRONT OF LOTS.

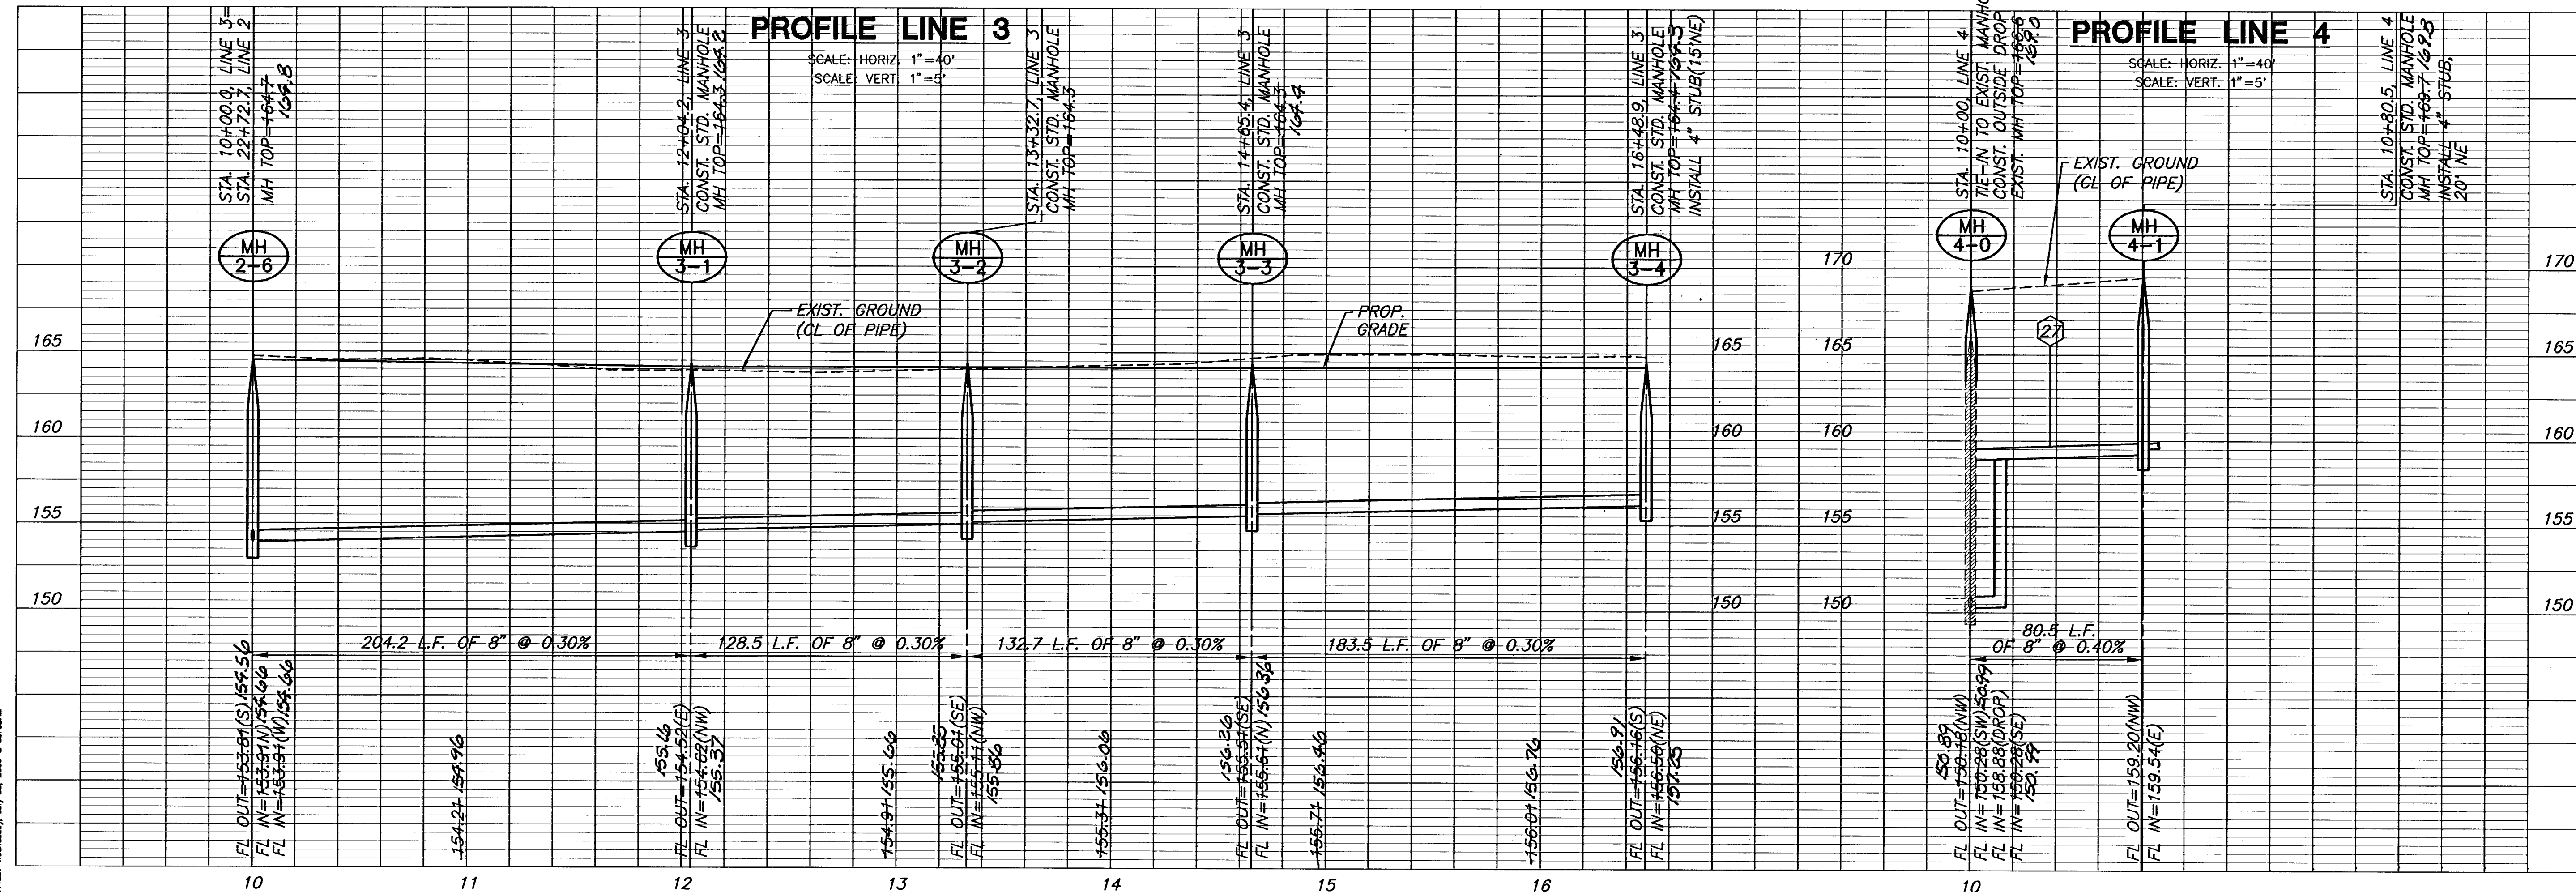

MKEC
ENGINEERING
CONSULTANTS, INC.

411 N. WEBB ROAD
WICHITA, KS. 67206
316-684-9600

SANITARY SEWER PLANS FOX RIDGE PHASE 9

LINE 3 & 4

SHEET TITLE
468-84202
PROJECT NUMBER

DESIGN BY
MKEC
DRAWN BY
GJA
CHECKED BY

ISSUED
JULY 2006
REVISED

SHEET NO.
7 of 14