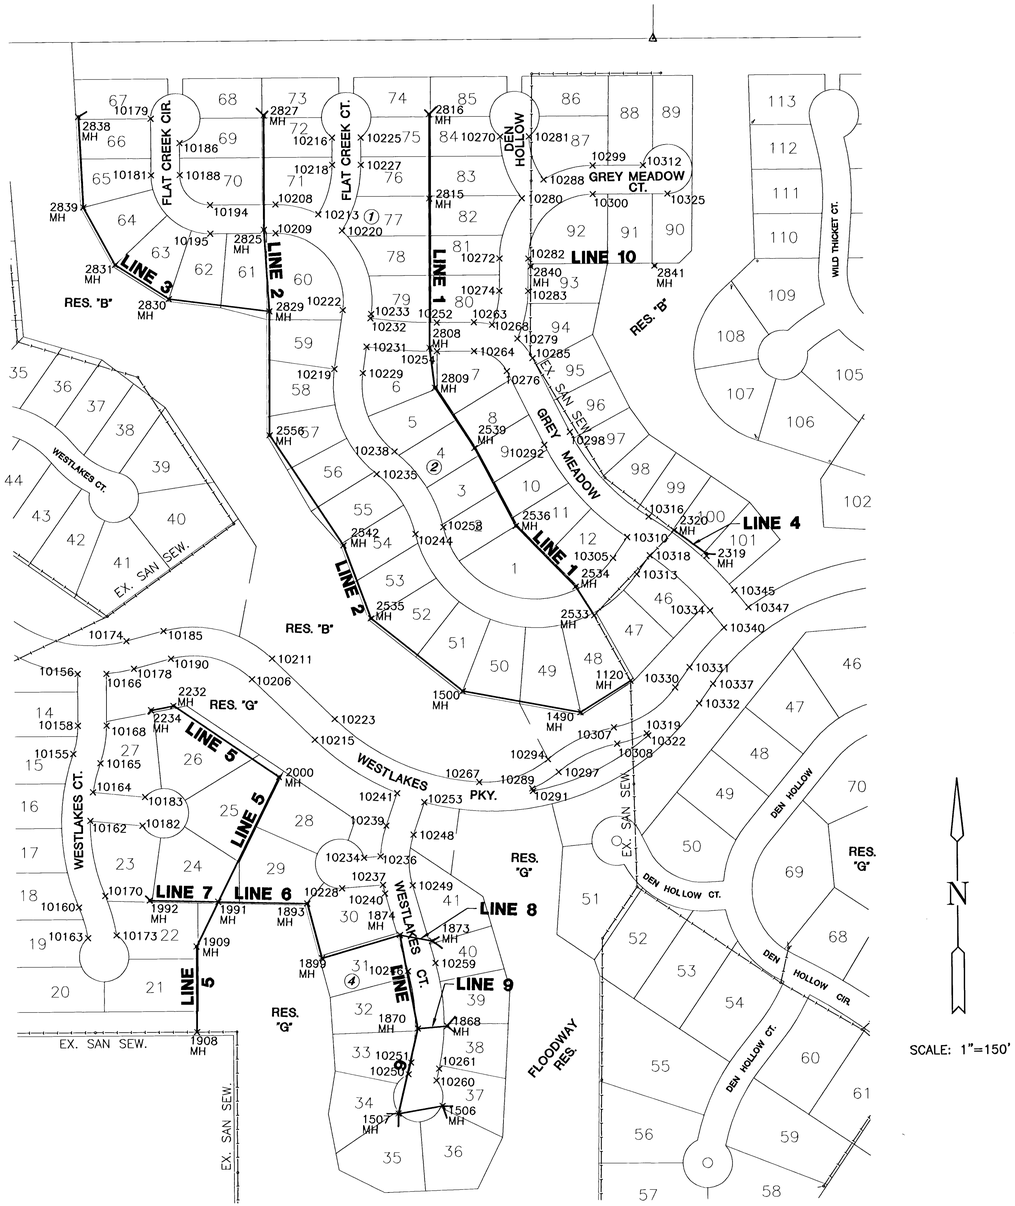

SCALE: 1"=150'

Sanitary Sewer Points

Point No.	Northing	Easting	Description
1120	1705431.554	1615047.197	MH
1490	1705365.358	1614947.950	MH
1500	1705401.696	1614709.107	MH
1506	1704583.797	1614690.215	MH
1507	1704545.954	1614601.826	MH
1868	1704725.431	1614695.123	MH
1870	1704718.859	1614636.157	MH
1873	1704898.136	1614660.402	MH
1874	1704906.183	1614595.056	MH
1893	1704964.737	1614408.409	MH
1899	1704855.677	1614439.021	MH
1908	1704700.027	1614190.939	MH
1909	1704872.407	1614185.492	MH
1991	1704963.701	1614226.848	MH
1992	1704962.904	1614088.617	MH
2000	1705218.881	1614342.442	MH
2232	1705358.628	1614125.961	MH
2234	1705348.636	1614080.774	MH
2319	1705687.516	1615193.757	MH
2320	1705737.073	1615126.887	MH
2533	1705561.239	1614970.259	MH
2534	1705618.469	1614931.100	MH
2535	1705543.492	1614519.517	MH
2536	1705737.593	1614807.392	MH
2539	1705892.202	1614719.818	MH
2542	1705689.445	1614460.216	MH
2556	1705907.151	1614305.252	MH
2808	1706092.126	1614823.489	MH
2809	1706012.309	1614836.124	MH
2815	1706392.898	1614614.993	MH
2816	1706562.831	1614610.193	MH
2825	1706321.224	1614282.887	MH
2827	1706552.125	1614276.364	MH
2829	1706157.304	1614298.186	MH
2830	1706176.936	1614094.947	MH
2831	1706242.862	1613984.657	MH
2838	1706539.836	1613902.363	MH
2839	1706357.305	1613917.395	MH
2840	1706261.518	1614823.623	MH
2841	1706269.531	1615073.469	MH

Plat Points

Point No.	Northing	Easting	Description
10155	1705254.658	1613928.147	PI
10156	1705418.108	1613930.824	PI
10158	1705311.738	1613934.040	PI
10160	1704945.215	1613945.804	PI
10162	1705120.744	1613964.169	PI
10163	1704883.957	1613965.715	PI
10164	1705178.619	1613987.980	PI
10165	1705237.353	1613981.442	PI
10166	1705417.893	1613988.798	PI
10168	1705313.524	1613992.013	PI
10170	1704969.573	1613998.441	PI
10173	1704890.927	1614023.430	PI
10174	1705485.018	1614027.665	PI
10178	1705429.487	1614044.348	PI
10179	1706539.836	1614048.813	PI
10181	1706425.895	1614052.468	PI
10182	1705113.783	1614069.887	PI
10183	1705171.658	1614073.879	PI
10185	1705507.304	1614101.877	PI
10188	1706492.364	1614108.365	PI
10188	1706427.753	1614110.438	PI
10190	1705451.755	1614118.560	PI
10194	1706368.739	1614173.360	PI
10195	1706310.769	1614175.218	PI
10208	1705414.218	1614283.098	PI
10208	1706372.955	1614304.878	PI
10209	1706314.985	1614308.737	PI
10211	1705457.034	1614322.220	PI
10213	1706355.428	1614391.894	PI
10215	1705295.703	1614412.795	PI
10216	1706510.953	1614415.581	PI
10218	1706455.854	1614417.138	PI
10219	1706044.573	1614432.548	PI
10220	1706323.608	1614440.479	PI
10222	1706183.543	1614448.207	PI
10223	1705338.520	1614451.919	PI
10225	1706512.591	1614473.558	PI
10227	1706457.491	1614475.114	PI
10228	1704997.325	1614475.690	PI
10229	1706037.957	1614490.169	PI
10231	1706090.851	1614498.242	PI
10232	1706148.474	1614502.858	PI
10233	1706156.927	1614503.828	PI
10234	1705060.352	1614518.441	PI
10235	1705834.529	1614523.624	PI
10238	1705064.002	1614551.781	PI
10237	1705008.348	1614558.093	PI
10238	1705881.113	1614558.178	PI
10239	1705128.779	1614561.729	PI
10240	1704989.372	1614562.873	PI
10241	1705192.814	1614581.898	PI
10244	1705715.889	1614604.978	PI
10246	1704834.114	1614613.128	PI
10248	1705109.838	1614617.200	PI
10249	1705007.233	1614618.055	PI
10250	1704825.918	1614619.886	PI
10251	1704649.749	1614624.473	PI
10252	1706143.472	1614636.920	PI
10253	1705175.874	1614637.397	PI
10254	1706085.502	1614638.779	PI
10258	1705731.338	1614660.883	PI
10259	1704851.975	1614668.309	PI
10260	1704614.955	1614676.841	PI
10261	1704638.788	1614681.427	PI
10263	1706145.873	1614711.775	PI
10264	1706087.903	1614713.834	PI
10267	1705219.314	1614747.238	PI
10268	1706141.787	1614748.860	PI
10270	1706522.035	1614755.128	PI
10272	1708275.594	1614760.273	PI
10274	1708210.329	1614761.841	PI
10276	1706049.115	1614781.112	PI
10279	1706115.262	1614800.611	PI
10280	1706398.473	1614802.333	PI
10281	1706523.283	1614813.121	PI
10282	1708278.809	1614818.261	PI
10283	1708211.545	1614819.628	PI
10285	1706078.684	1614832.141	PI
10288	1708437.458	1614845.369	PI
10289	1705209.162	1614854.550	PI
10291	1705204.464	1614858.144	PI
10292	1705902.403	1614860.375	PI
10294	1705269.196	1614884.860	PI
10297	1705244.084	1614907.009	PI
10298	1705929.972	1614911.404	PI
10299	1708468.457	1614943.174	PI
10300	1708410.487	1614945.033	PI
10305	1705878.428	1615005.331	PI
10307	1705338.531	1615018.127	PI
10308	1705303.880	1615023.618	PI
10310	1705720.885	1615032.812	PI
10312	1708471.718	1615044.785	PI
10313	1705648.912	1615054.023	PI
10316	1705763.391	1615074.977	PI
10318	1705685.878	1615079.241	PI
10319	1705326.120	1615082.556	PI
10322	1705322.085	1615085.442	PI
10325	1708415.328	1615095.974	PI
10330	1705420.396	1615137.726	PI
10331	1705481.905	1615165.445	PI
10332	1705389.698	1615188.969	PI
10334	1705577.496	1615203.768	PI
10337	1705429.695	1615213.879	PI
10340	1705544.005	1615233.140	PI
10345	1705619.688	1615251.889	PI
10347	1705586.205	1615281.256	PI

MKEC ENGINEERING CONSULTANTS, INC.
411 N. WEBB ROAD
WICHITA, KS. 67206
316 - 684 - 9600

SANITARY SEWER PLANS
FOX RIDGE
PHASE 9

BUBBLE MAP
SHEET TITLE

468-84202
PROJECT NUMBER

DFL
DESIGN BY

MKEC
DRAWN BY

GJA
CHECKED BY

ISSUED
JULY 06

REVISED

SHEET NO.
13 of 14

G:\CIVIL\99118\dwg\SAN\Proj\Bubble

MKEC ENGINEERING CONSULTANTS, INC. © COPYRIGHT

PLOTTED: Friday, July 07, 2006 @ 10:12AM