

VERTICAL RISER DETAILS

ADOPTED AS STANDARD DESIGN

BY

CITY OF WICHITA, KANSAS

JANUARY 2001



GENERAL NOTES

- RISERS.** Risers shall be installed to serve all lots or tracts where the sanitary sewer main is below the water table. Risers shall also be installed to serve all lots and tracts where the sanitary sewer main depth is greater than 12 feet below the proposed ground elevation. Installation of risers because of field conditions shall be as approved by the Construction Engineer. The location of the risers to serve developed property shall be approved by the property owner and the Construction Engineer.
- PIPE STUBS.** Pipe stubs shall be installed in manholes where locations of manholes will provide satisfactory service connection as determined by the Construction Engineer. The vertical distance between the flowline of the manhole pipe stub and the flowline of the sanitary sewer main out of the manhole shall not exceed 2 feet. Risers shall be utilized at manhole pipe stubs as indicated in Note 1. Manhole pipe stubs shall be set such that the top of the stub is not lower than the top of the sanitary sewer main.
- SIZING.** Pipe stubs and risers shall be sized according to the plans and riser table where risers are indicated by the plans. Where risers or pipe stubs are required because of field conditions, the risers and stubs shall be six-inch diameter for commercial or industrial properties and 4" or 6" diameter for residential properties, based on lot size and sanitary sewer main depth. Sizing of risers and stubs shall be approved by the Construction Engineer prior to installation.
- RISER OR STUB MATERIAL.** Risers and stubs shall be constructed of Schedule 40 PVC Pipe, meeting the requirements of the latest revision of A.S.T.M. All pipe joints shall be solvent welded.
- REINFORCED CONCRETE ENCASUREMENT.** Riser connections to clay pipe sanitary sewers shall be reinforced concrete encased both ways from the riser centerline. The reinforced concrete encasement shall extend three feet from the riser centerline or stop at the first sanitary sewer pipe joint within three feet of the riser centerline. Riser connections to PVC Sanitary Sewer mains shall be reinforced concrete encased one foot each way from the riser centerline. The concrete encasement shall be reinforced using reinforcing steel as shown in the appropriate drawing. The concrete shall conform to the City Standard Specifications for concrete pavement.
- BEDDING.** Bedding around the sanitary sewer riser shall be compacted Pipe Bedding Type 1 or 2. The bedding shall be placed and compacted from the depth of the sanitary sewer main to the top of the sanitary sewer riser pipe. Compacted Pipe Bedding Type 1 or 2 shall be required for all risers whether constructed in vertical wall or sloped wall trenches. Bedding material and construction practices shall be approved by the Construction Engineer prior to installation.
- SUPPORT OF RISERS.** Sanitary sewer riser pipe shall be supported during trench backfill. The riser pipe shall be held in a vertical position at all times until trench backfill and compaction has been completed. Contractor's methods for supporting and backfilling the riser pipe shall be approved by the Construction Engineer.
- PLUGGING.** The ends of the riser pipes and manhole stubs shall be plugged using an airtight solvent welded cap or plug. Cap or plug fittings shall be approved by the Construction Engineer prior to installation. Caps or plugs which do not provide an airtight seal will not be accepted.
- TOP OF THE RISER PIPE.** The top elevation of the sanitary sewer riser pipe shall be built per plan elevations, unless otherwise directed by the Construction Engineer. Where riser elevations are not shown on the plans, the top of the risers shall be set at an elevation four feet below the proposed ground surface. If ground water is encountered, the top of the riser pipe shall be set at an elevation two feet (min.) above the maximum water table elevation, regardless of the riser elevation shown on the plans.
- MARKING.** Locations of the ends of the sanitary sewer riser pipe shall be marked by fastening green colored plastic tape to the end of the riser. The tape shall be supported by a length of wooden 2" x 4", extending from the top of the riser pipe to the proposed ground surface. The green tape shall be visible and extend one foot above the proposed ground surface. The green tape shall be 4 mil Polyethylene film with a minimum width of three inches, specifically manufactured for the purpose of identification of underground sewers.
- LOCATION MEASURES.** The project inspector shall record and document the location of all risers constructed as measured from the nearest manhole, indicating the direction from the manhole, the direction and distance from the main, riser size, and elevation of the top of the riser.
- RISER LOCATION.** The riser shall be located per plan if shown. If not shown on the plan, the riser shall be located at the center of the lot, within one foot of the property side of the easement for the lot being served. All riser locations shall be approved by the Construction Engineer prior to installation.
- PAYMENT.** "Sanitary sewer risers" shall be paid for at the contract unit price per each, which price shall be full compensation for all pipe, fittings, marking tape, length of wooden 2" x 4, reinforced concrete encasement, support during backfill, backfill, labor, site restoration, and any other items necessary to complete the work.
"Manhole stubs" shall be paid for at the contract unit price per each, which shall be full compensation for all labor, material, and incidentals necessary to complete the work, including all pipe, fittings, reinforced concrete encasement, and all other items as required and listed for "Sanitary Sewer Risers".


SEWER SERVICE TABLE							
NO.	TYPE	LOCATION				FOR INFORMATION ONLY	
		LOT NO.	BLOCK	LINE NO.	STATION/ DIRECTION	APPROXIMATE LENGTH 4" PIPE	
						VERTICAL	HORIZONTAL
1	TEE SERVICE CONNECTION	56	1	1	10+12.9/LT.	14.4' 6"	13' 12.5'
2	TEE SERVICE CONNECTION	55	1	1	11+13.9/LT.	16.7' 7"	14' 11.1'
3	TEE SERVICE CONNECTION	54	1	1	12+08.5/LT.	09.8' 7"	8' 12.2'
4	MH CONNECTION	53	1	1	13+08.8/LT.	04.0' 7"	13' MH Connection
5	TEE SERVICE CONNECTION	52	1	1	14+07.1/LT.	04.3' 7"	6'
6	TEE SERVICE CONNECTION	51	1	1	15+10.2/LT.	10.3' 7"	18' 11'
7	MH CONNECTION	50	1	1	15+34.1/LT.	41.0' 8"	1' MH Connection
8	TEE SERVICE CONNECTION	1	2	2	10+59.0/LT.	4'	18' 19.7'
9	TEE SERVICE CONNECTION	2	2	2	11+53.2/LT.	51.7' 4"	15'
10	TEE SERVICE CONNECTION	3	2	2	12+48.7/LT.	48.9' 5"	14' 13.7'
11	TEE SERVICE CONNECTION	4	2	2	13+45.4/LT.	46.8' 5"	14'
12	TEE SERVICE CONNECTION	35	1	4	12+35.0/RT.	31.7' 5"	14'
13*	TEE SERVICE CONNECTION	43	1	EX.	10+39.0/LT.	11'	20' 23.5'
14*	TEE SERVICE CONNECTION	47	1	EX.	13+90.0/LT.	12'	20' 12.4'

Note: Risers #13 #14 added to existing lines.
Riser #13 installed on 468-83788 (Lat. 366 FMC)
Riser #14 installed on 468-83789 (Lat. 366 FMC)


TYPICAL PLAN VIEW

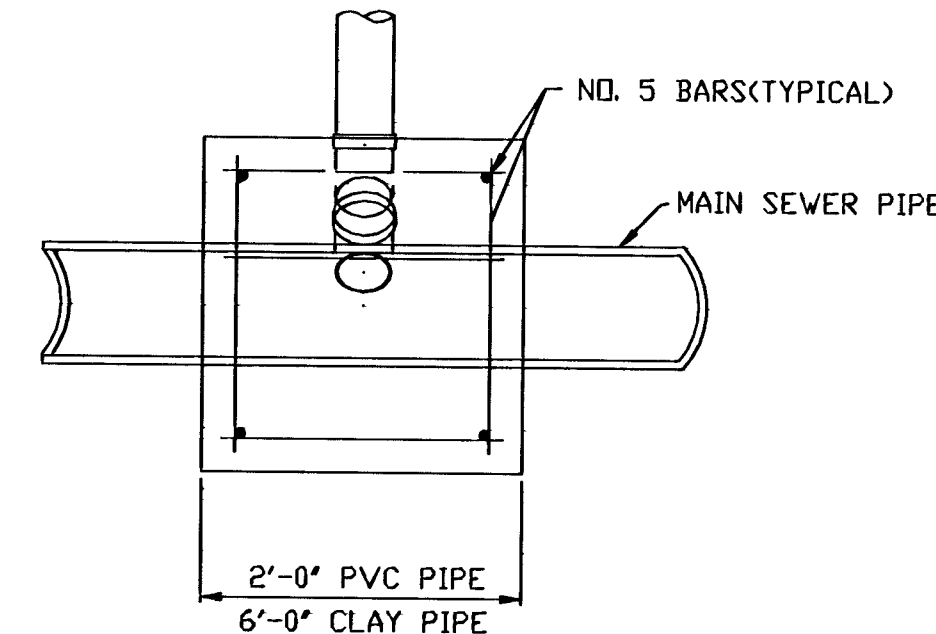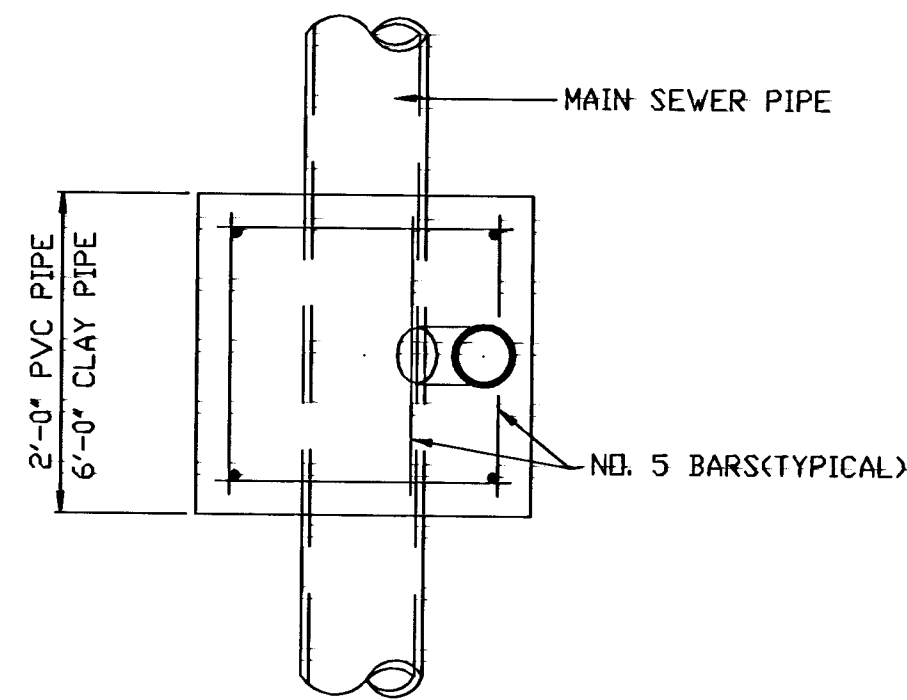


TYPICAL SECTION X-X

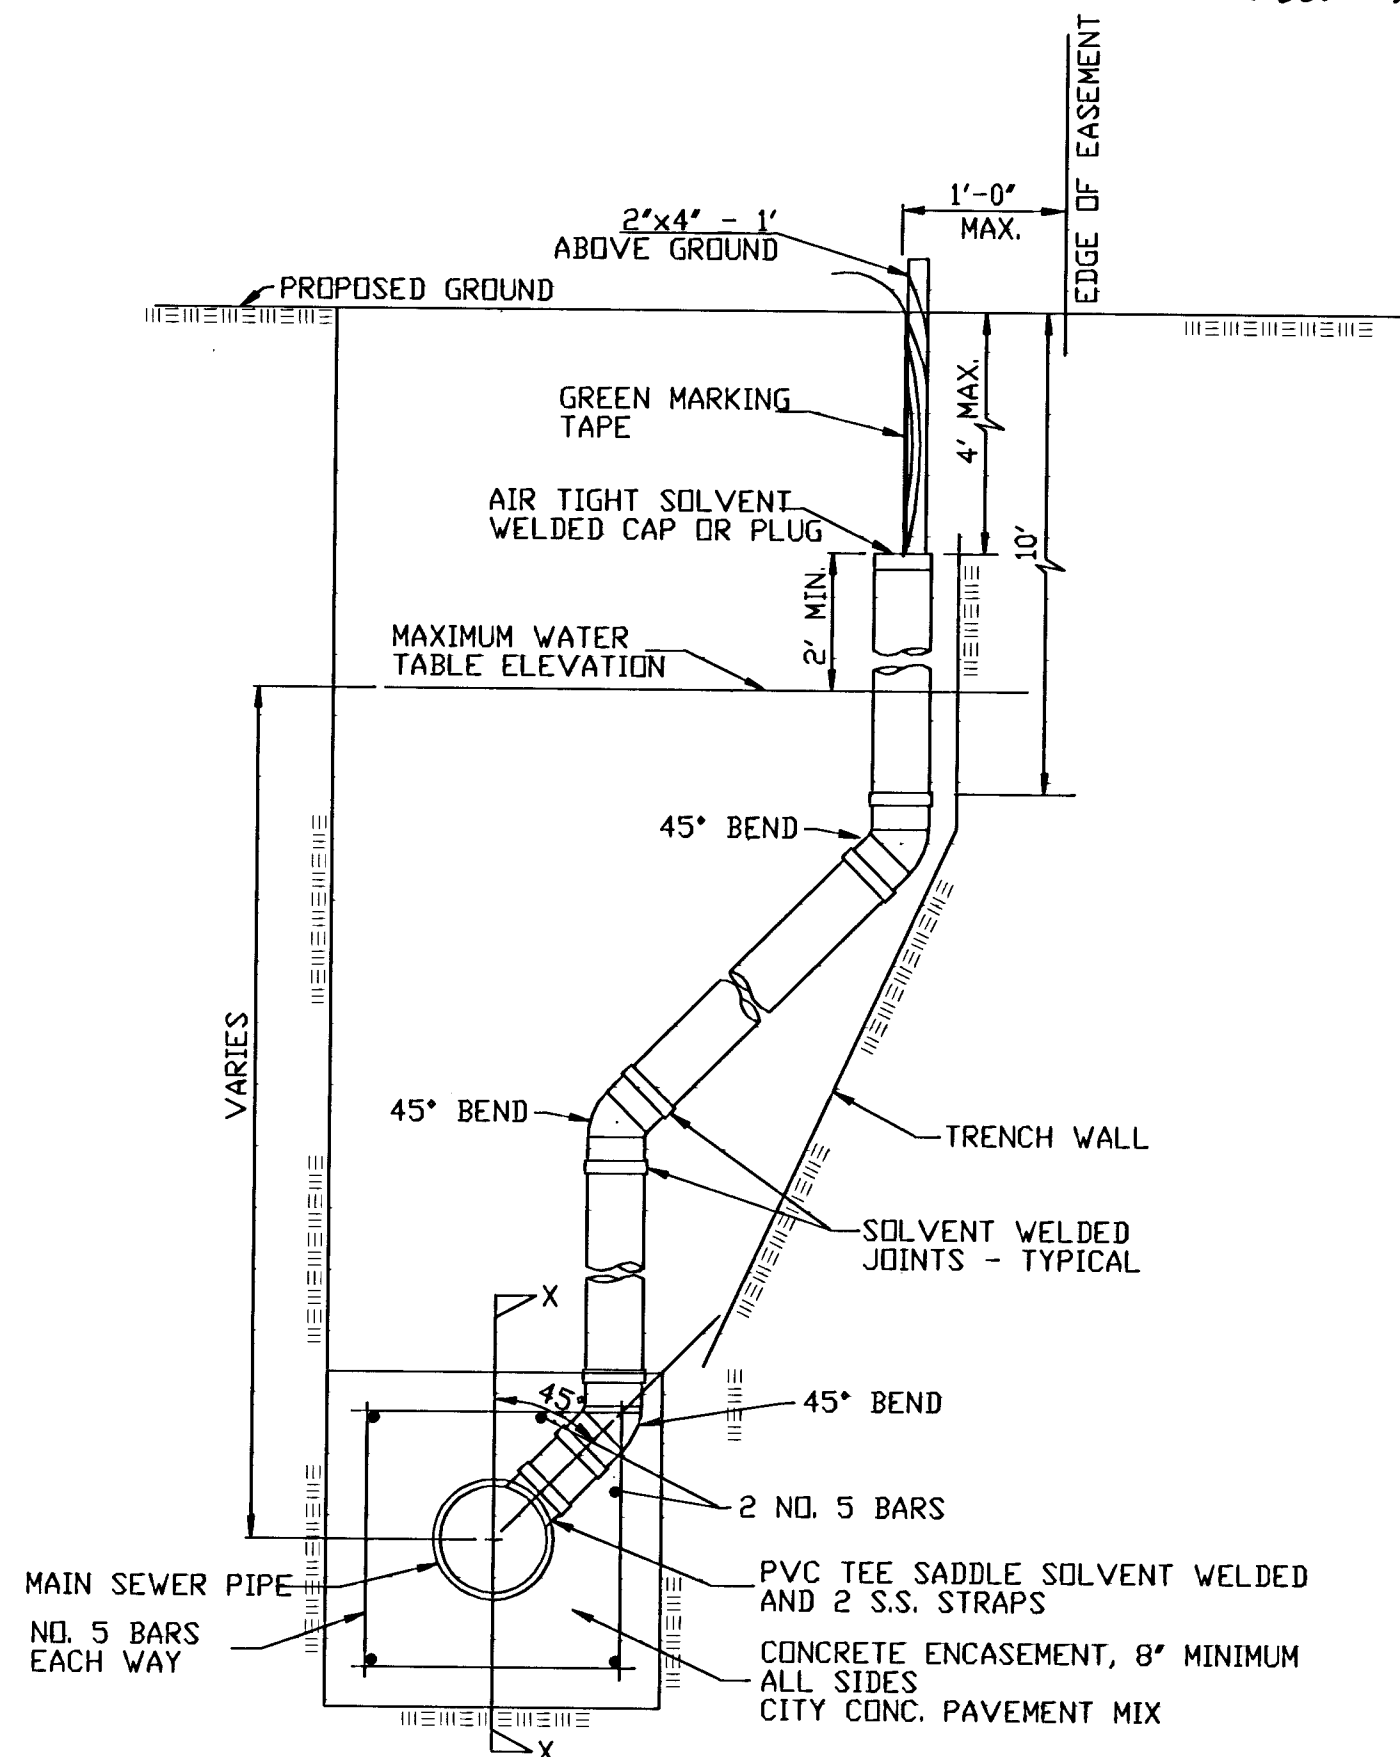

METHOD 'A'

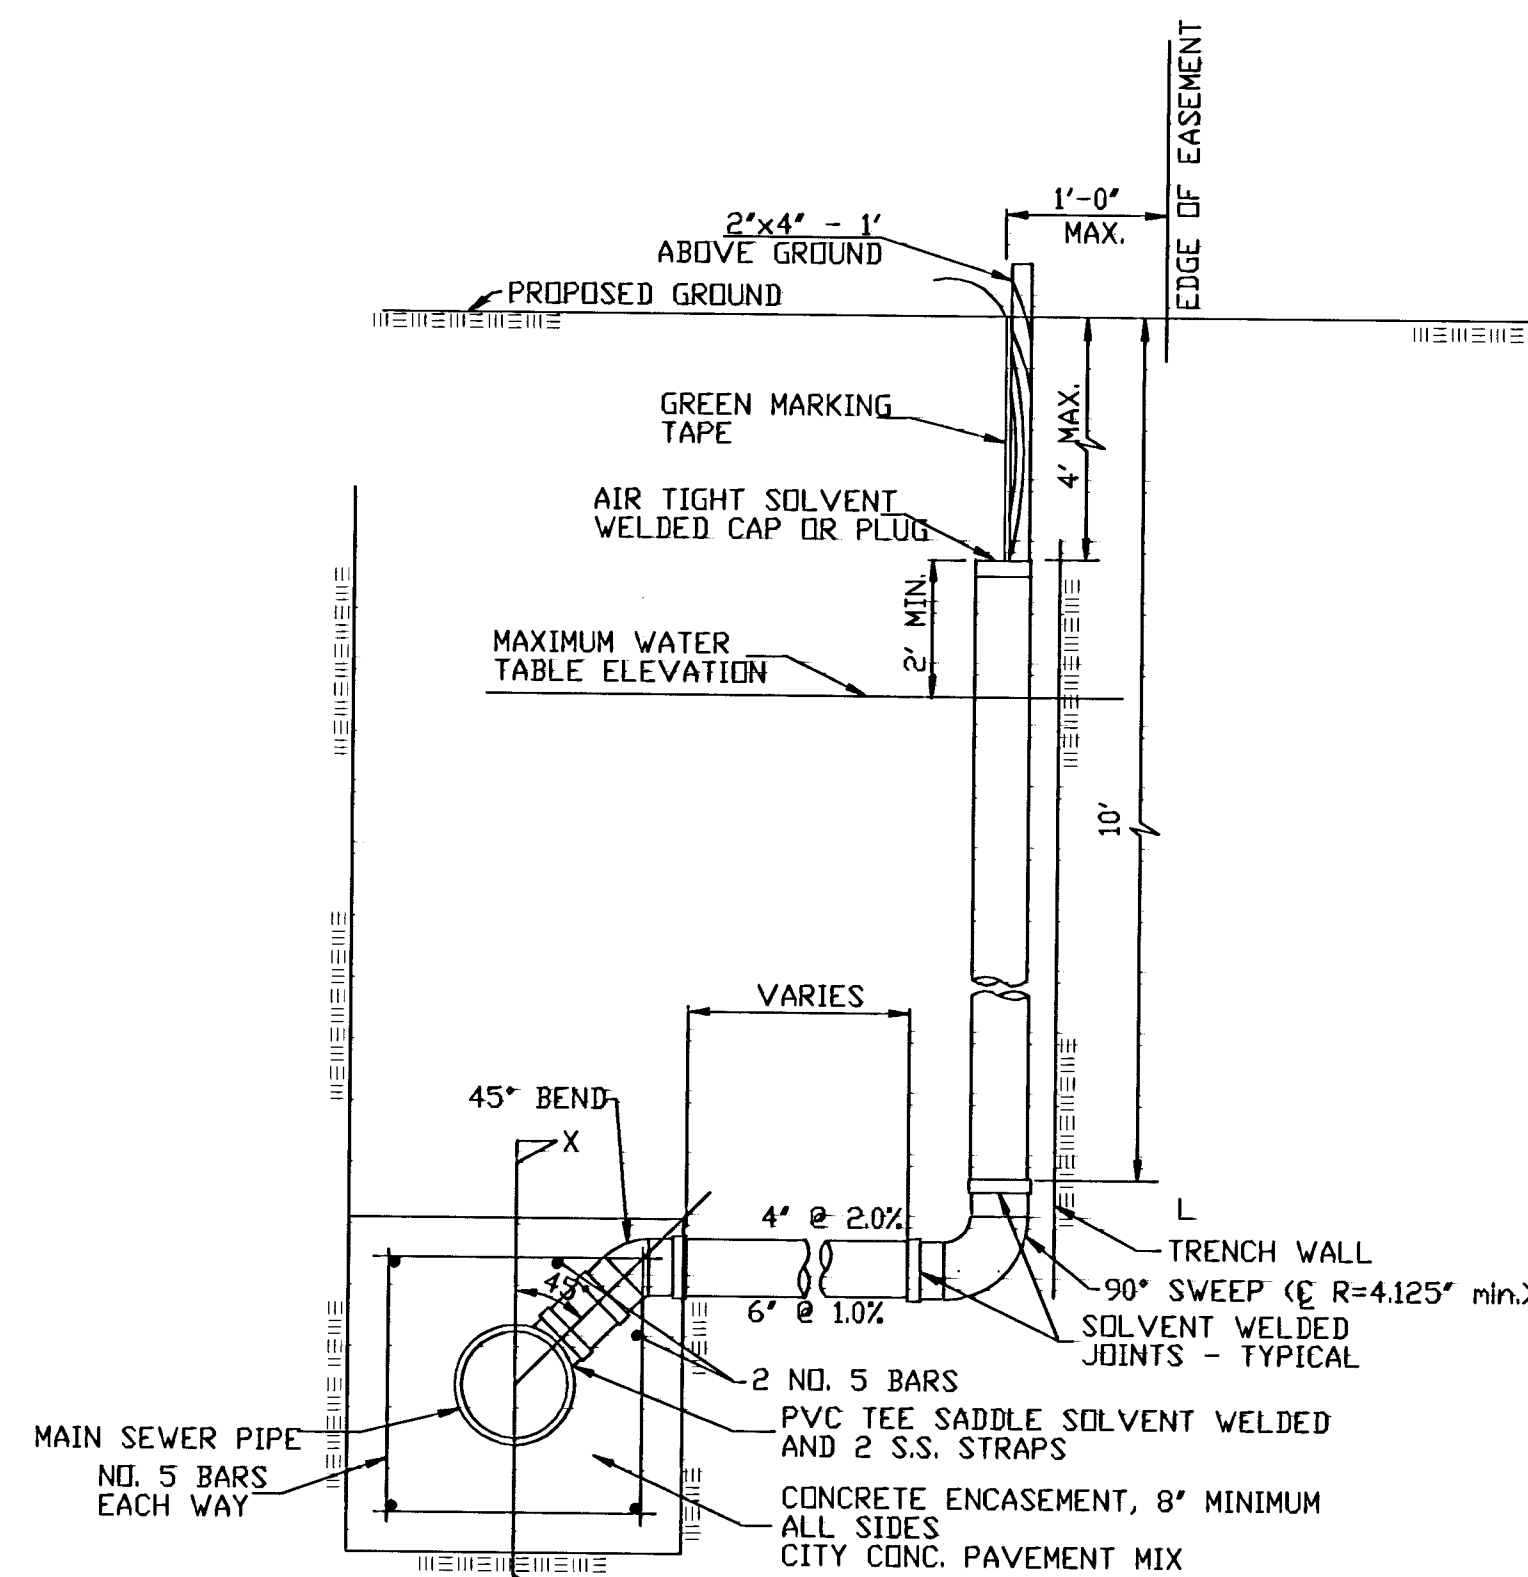

METHOD 'B'

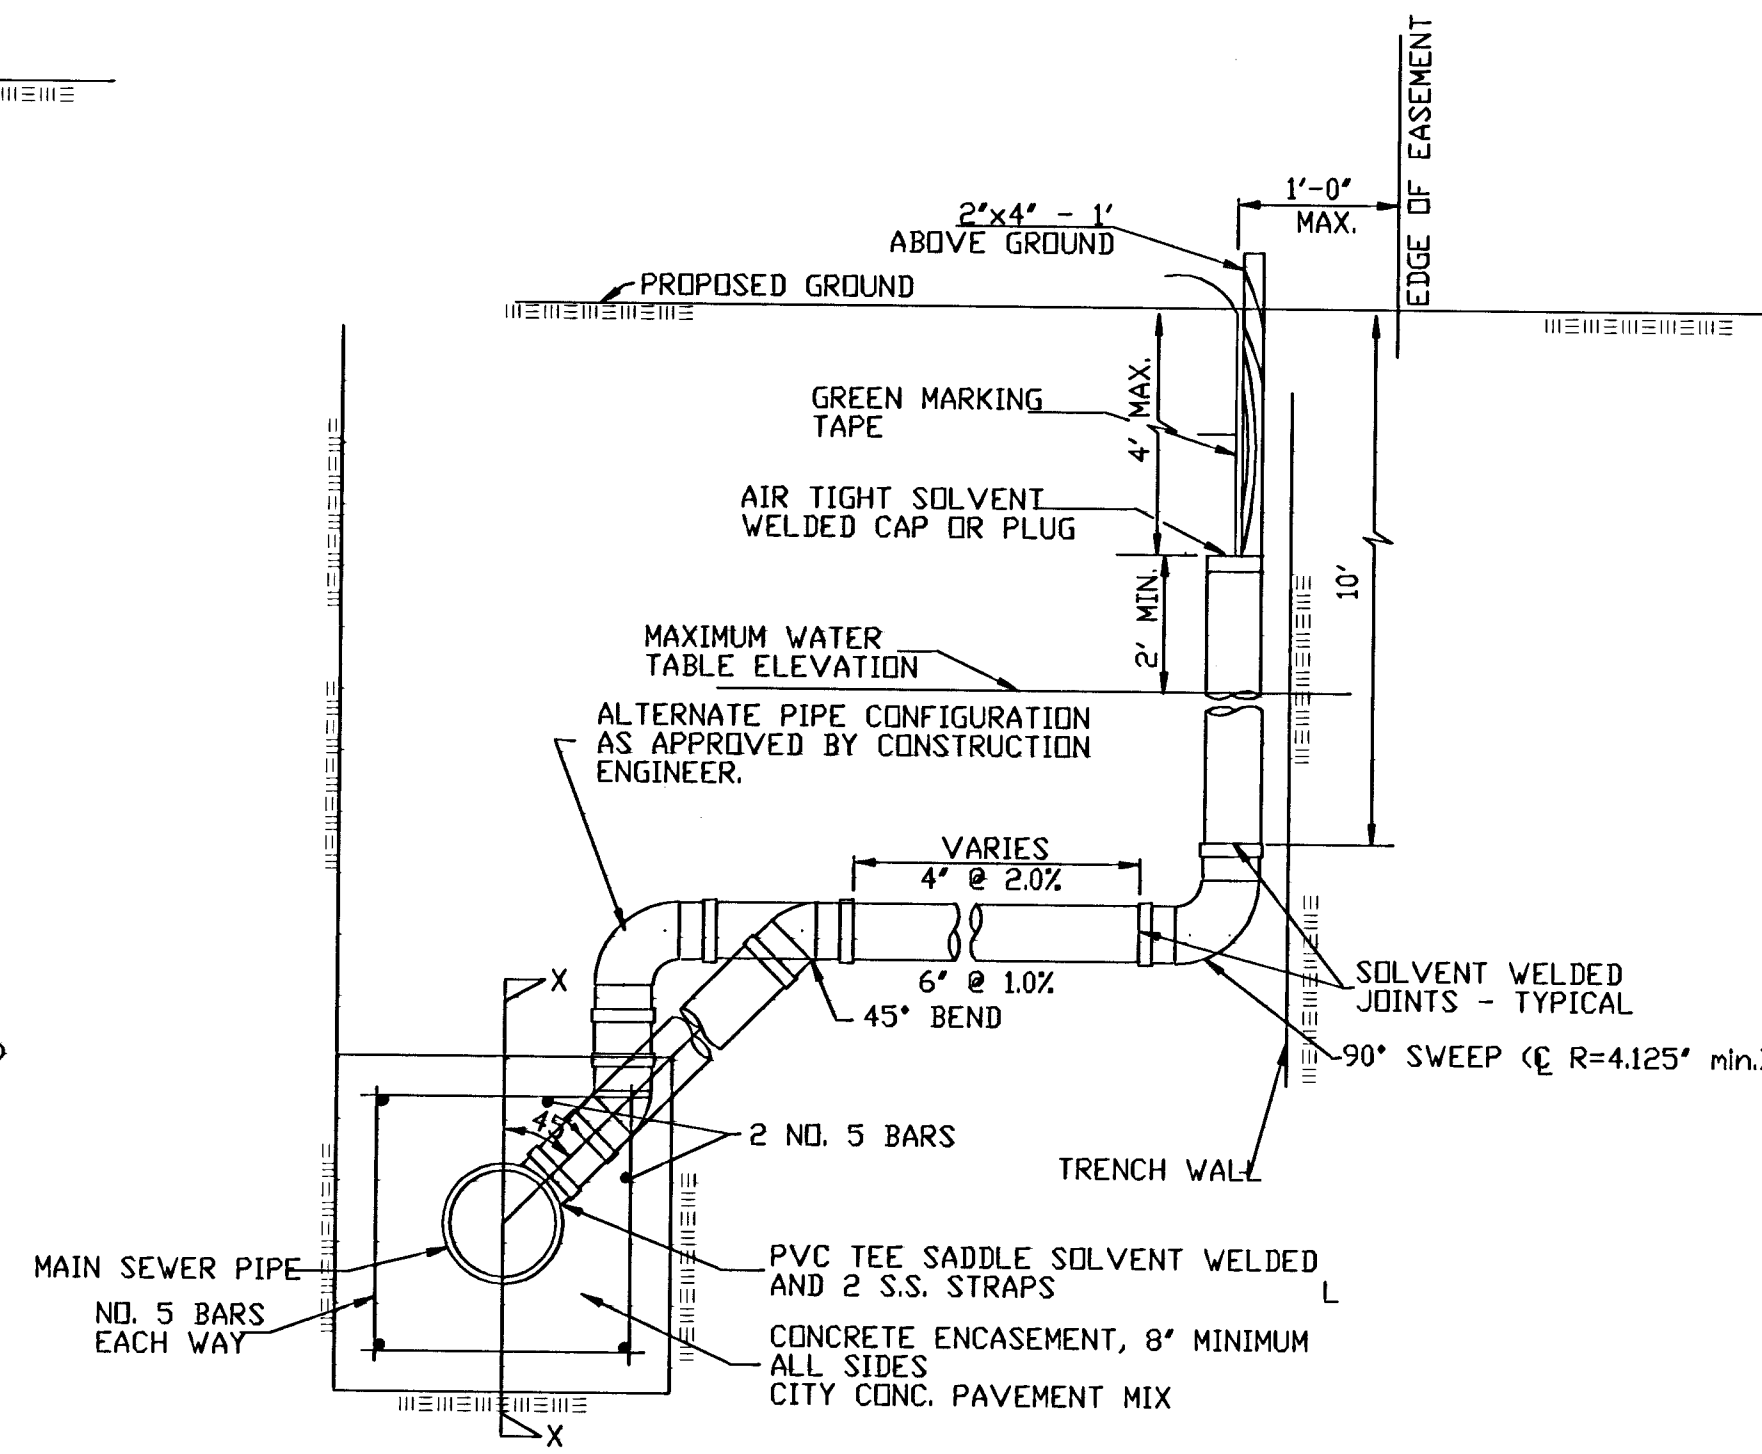

METHOD 'C'

NOTE: RISER PIPE REQUIREMENTS AT MANHOLE STUBS SHALL BE SIMILAR TO THOSE SHOWN ABOVE.

REV. 1/05/01, MCG

THE CITY OF WICHITA CITY ENGINEER'S OFFICE CITY HALL - SEVENTH FLOOR 455 NORTH MAIN STREET WICHITA, KANSAS 67202 (316) 268-4501 (316) 268-4114 FAX		VERTICAL RISER DETAIL JIM ARMOUR, P.E. - CITY ENGINEER <table border="1"> <tr> <td>PROJECT NUMBER</td> <td>INDEX CODE</td> </tr> <tr> <td>468-83874</td> <td>744187</td> </tr> <tr> <td>DATE</td> <td>SHEET NUMBER</td> </tr> <tr> <td>JUNE 2006</td> <td>3 / 10</td> </tr> </table>		PROJECT NUMBER	INDEX CODE	468-83874	744187	DATE	SHEET NUMBER	JUNE 2006	3 / 10
PROJECT NUMBER	INDEX CODE										
468-83874	744187										
DATE	SHEET NUMBER										
JUNE 2006	3 / 10										