



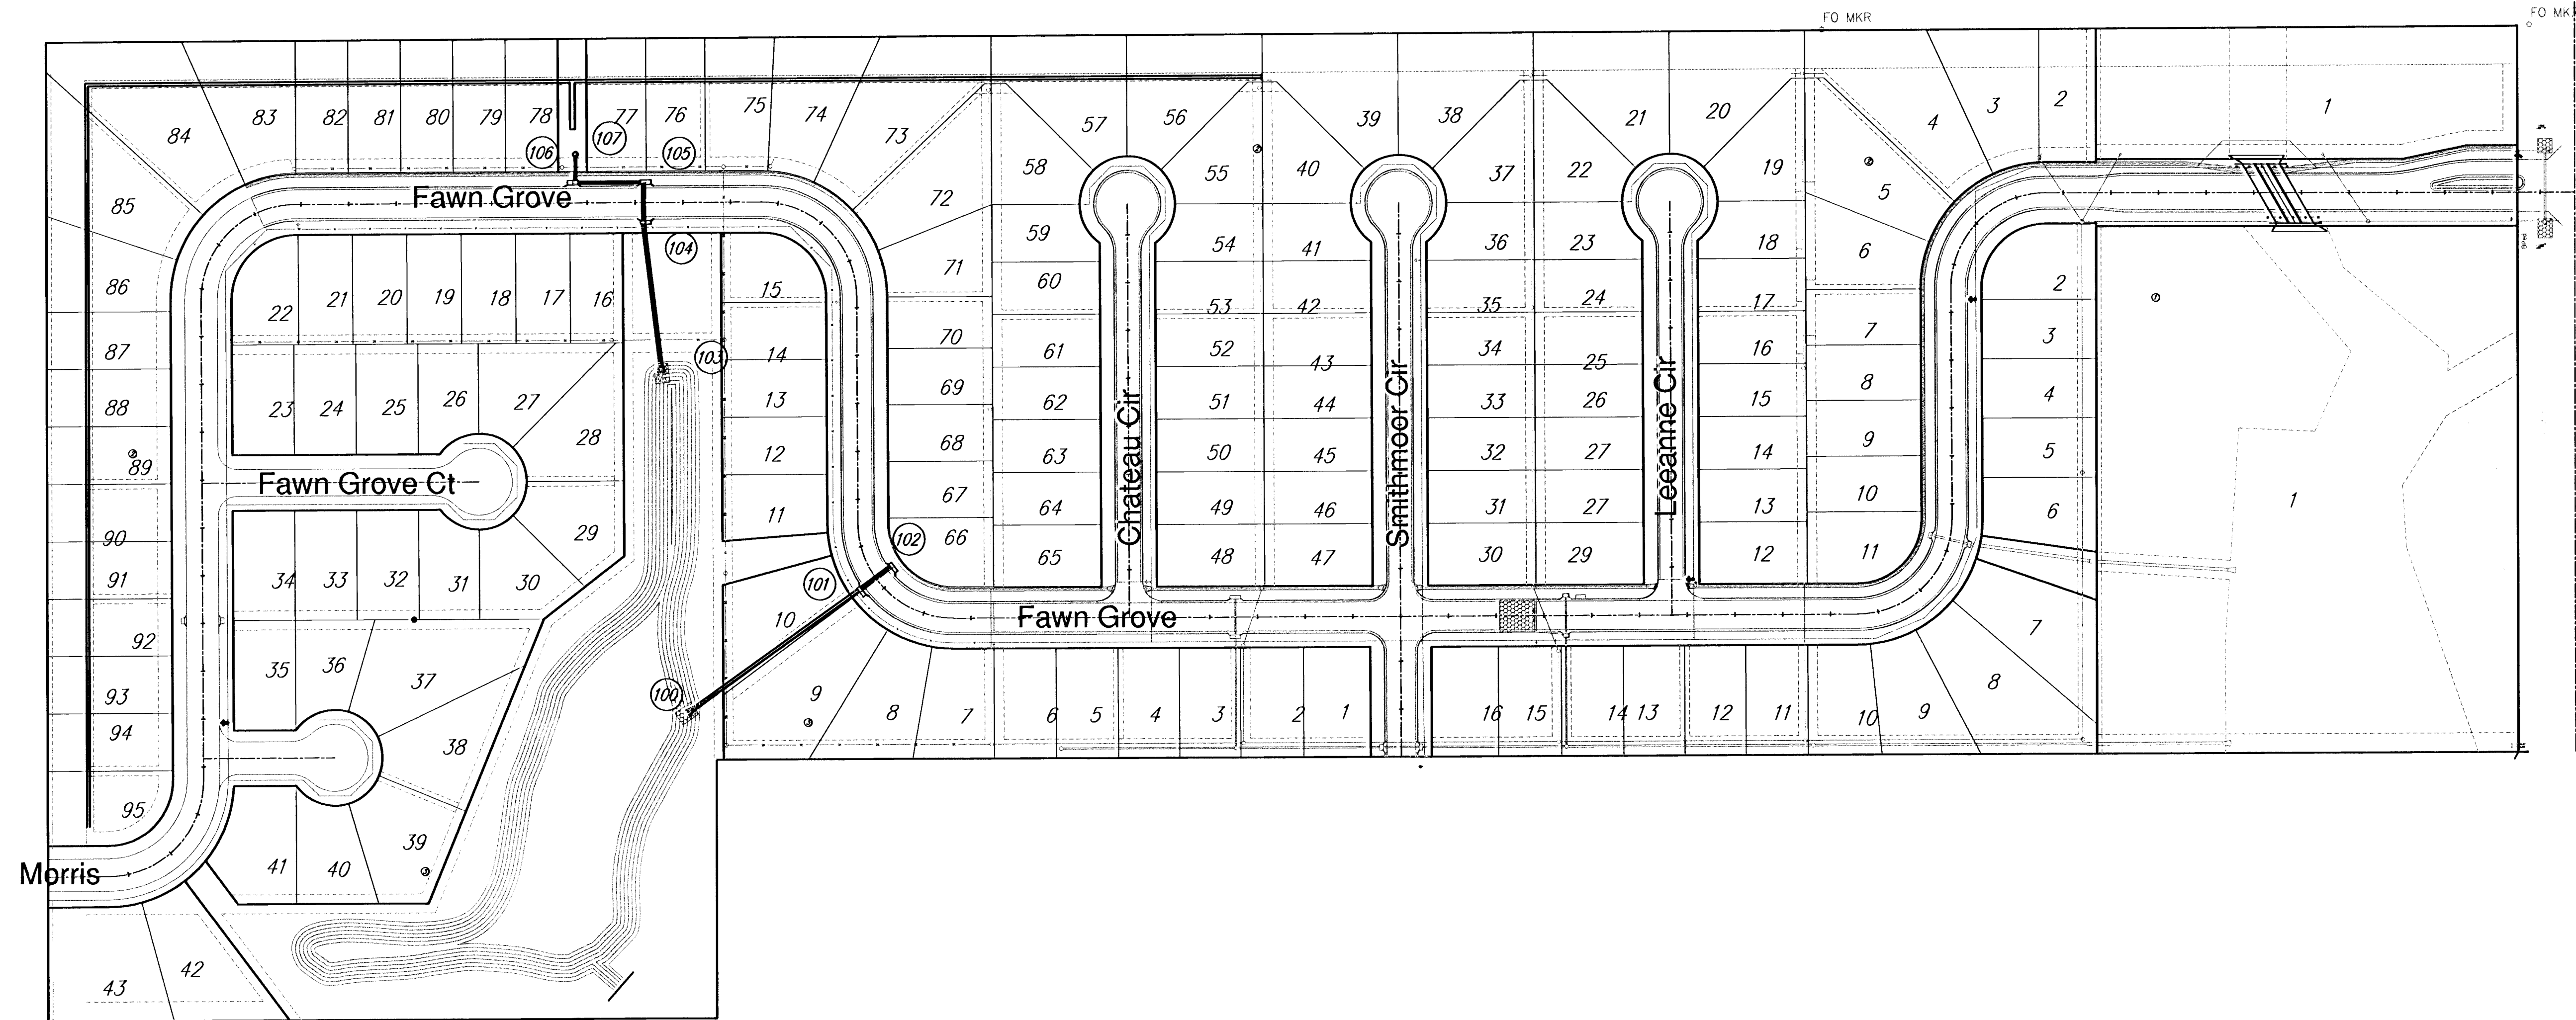

SCALE 1" = 100'

100	N 20379.46	E 18008.89	0+28.06 End Section Line 1
101	N 20507.09	E 18192.12	2+50 Type 1A FIF Line 1
102	N 20529.74	E 18222.44	2+90.81 Type 1A FIF Line 1
103	N 20735.56	E 17981.72	0+28.06 End Section
104	N 20893.91	E 17965.33	2+00 Type 1A FIF Line 2
105	N 20932.25	E 17965.21	2+40.68 Type 1A FIF Line 2
106	N 20932.00	E 17889.19	3+16.69 Type 1A FIF Line 2
107	N 20963.18	E 17891.96	3+46.69 MH Line 2

Fawn Grove Addition
Project Bubble Map
WICHITA, KANSAS

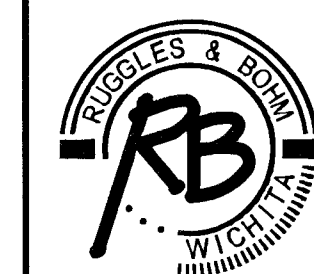

Ruggles & Bohm, P.A.
Engineering, Surveying, Land Planning
924 North Main (318) 264-8008
Wichita, Kansas 67203 (318) 264-4821 fax
www.rbkansas.com E-mail: info@rbkansas.com

DRAWING FILE
SWS {Project Bubble Map}

PROJECT NUMBER
472-84408

DATE
April 27, 2008

DESIGN E.J.G.
DRAWN E.J.G.
REVIEW
UTILITY

SHEET
15
OF
24