

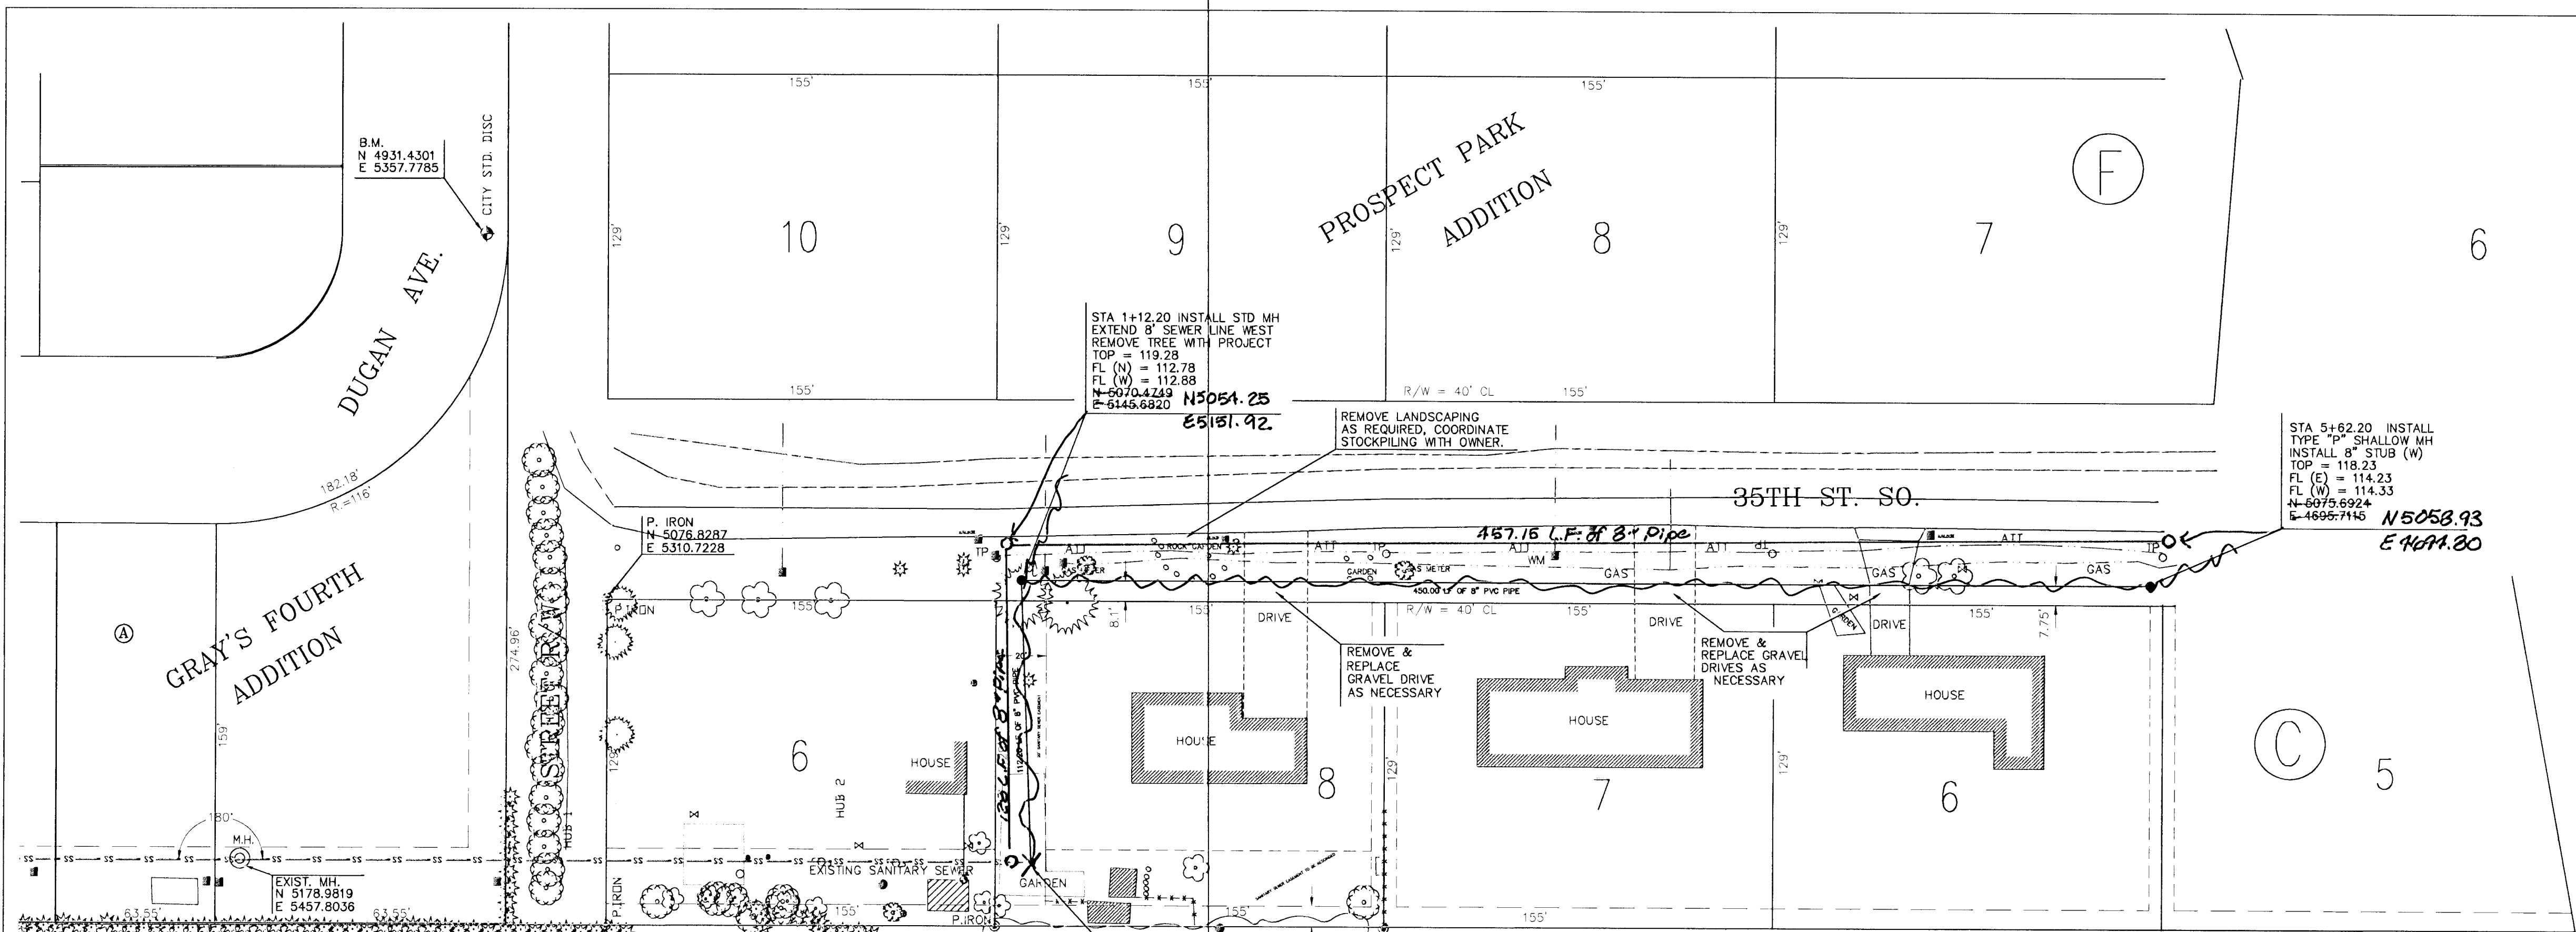


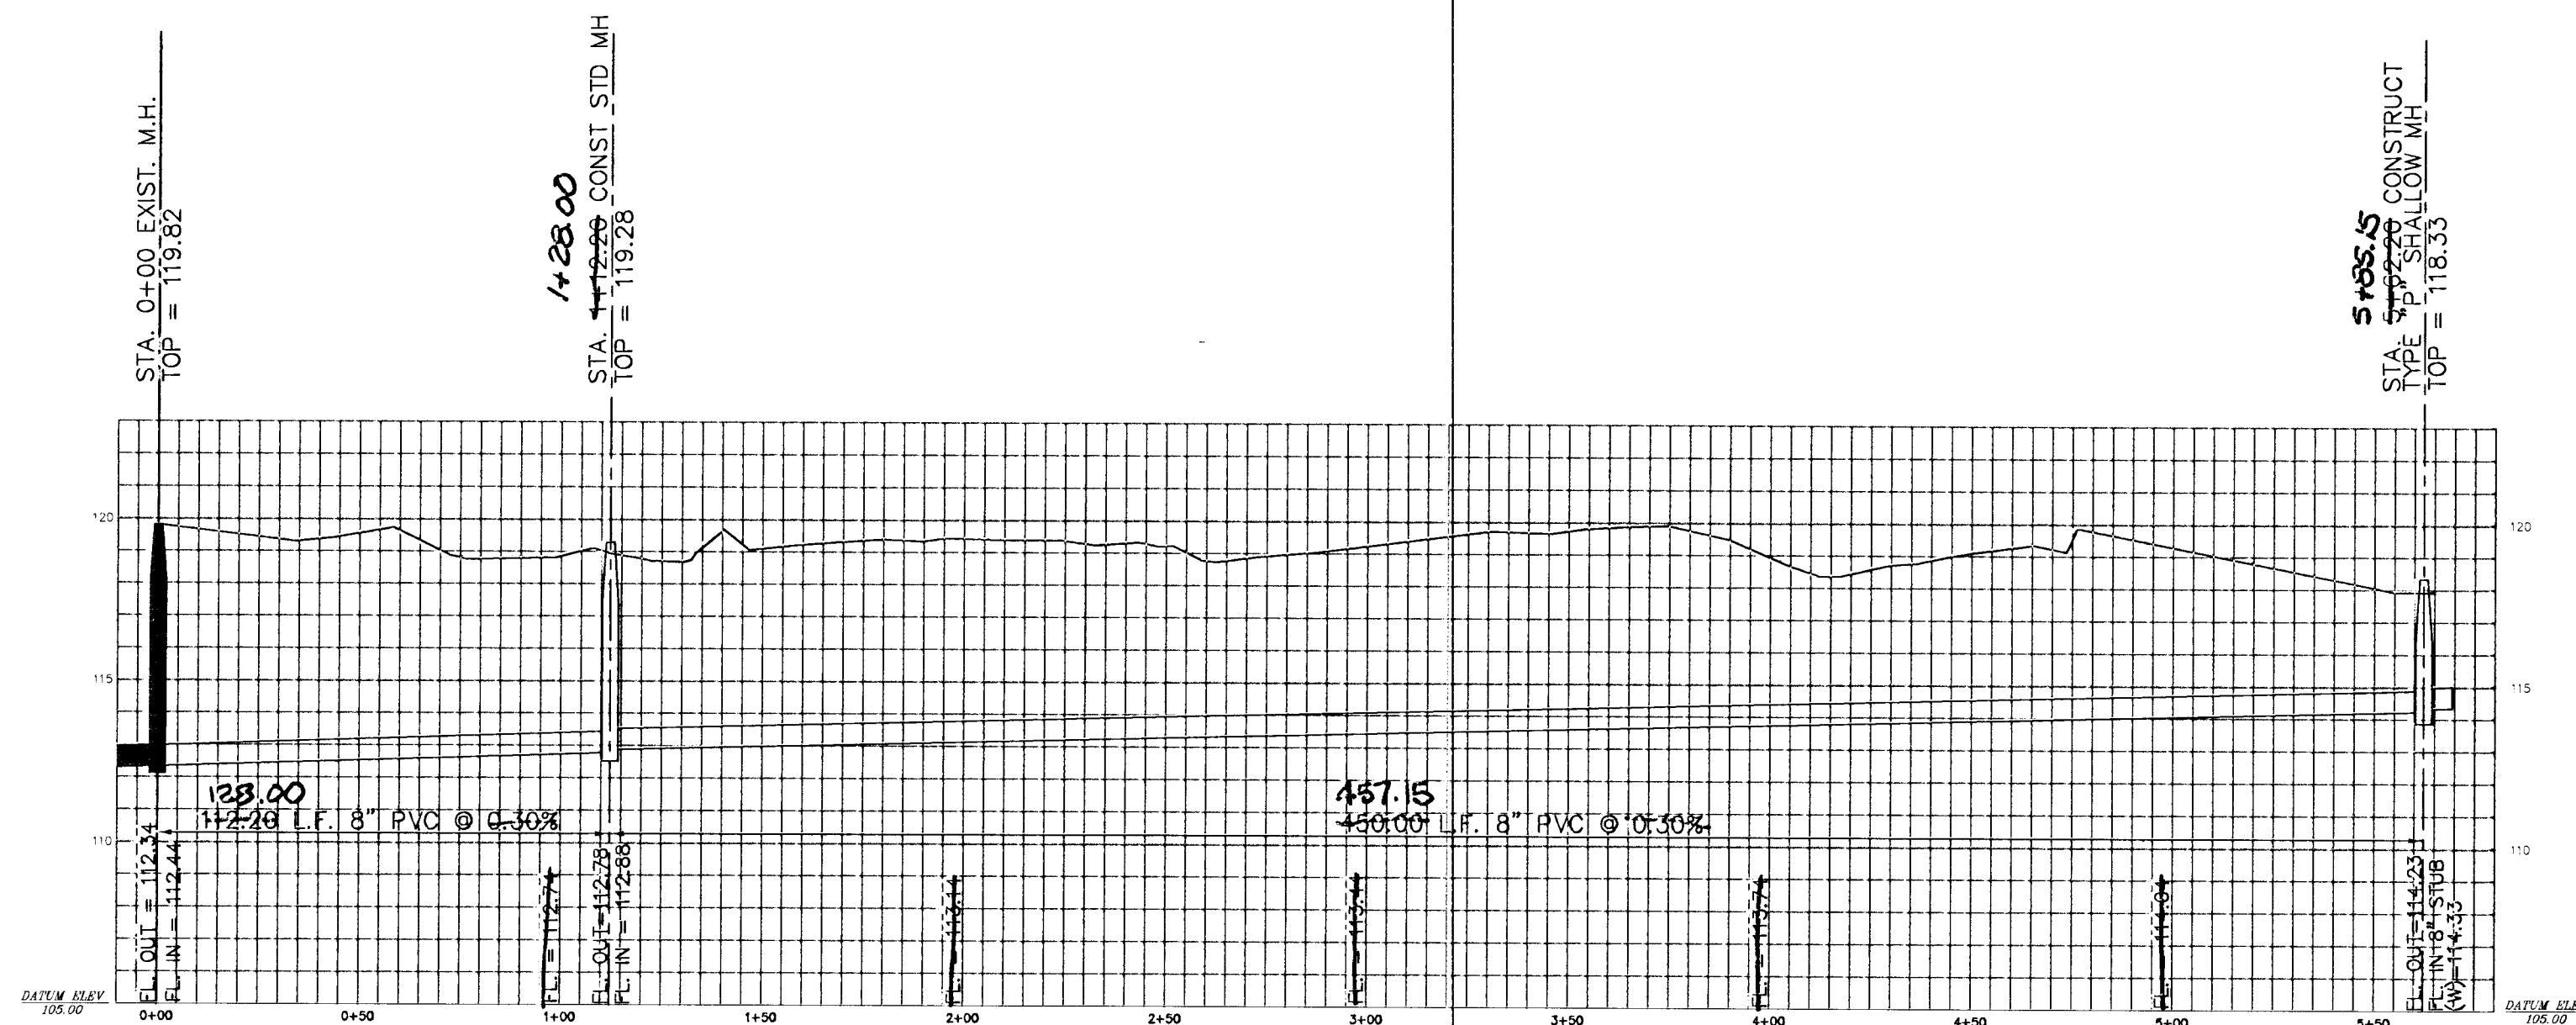

SCALE: PLAN 1" = 40'
 PROFILE HORZ. 1" = 40'
 VERT. 1" = 5'

BM. CITY STD. DISC, 38 FT. EAST AND 27.5 FT. NORTH OF CENTERLINE OF RIDGE ROAD AND 35TH ST. SOUTH ELEVATION = 121.65

BM. CITY STD. DISC, 23 FT. WEST AND 81.5 FT. SOUTH OF CENTERLINE OF DUGAN ROAD AND 35TH ST. SOUTH ELEVATION = 119.56

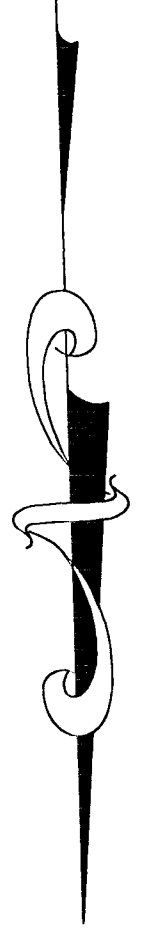

LAT 506, SOUTHWEST INTERCEPTER SEWER

CITY ENGINEER JAMES L. ARMOUR, P.E.		
PROJECT NUMBER 468-83953	DCA NUMBER 744107	DATE 10/06
CITY ENGINEER'S OFFICE CITY HALL - SEVENTH FLOOR 455 NORTH MAIN STREET WICHITA, KANSAS 67202-1620 (316) 268-4501 (316) 268-4114 FAX		DESIGN YOUNKIN DRAWN LONG SHEET 2 OF 5