


BENCHMARK:
Arkansas River bridge & 63rd St. S. City of
Wichita Benchmark Disc. SW Cor. of bridge,
top of hubguard, 500'± E. of Grove.
Elev. = 1269.95 NGVD29 (per City record)


Brass plate on the NE wingwall of Arkansas
River bridge & 63rd St. S.
Elev. = 1267.48 NGVD29 (per County record)

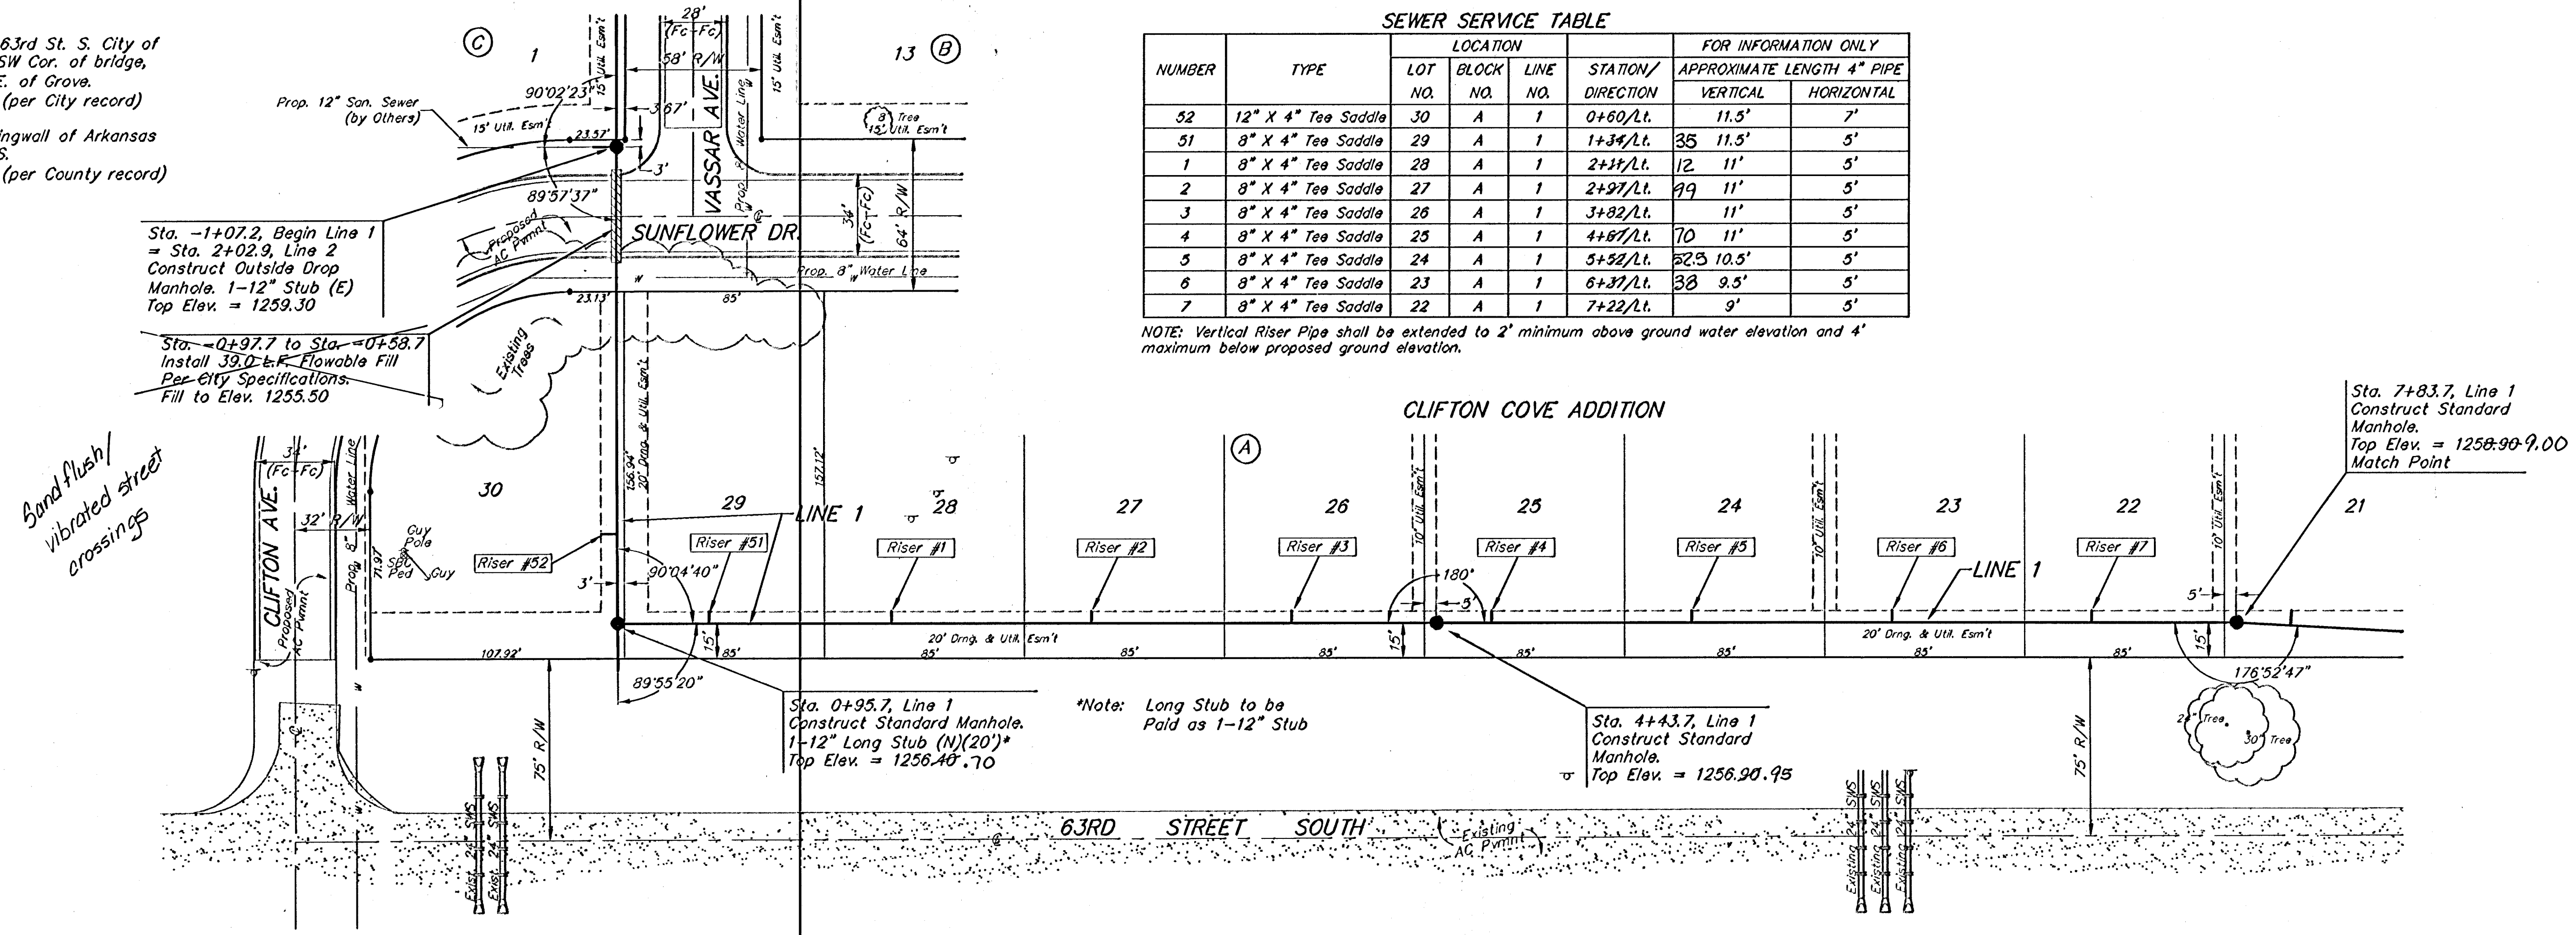

SEWER SERVICE TABLE						
NUMBER	TYPE	LOCATION			FOR INFORMATION ONLY	
		LOT NO.	BLOCK NO.	LINE NO.	STATION/DIRECTION	APPROXIMATE LENGTH 4" PIPE
52	12" X 4" Tee Saddle	30	A	1	0+60/Lt.	11.5' 7'
51	8" X 4" Tee Saddle	29	A	1	1+34/Lt.	35 11.5' 5'
1	8" X 4" Tee Saddle	28	A	1	2+41/Lt.	12 11' 5'
2	8" X 4" Tee Saddle	27	A	1	2+97/Lt.	49 11' 5'
3	8" X 4" Tee Saddle	26	A	1	3+82/Lt.	11' 5'
4	8" X 4" Tee Saddle	25	A	1	4+87/Lt.	70 11' 5'
5	8" X 4" Tee Saddle	24	A	1	5+52/Lt.	52.5 10.5' 5'
6	8" X 4" Tee Saddle	23	A	1	6+37/Lt.	38 9.5' 5'
7	8" X 4" Tee Saddle	22	A	1	7+22/Lt.	9' 5'

NOTE: Vertical Riser Pipe shall be extended to 2' minimum above ground water elevation and 4' maximum below proposed ground elevation.

SCALE:
1" = 40' HORIZONTAL
1" = 5' VERTICAL
• = IRON

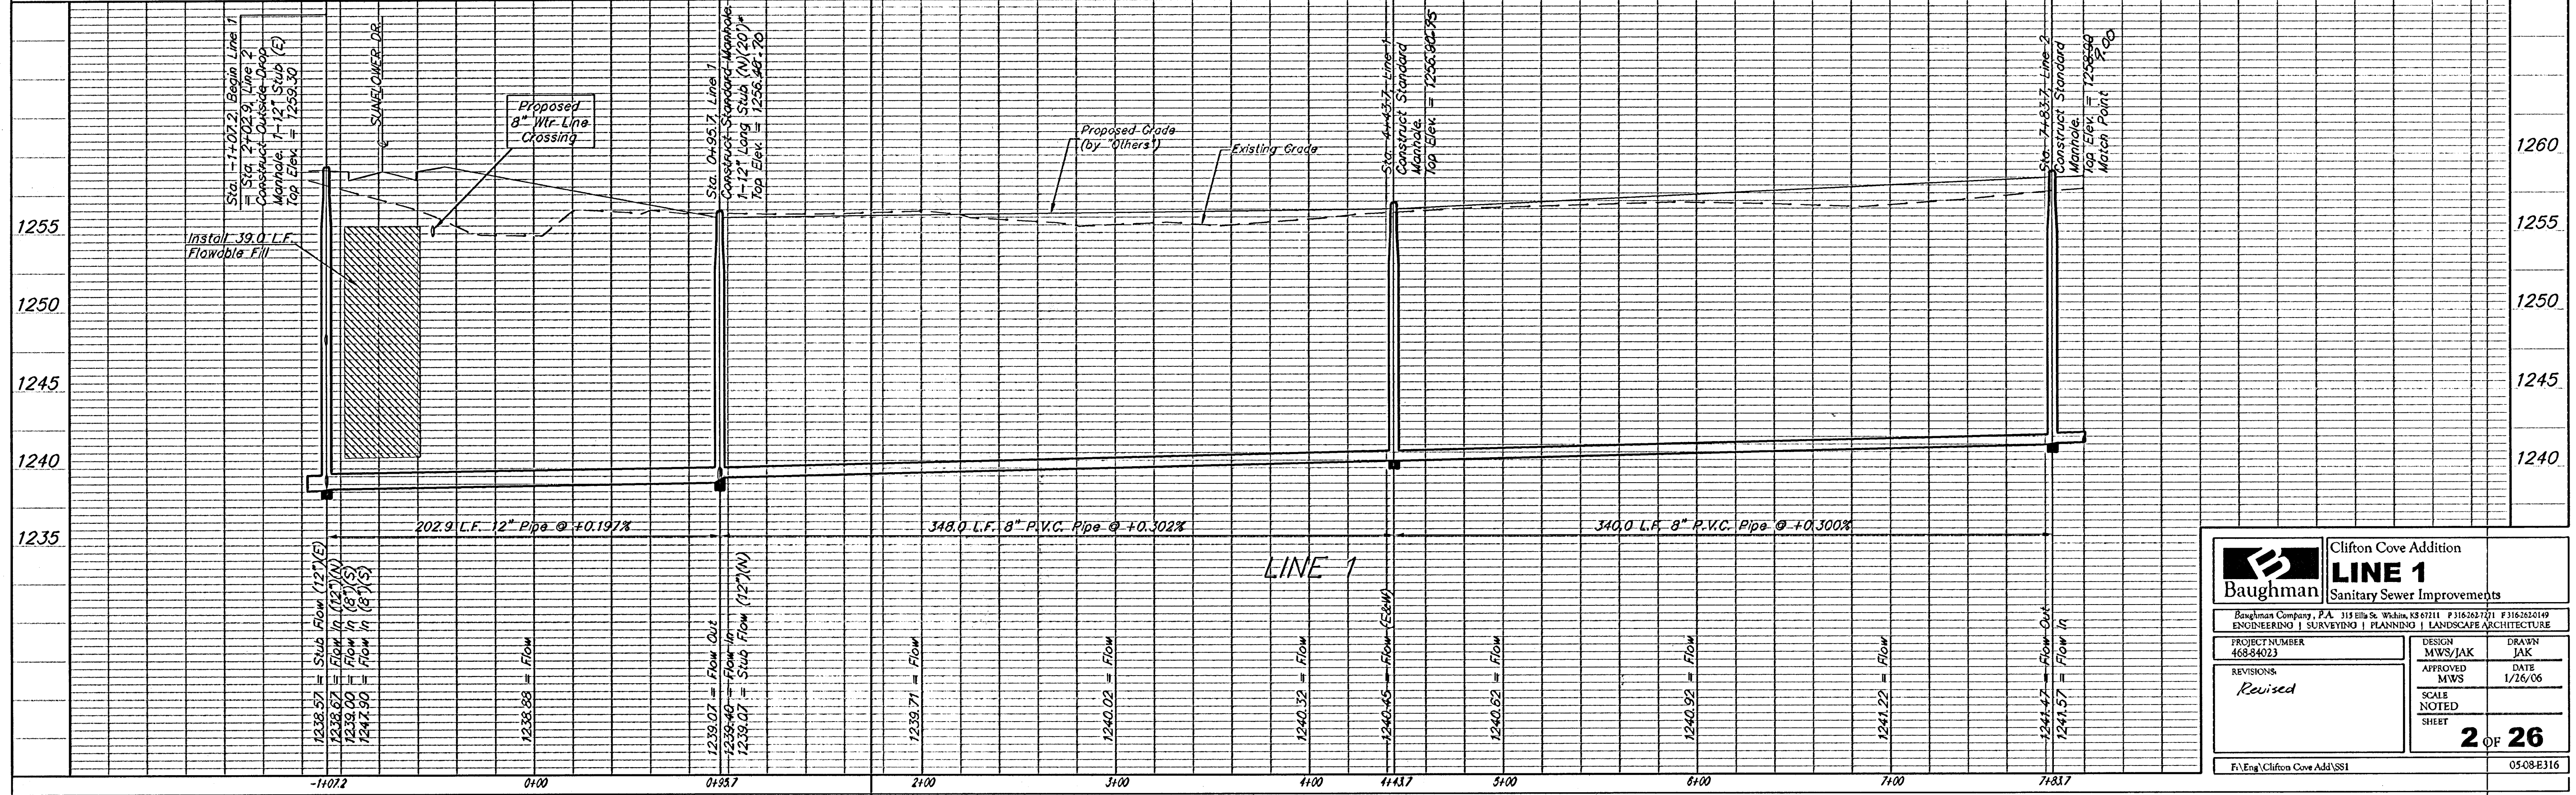

Baughman

Clifton Cove Addition
LINE 1
Sanitary Sewer Improvements

Baughman Company, P.A. 315 Ellis St. Wichita, KS 67211 P 3162627211 F 3162620149
ENGINEERING | SURVEYING | PLANNING | LANDSCAPE ARCHITECTURE

PROJECT NUMBER
468-84023

DESIGN
MWS/JAK

DRAWN
JAK

REVISIONS
Revised

APPROVED
MWS

DATE
1/26/06

SCALE
NOTED
SHEET

2 OF 26

FILE: Eng\Clifton Cove Add\SS1

05-08-E316