BENCHMARK:
Arkansas River bridge & 63rd St. S. City of Wichita Benchmark Disc. SW Cor. of bridge, top of hubguard. 500'± E. of Grove.
Elev. = 1269.95 NGVD29 (per City record)

Brass plate on the NE wingwall of Arkansas River bridge & 63rd St. S.
Elev. = 1267.48 NGVD29 (per County record)

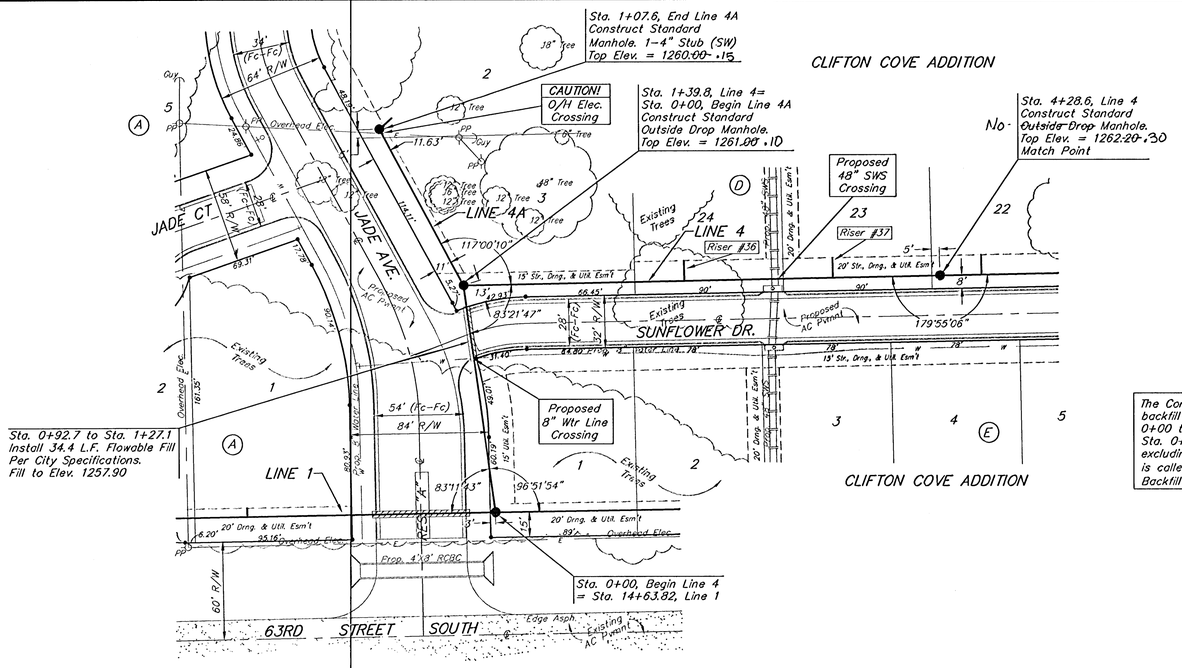

SCALE:
1" = 40' HORIZONTAL
1" = 5' VERTICAL
• = IRON

The Contractor shall be required to backfill trench with sand from Sta. 0+00 to Sta. 4+28.6, Line 4 and from Sta. 0+00 to Sta. 1+07.6, Line 4A excluding locations where Flowable Fill is called out. To be bid as "L.F. Sand Backfill Jetted and Vibrated"

SEWER SERVICE TABLE

NUMBER	TYPE	LOCATION				FOR INFORMATION ONLY	
		LOT NO.	BLOCK NO.	LINE NO.	STATION/ DIRECTION	APPROXIMATE LENGTH 4" PIPE VERTICAL	HORIZONTAL
36	8" X 4" Tee Saddle	24	D	4	2+34/Lt.	14.5'	12'
37	8" X 4" Tee Saddle	23	D	4	3+64/Lt.	14.5'	12'

NOTE: Vertical Riser Pipe shall be extended to 2' minimum above ground water elevation and 4' maximum below proposed ground elevation.

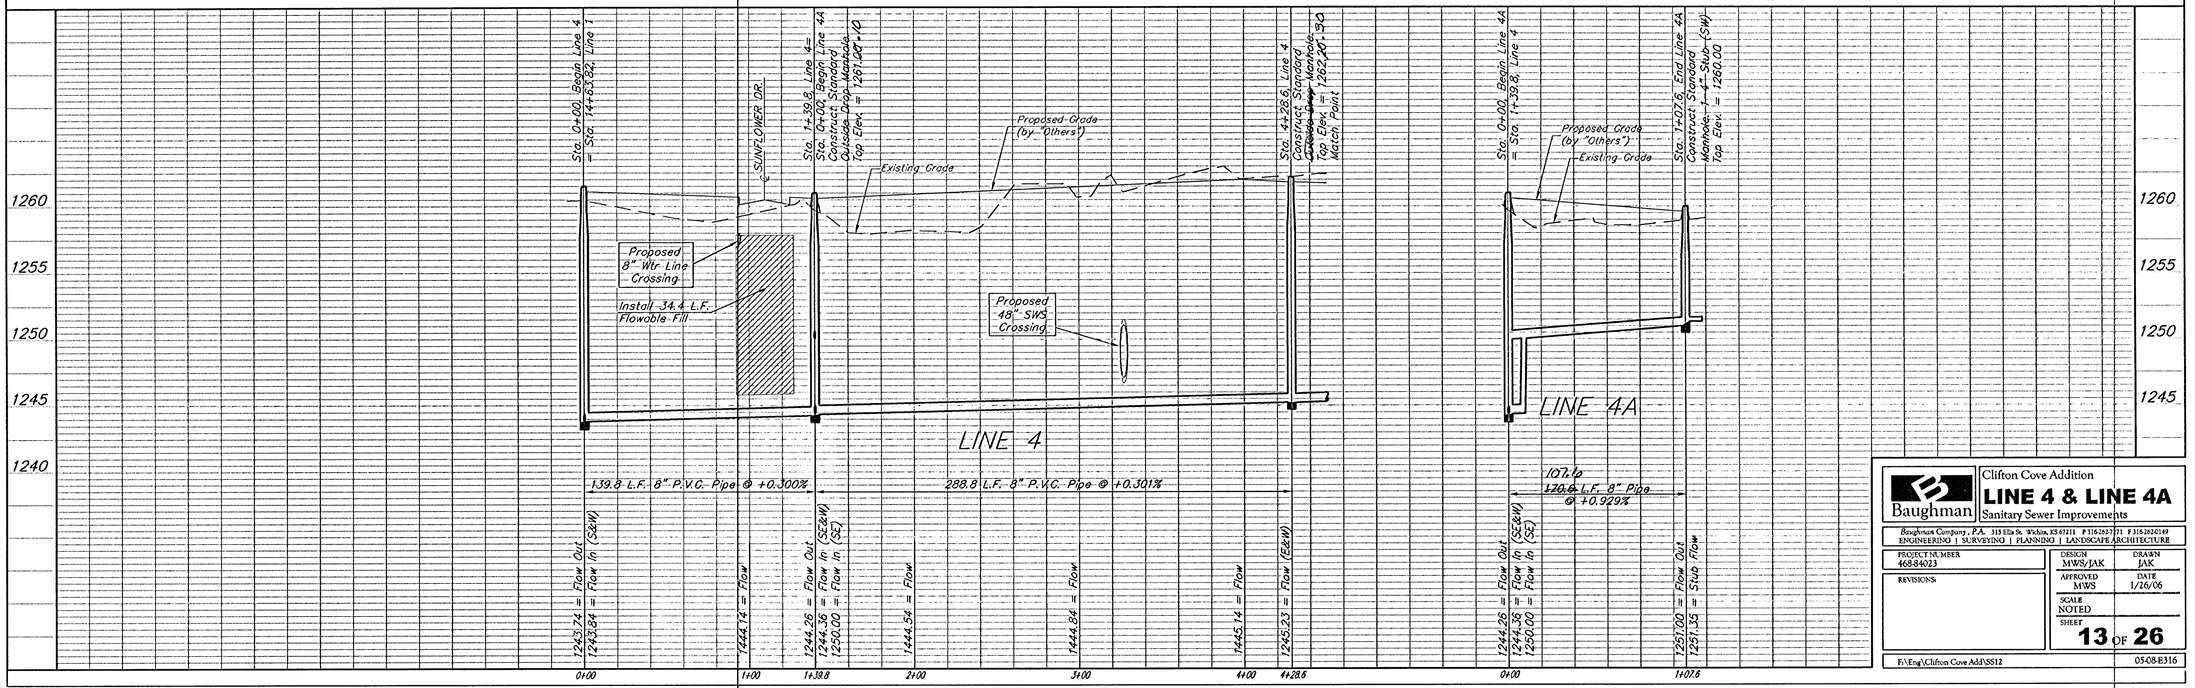

Baughman
Clifton Cove Addition
LINE 4 & LINE 4A
Sanitary Sewer Improvements

Baughman Company, P.A. 318 Elk St. Wichita, KS 67211 P 316.263.7721 F 316.263.0149
ENGINEERING | SURVEYING | PLANNING | LANDSCAPE ARCHITECTURE

PROJECT NUMBER 468-84023	DESIGN MWS/JAK / DRAWN JAK
REVISIONS:	APPROVED MWS / DATE 1/26/06
	SCALE NOTED
	SHEET 13 OF 26

F:\Eng\Clifton Cove Add\SS12 05-08-E316