BENCHMARK:
Arkansas River bridge & 63rd St. S. City of Wichita Benchmark Disc. SW Cor. of bridge, top of hubguard. 500'± E. of Grove.
Elev. = 1269.95 NGVD29 (per City record)

Brass plate on the NE wingwall of Arkansas River bridge & 63rd St. S.
Elev. = 1267.48 NGVD29 (per County record)

SEWER SERVICE TABLE

NUMBER	TYPE	LOCATION			STATION/ DIRECTION	FOR INFORMATION ONLY APPROXIMATE LENGTH 4" PIPE	
		LOT NO.	BLOCK NO.	LINE NO.		VERTICAL	HORIZONTAL
44	8" X 4" Tee Saddle	5	F	4	12+~~88~~/Rt. 49.5	9'	12.5'
45	8" X 4" Tee Saddle	6	F	4	13+35/Rt.	8'	10.5'
46	8" X 4" Tee Saddle	7	F	4	14+~~25~~/Rt. 26.5	7.5'	8.5'

NOTE: Vertical Riser Pipe shall be extended to 2' minimum above ground water elevation and 4' maximum below proposed ground elevation.

The Contractor shall be required to backfill trench with sand from Sta. 12+09.4 to Sta. 21+19.1, Line 4. To be bid as "L.F. Sand Backfill Jetted and Vibrated"

SCALE:
1" = 40' HORIZONTAL
1" = 5' VERTICAL
• = IRON

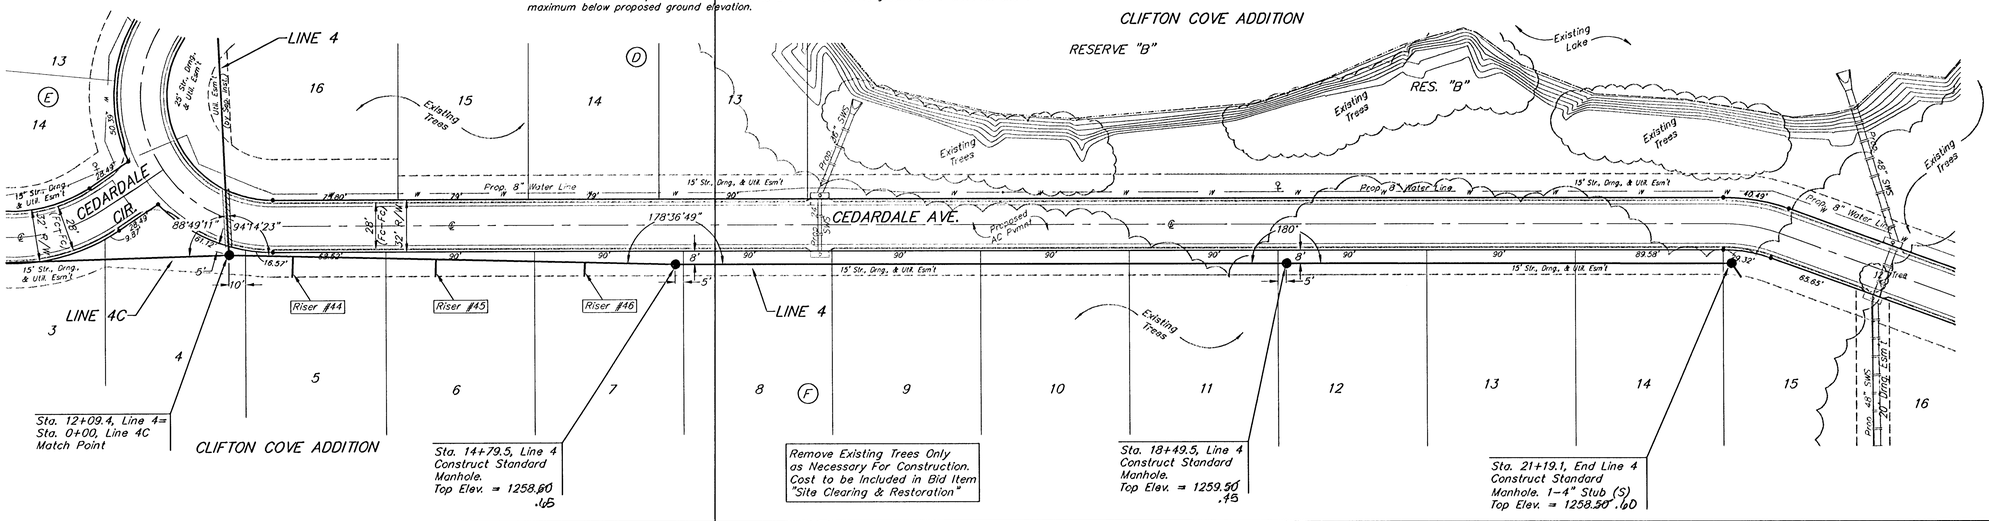

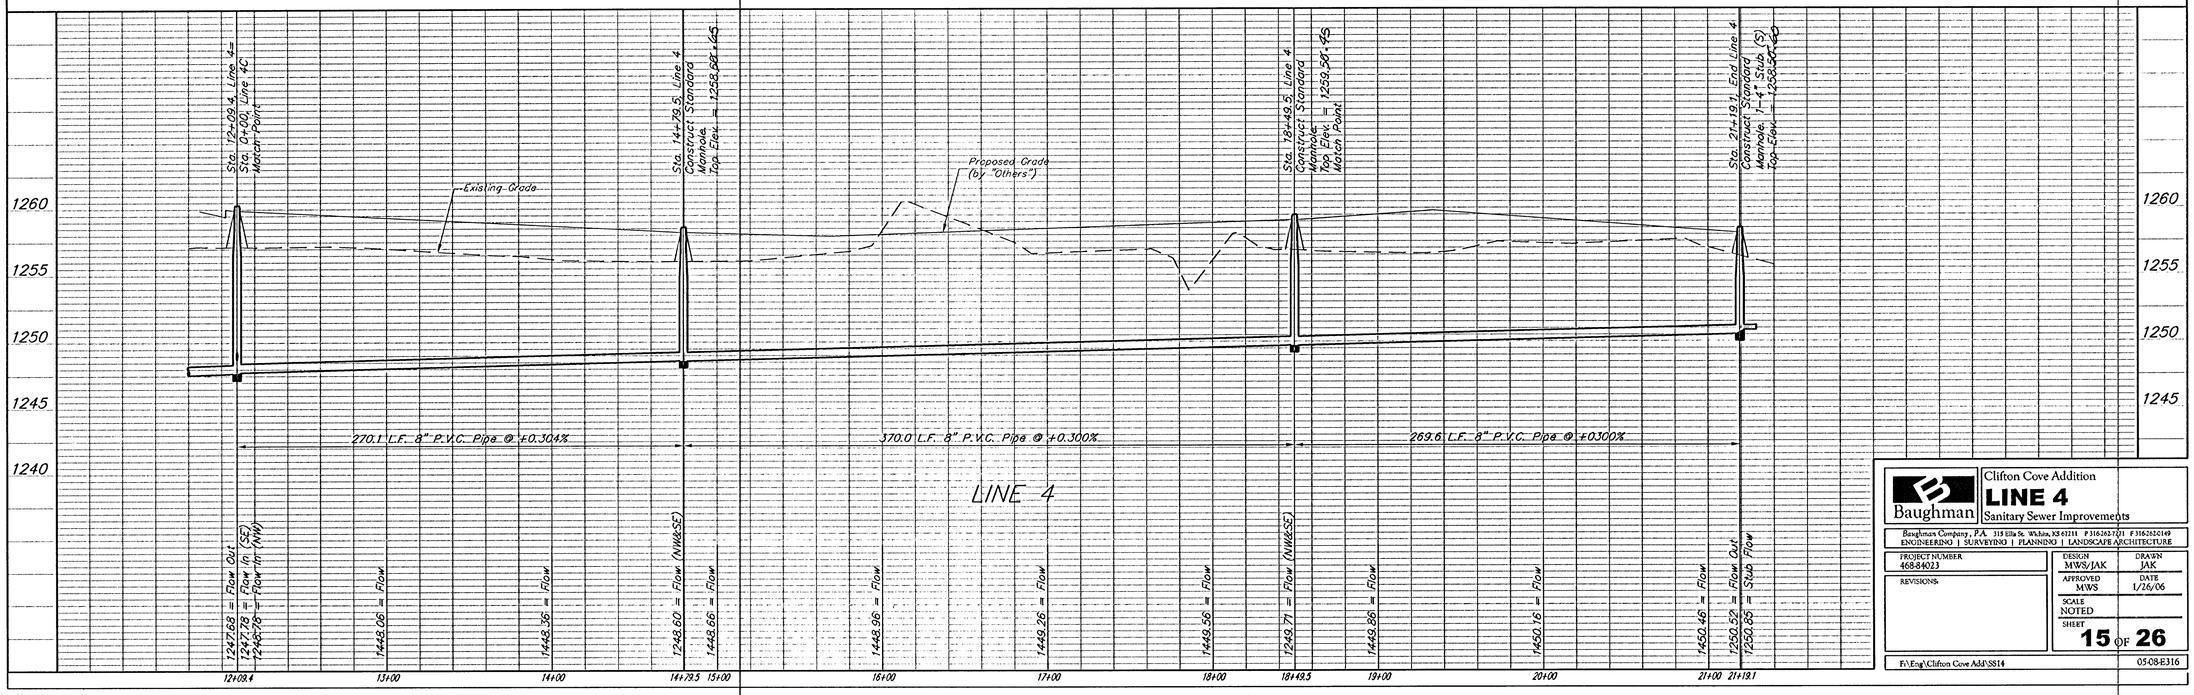

Baughman

Clifton Cove Addition
LINE 4
Sanitary Sewer Improvements

Baughman Company, P.A. 315 Ellis St. Wichita, KS 67211 P 316.262.7121 F 316.262.0149
ENGINEERING | SURVEYING | PLANNING | LANDSCAPE ARCHITECTURE

PROJECT NUMBER 468-84023	DESIGN MWS/JAK	DRAWN JAK
REVISIONS:	APPROVED MWS	DATE 1/26/06
	SCALE NOTED	
	SHEET 15 OF 26	

F:\Eng\Clifton Cove Add\SS14 05-08-E316