


PLAN LINE 3

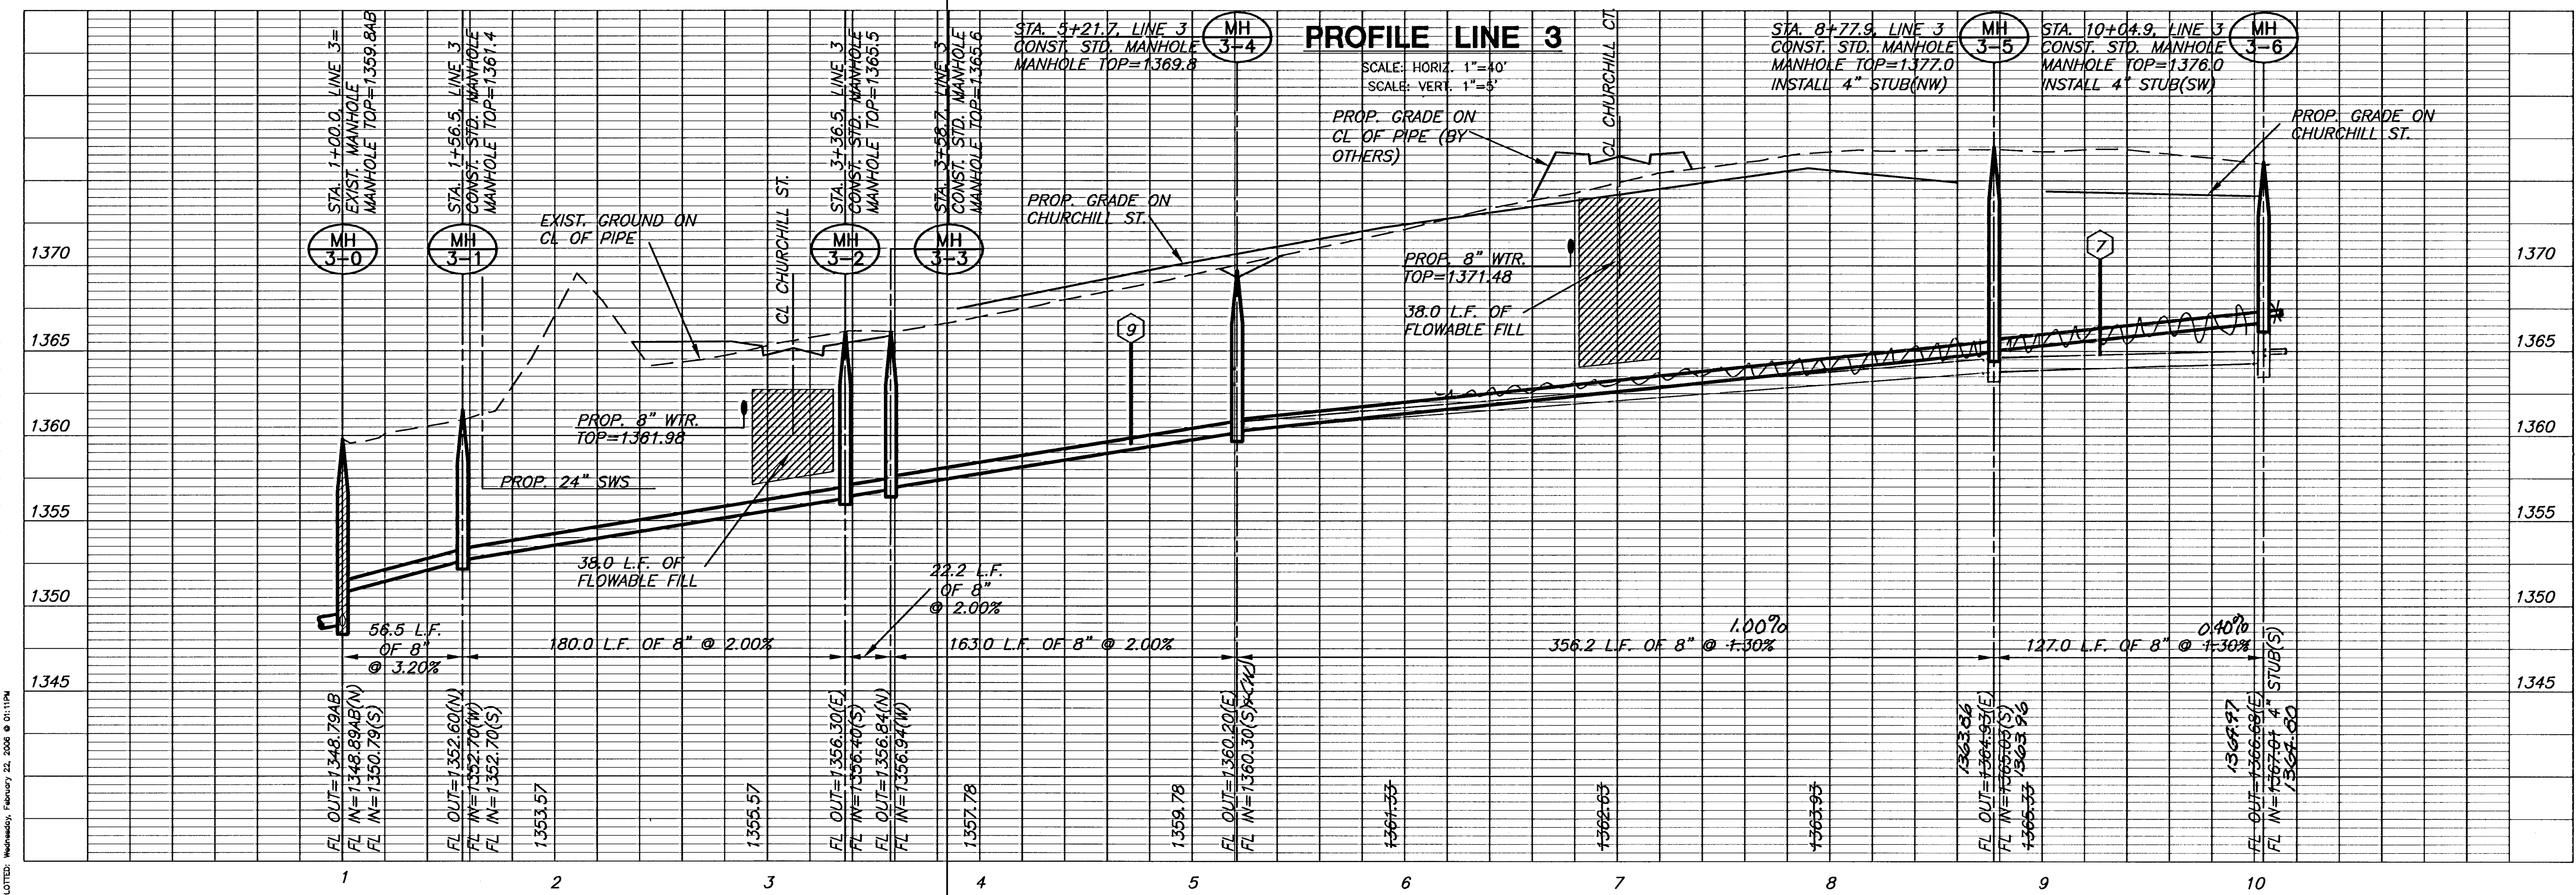

LINE 3
 SHEET TITLE
 448-00000
 PROJECT NUMBER

DESIGN BY: SRS
 DRAWN BY: DM/BFL
 CHECKED BY: GJA

ISSUED: FEBRUARY 2006
 REVISED:

SHEET NO.
5 of 11