


REEDS COVE ADDITION


CAUTION:  
UNDERGROUND  
TELEPHONE AND POWER  
CABLES.

NOTE:  
SEE SHEET 7 FOR RISER  
TABLE.

Note: MH moved 1' west to  
avoid conflict.  
15' Stub out (SW)  
8' Stub out area inlet on SWS (NW)

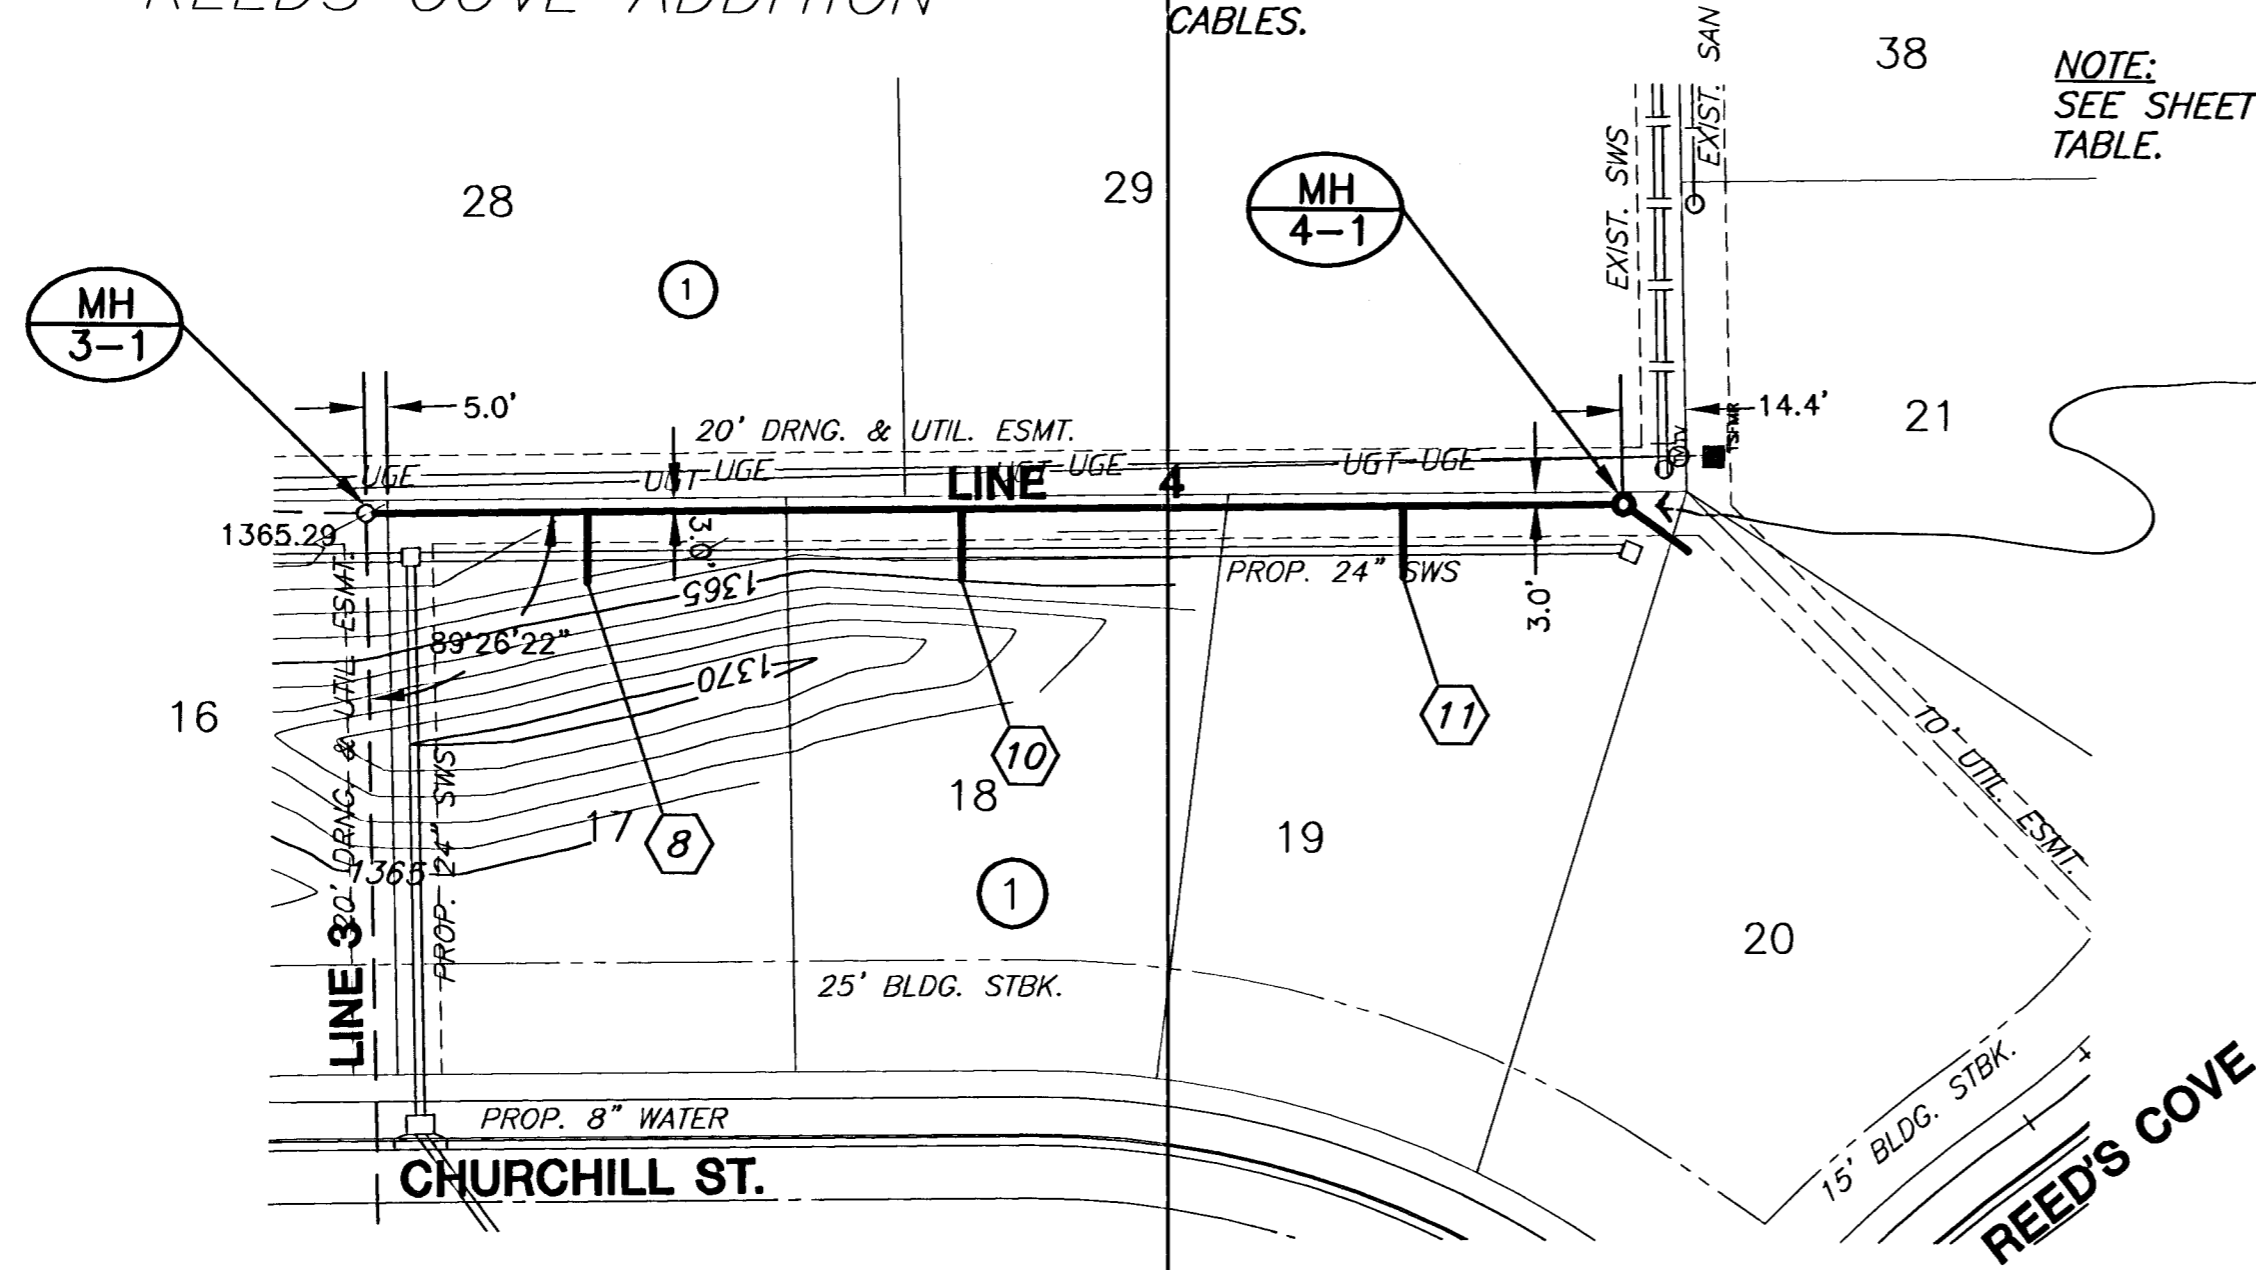


NOTE:  
CONTRACTOR SHALL SUPPORT  
EXISTING UTILITIES AS REQUIRED  
TO CONSTRUCT SANITARY SEWER.

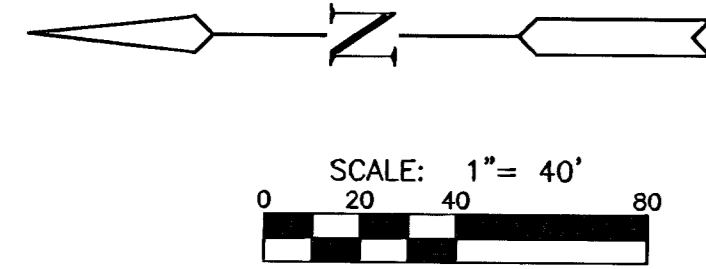

PLAN LINE 4

PROFILE LINE 4

SCALE: HORIZ. 1"=40'  
SCALE: VERT. 1"=5'

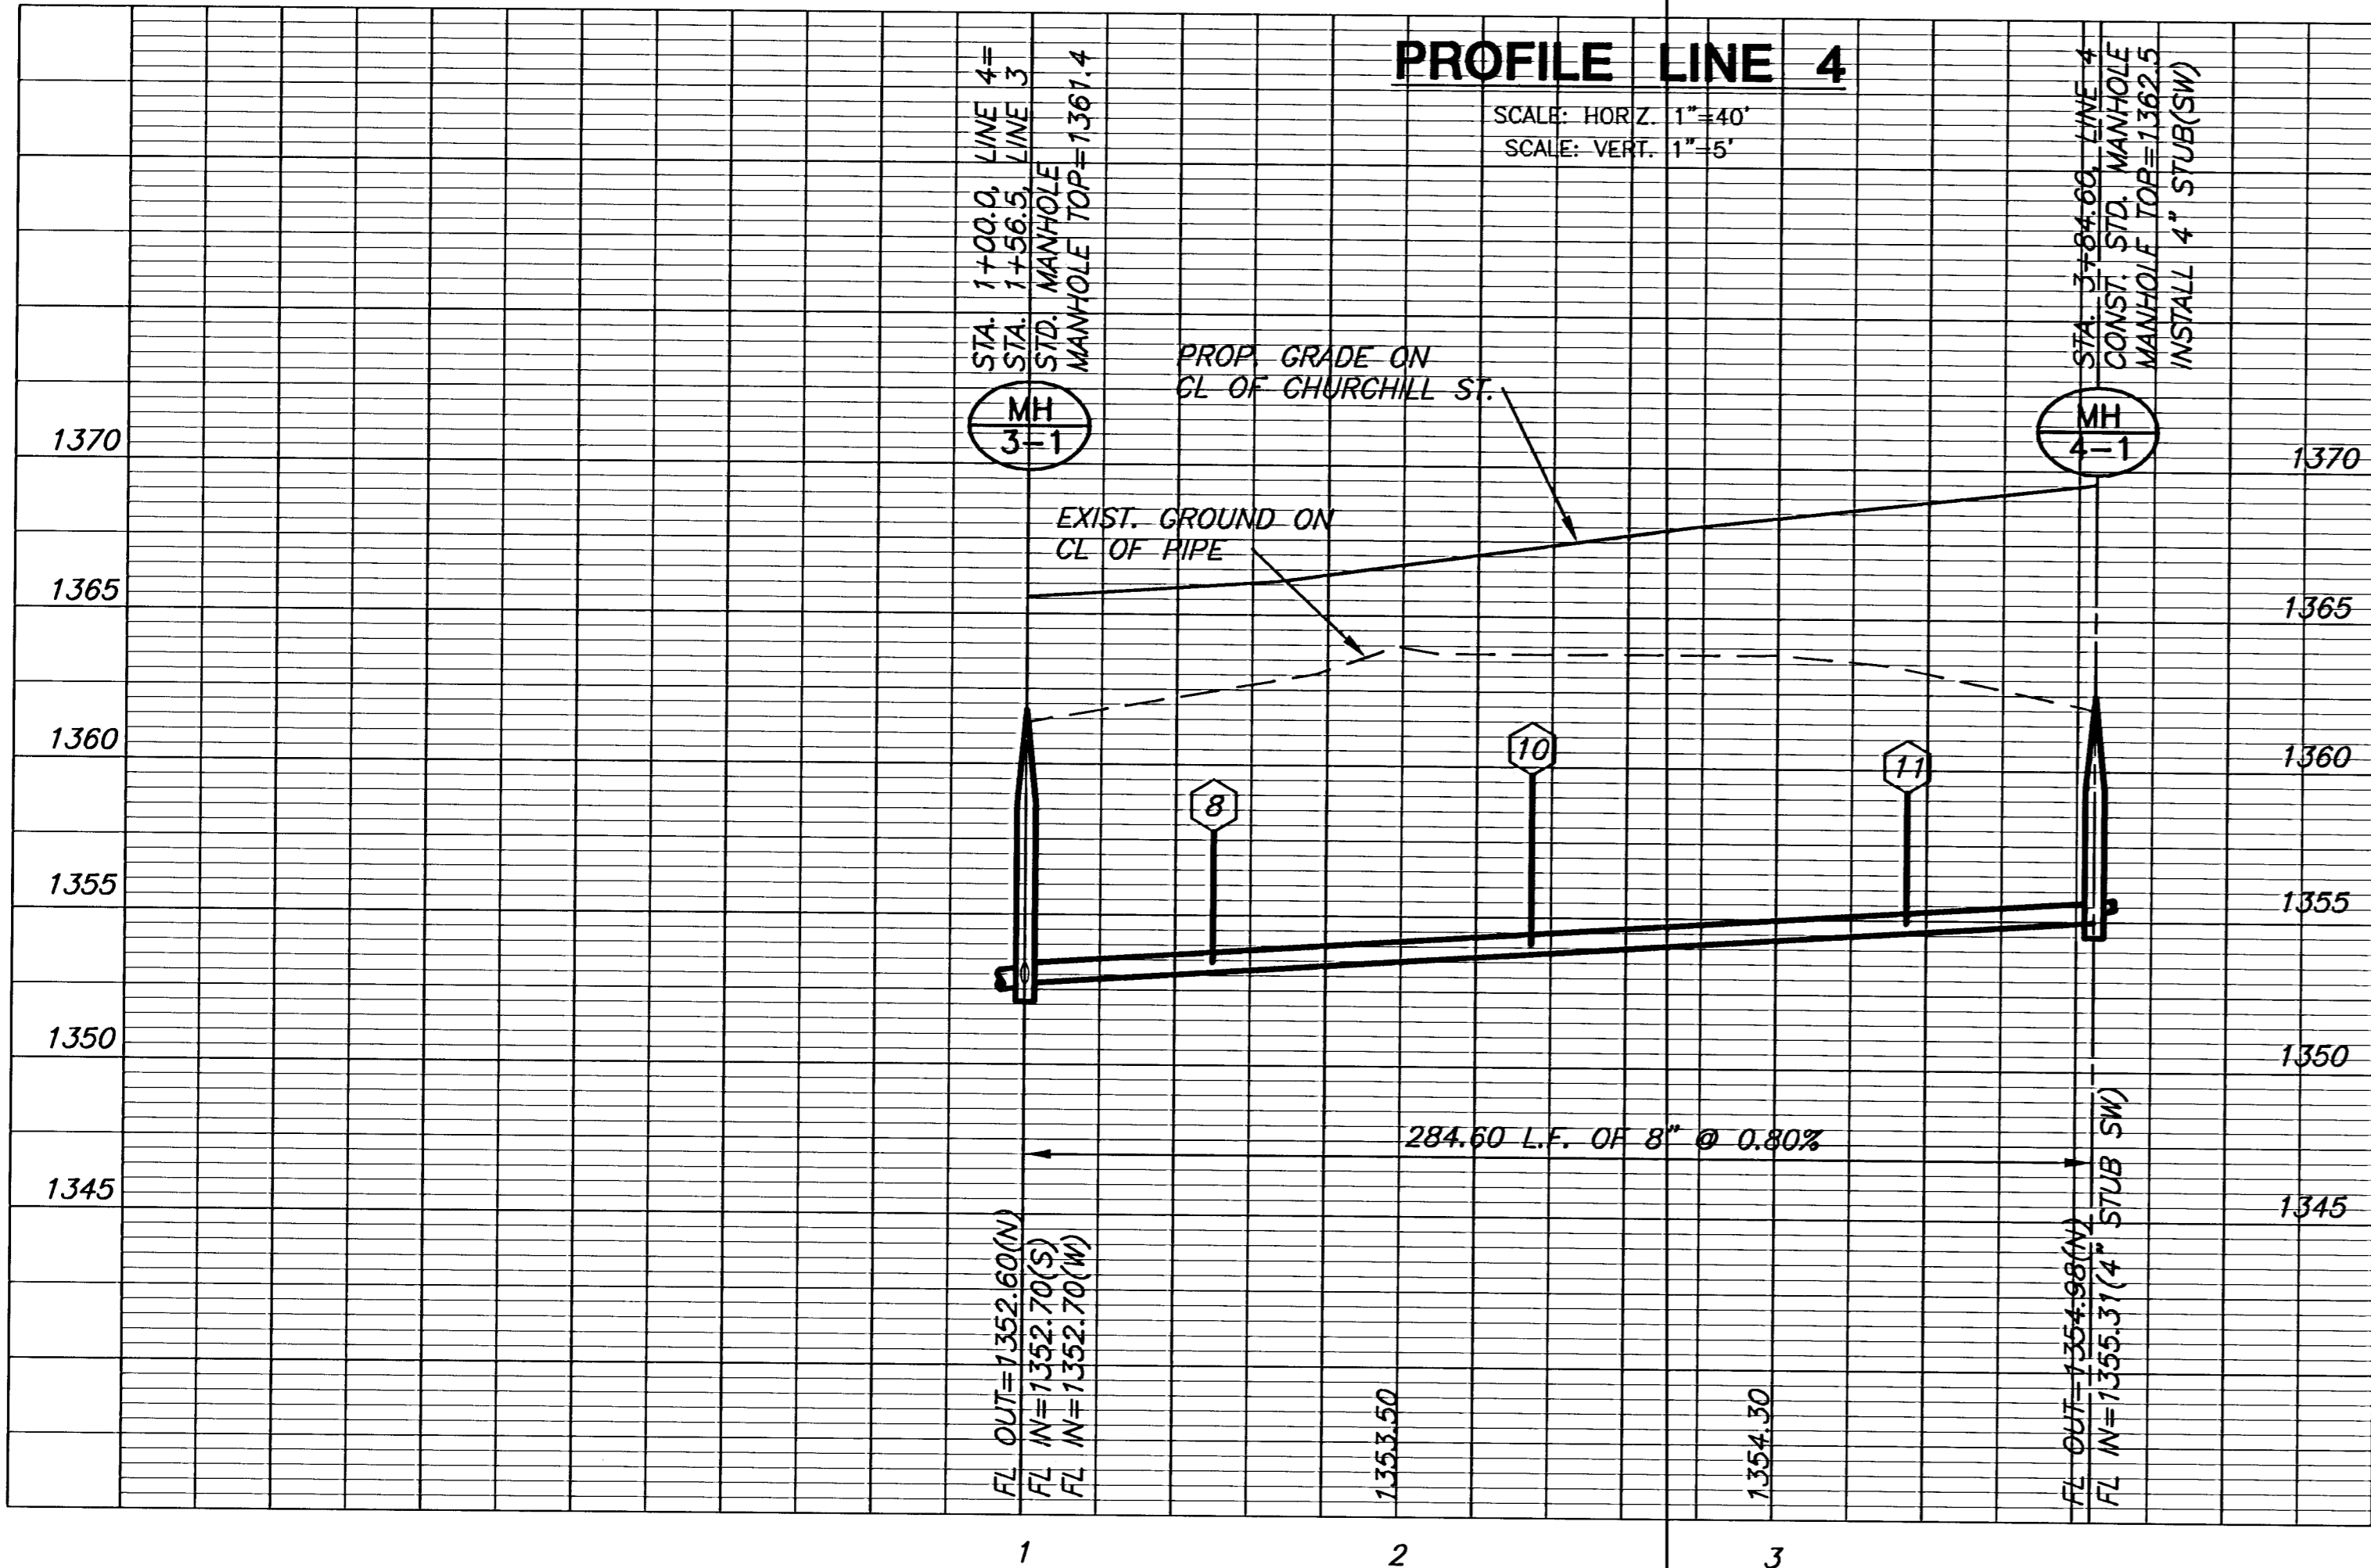

**MKEC**  
ENGINEERING  
CONSULTANTS, INC.  
411 N. WEBB ROAD  
WICHITA, KS. 67206  
316-684-9600

SANITARY SEWER PLANS  
**REED'S COVE**  
FOURTH ADDITION

**LINE 4**  
SHEET TITLE  
PROJECT NUMBER  
448-00000

DESIGN BY: SRS  
DRAWN BY: DM/BFL  
CHECKED BY: GJA

ISSUED: FEBRUARY 2006  
REVISED:

SHEET NO.  
6 of 11