
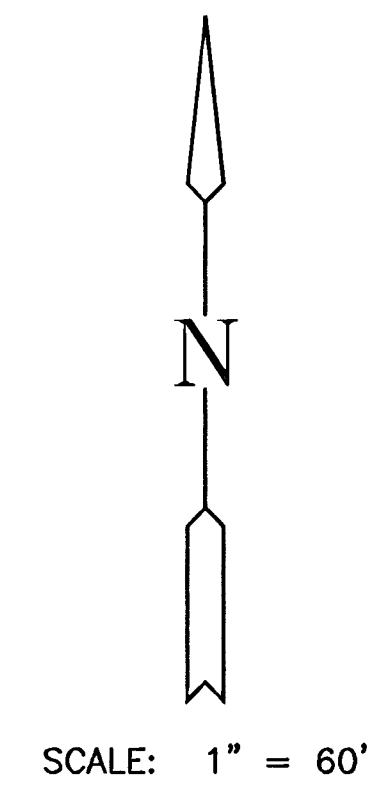


REED'S COMMERCIAL ADDITION

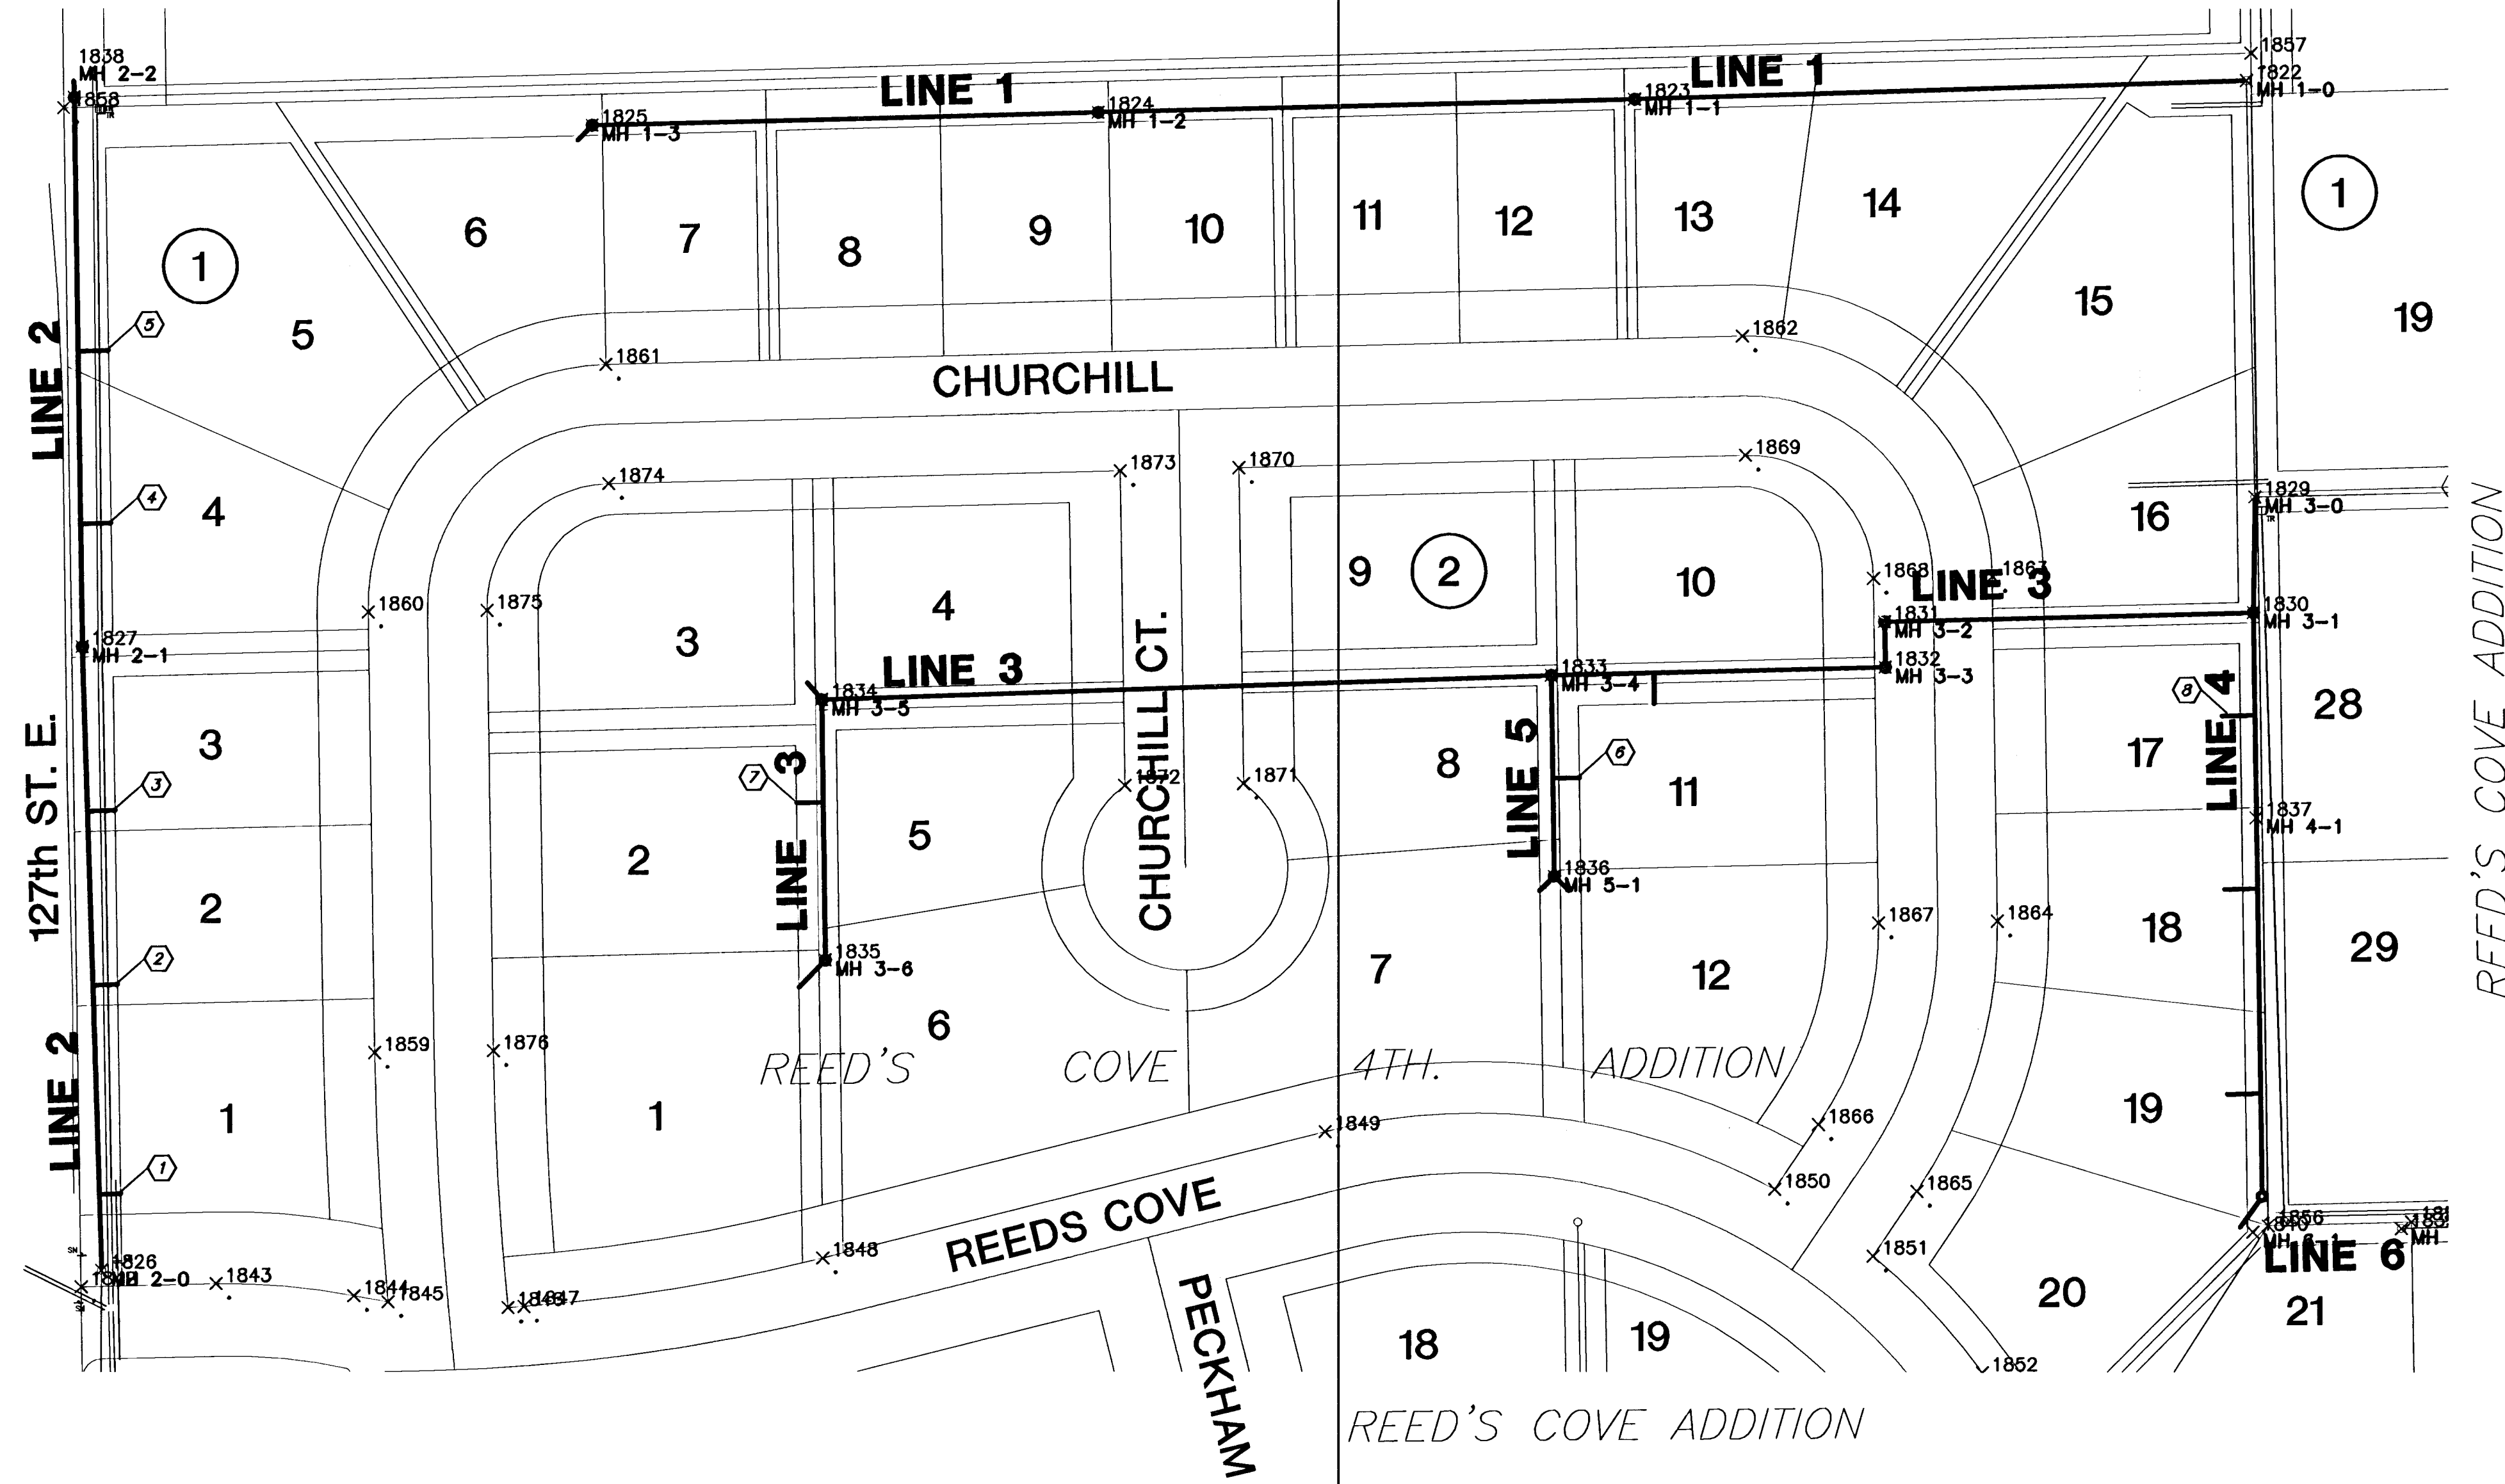

Manhole Points			
Point No.	Northing	Easting	Description
1822	1698998.98	1692651.23	MH 1-0
1823	1698989.86	1692352.63	MH 1-1
1824	1698983.26	1692090.70	MH 1-2
1825	1698977.04	1691843.77	MH 1-3
1826	1698418.59	1691604.41	MH 2-0
1827	1698722.60	1691594.80	MH 2-1
1828	1698990.67	1691590.77	MH 2-2
1829	1698736.04	1692655.49	MH 3-0
1830	1698739.54	1692654.66	MH 3-1
1831	1698735.01	1692474.70	MH 3-2
1832	1698712.86	1692475.04	MH 3-3
1833	1698708.75	1692312.08	MH 3-4
1834	1698696.79	1691956.04	MH 3-5
1835	1698569.80	1691957.72	MH 3-6
1836	1698610.76	1692313.55	MH 5-1
1837	1698639.55	1692656.18	MH 4-1
1838	1698990.67	1691590.77	MH 2-2
1839	1698439.30	1692727.16	MH 6-0
1840	1698437.48	1692654.74	MH 6-1

Plat Irons			
Point No.	Northing	Easting	Description
1842	1698410.49	1691594.48	PI
1843	1698412.05	1691660.43	PI
1844	1698406.03	1691727.70	PI
1845	1698403.09	1691744.45	PI
1846	1698400.30	1691803.00	PI
1847	1698400.80	1691810.79	PI
1848	1698424.53	1691956.65	PI
1849	1698486.12	1692201.69	PI
1850	1698458.22	1692421.27	PI
1851	1698425.73	1692469.32	PI
1852	1698368.63	1692522.71	PI
1853	1698295.80	1692669.19	PI
1854	1698297.45	1692734.55	PI
1855	1698442.43	1692732.11	PI
1856	1698440.66	1692662.14	PI
1857	1699012.44	1692653.58	PI
1858	1698985.55	1691585.85	PI
1859	1698524.58	1691737.78	PI
1860	1698739.43	1691734.58	PI
1861	1698860.17	1691850.55	PI
1862	1698874.15	1692405.40	PI
1863	1698756.97	1692527.38	PI
1864	1698588.96	1692529.90	PI
1865	1698457.26	1692490.64	PI
1866	1698489.75	1692442.59	PI
1867	1698588.09	1692471.91	PI
1868	1698756.10	1692469.39	PI
1869	1698816.17	1692406.88	PI
1870	1698809.94	1692159.55	PI
1871	1698655.95	1692161.88	PI
1872	1698655.08	1692103.87	PI
1873	1698808.48	1692101.58	PI
1874	1698802.19	1691852.01	PI
1875	1698740.30	1691792.55	PI
1876	1698525.44	1691795.78	PI

SANITARY SEWER PLANS
REED'S COVE
 FOURTH ADDITION

BUBBLE MAP
 SHEET TITLE
 448-00000
 PROJECT NUMBER

DESIGN BY SRS
 DRAWN BY BFL
 CHECKED BY GJA

ISSUED FEBRUARY 2006
 REVISED

SHEET NO.
7 of 11

PLOTTED: 2/22/06, February 22, 2006 @ 03:59PM

H:\CIVIL\021211_4th Addition\SSAN\BND\021211.BEG