


BENCHMARK:
BM #1: "□" Cut in middle of
N headwall of RCBC on 21st
St. North, 1004.3' W & 22.1'
N of SE Cor., SE 1/4, Sec. 2,
T-27-S, R-2-E.
Elev. = 173.23 City Datum

BM #2: "□" Cut at the SE
corner of the intersection of
Castle Rock & Castle Rock Ct.,
Krug North Addition.
Elev. = 183.50 City Datum

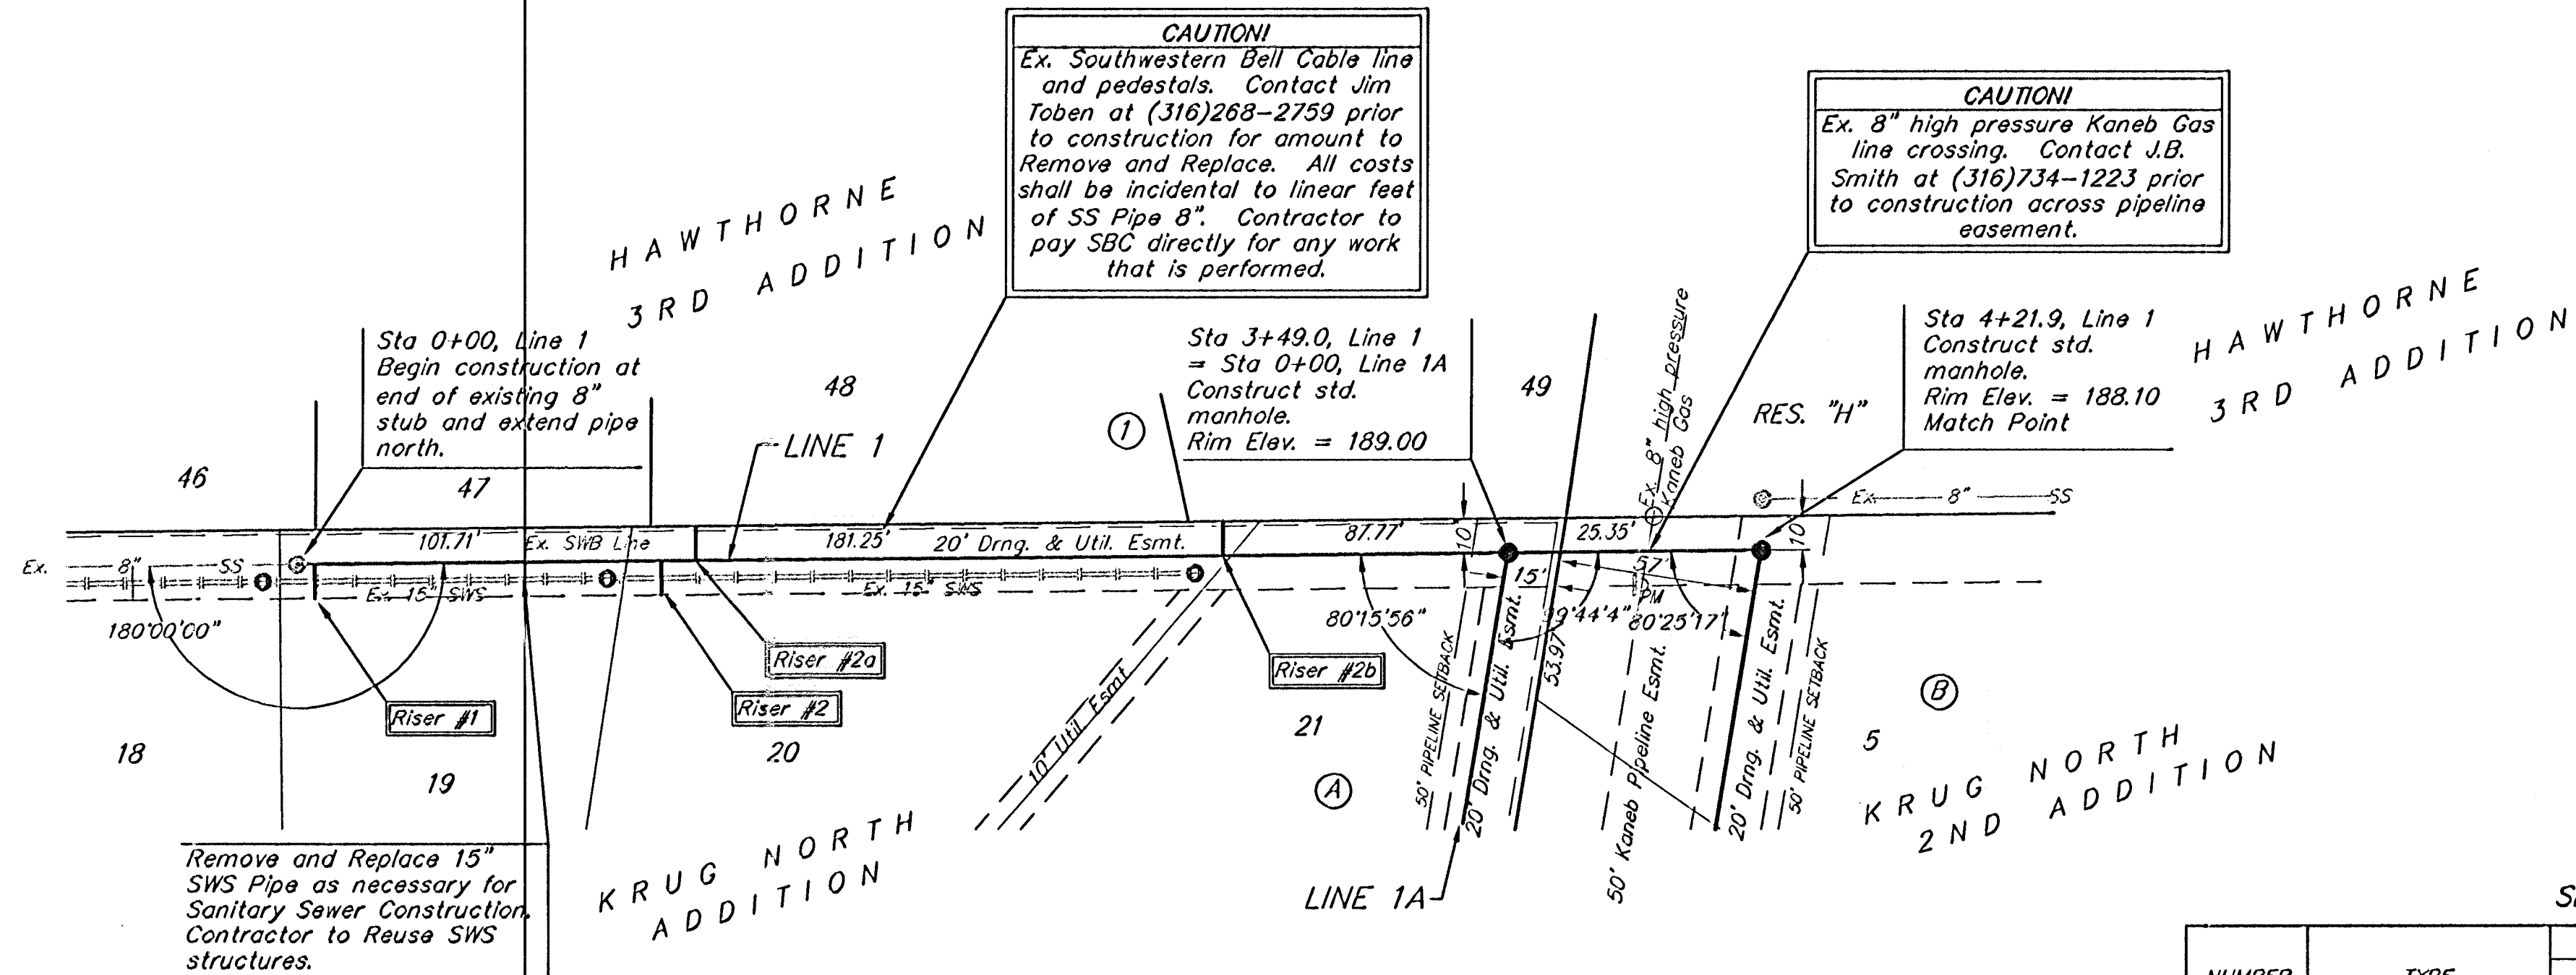


Scale: 1" = 40' Horizontal
1" = 5' Vertical
• = Iron



SEWER SERVICE TABLE

NUMBER	TYPE	LOCATION				FOR INFORMATION ONLY	
		LOT NO.	BLOCK NO.	LINE NO.	STATION / DIRECTION	APPROXIMATE LENGTH 4" PIPE	
1	8" X 4" Tee	19	A	1	0+00/RI07	12.0'	10' 10.3'
2	8" X 4" Tee	20	A	1	1+00/RI03	11.5'	10'
2a	8" X 4" Tee	48	1	1	1+18/L11	11.5'	10'
2b	8" X 4" Tee	49	1	1	2+00/L104	11.5'	10' 9.5'

NOTE: Vertical Riser Pipe shall be extended to 2' minimum above ground water elevation and 4' maximum below proposed ground elevation.

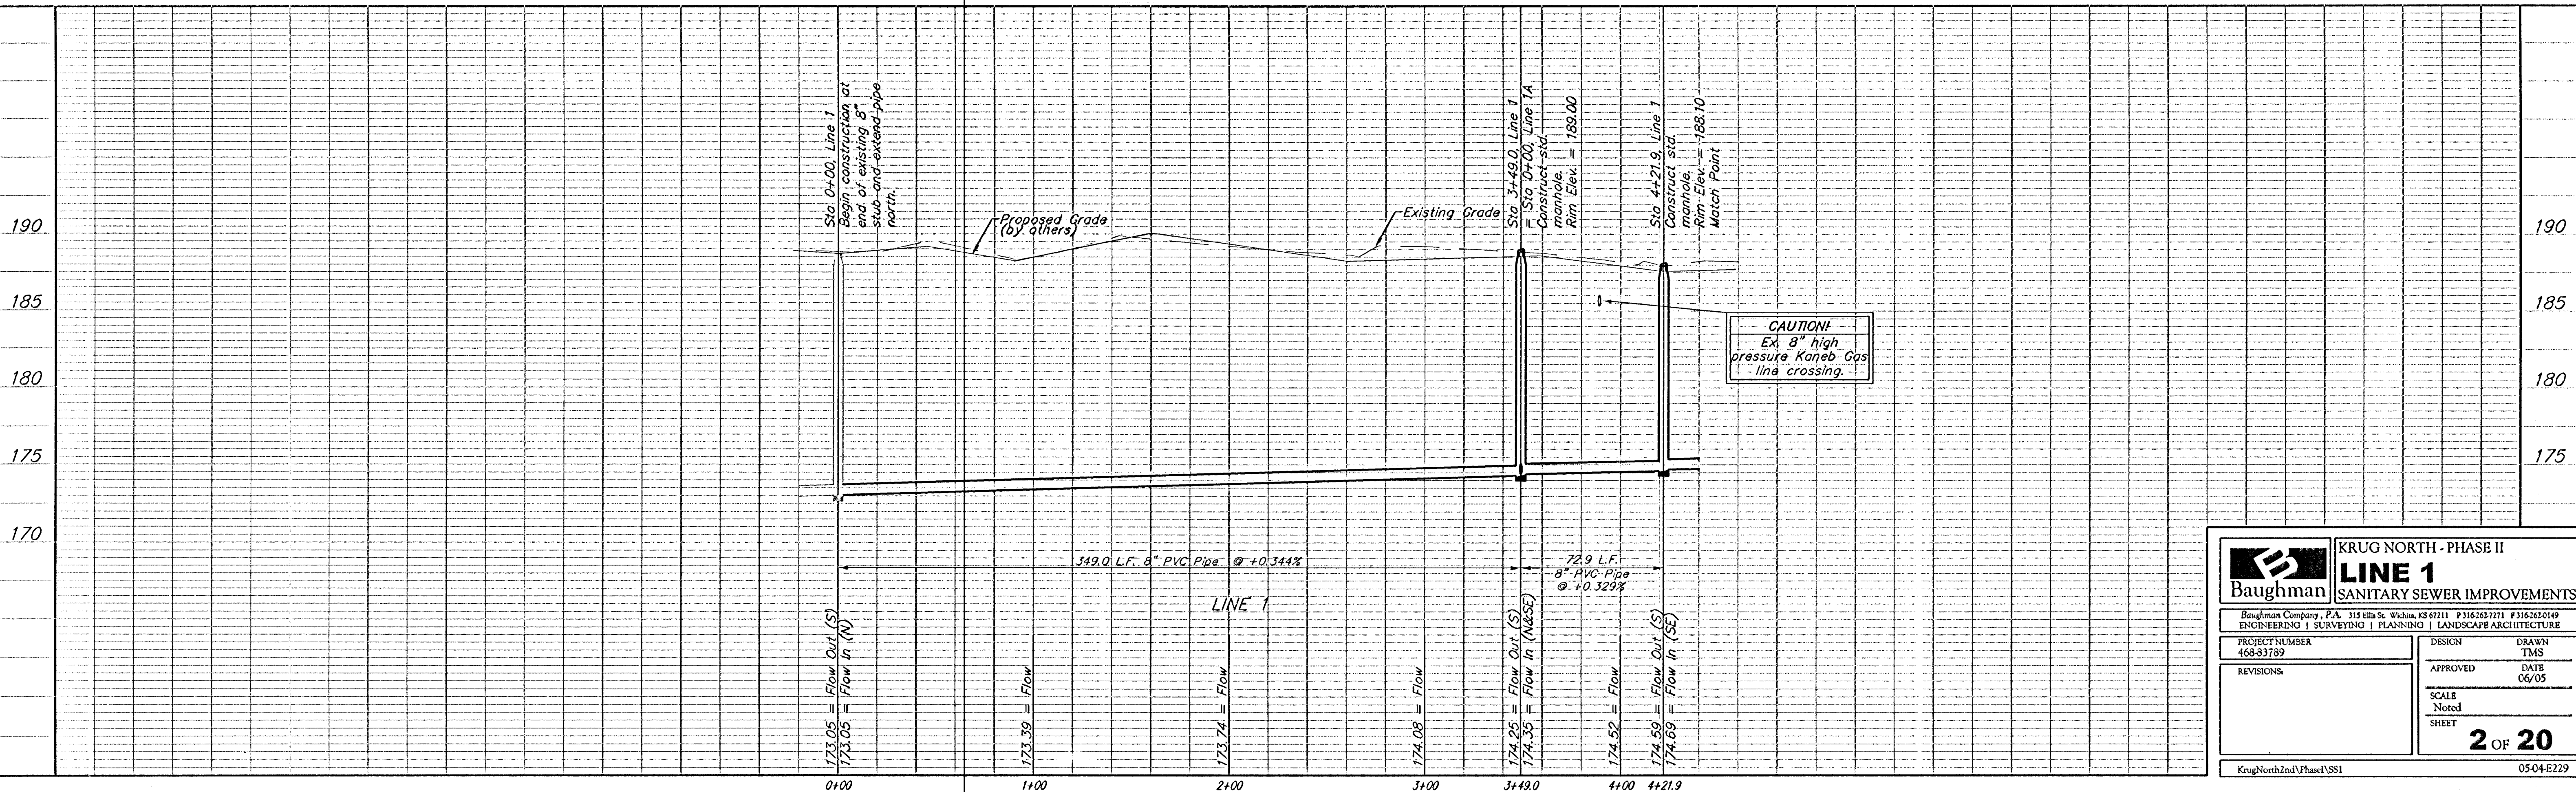



KRUG NORTH - PHASE II
LINE 1
SANITARY SEWER IMPROVEMENTS

Baughman Company, P.A. 315 Ellis St. Wichita, KS 67211 P 316-262-7271 F 316-262-0149
ENGINEERING | SURVEYING | PLANNING | LANDSCAPE ARCHITECTURE

PROJECT NUMBER 468-53759	DESIGN TWS
REVISIONS	APPROVED DATE 06/05
	SCALE Noted SHEET

2 OF 20

KrugNorth2ndPhase1SSI 0504E229