

BM #2: "□" Cut at the SE corner of the intersection of Castle Rock & Castle Rock Ct., Krug North Addition.
Elev. = 183.50 City Datum

EASTSIDE
COMMUNITY
CHURCH 2ND
ADDITION

KRUG NORTH
ADDITION 42

KRUG NORTH
2ND ADDITION

2 N D

Note: These risers were added at a later date with project #472-83974 (Paving of Castle Rock, Burning Tree, Aylesbury Ct. + SWB).


32

CAUTION!

Contractor to Fill Existing Pit as necessary to preserve the integrity of S.S. pipe. Contractor shall regrade flowline as necessary to keep positive flow into existing 30" SWS end section. All costs associated shall be incidental to "Site Clearing and Restoration".

Scale: 1" = 40' Horizontal
1" = 5' Vertical
• = Iron

NUMBER	TYPE	Location			DISTANCE FROM			
		Lot No.	Block No.	Line No.	Station \ Direction	Main to Riser	Upstream MH	Downstream MH
13	8" X 4" Tee	39	A	2A	1+66.4/Rt	14'	186.00'	155.4'
14	8" X 4" Tee	40	A	2A	1+87.5/Rt	13.8'	178.60'	176.2'
15	8" X 4" Tee	41	A	2A	1+132.2/Rt	14.6'	14.90'	326.9'
16	8" X 4" Tee	42	A	2A	1+103.2/Rt	14.3'	294.00'	70.30'

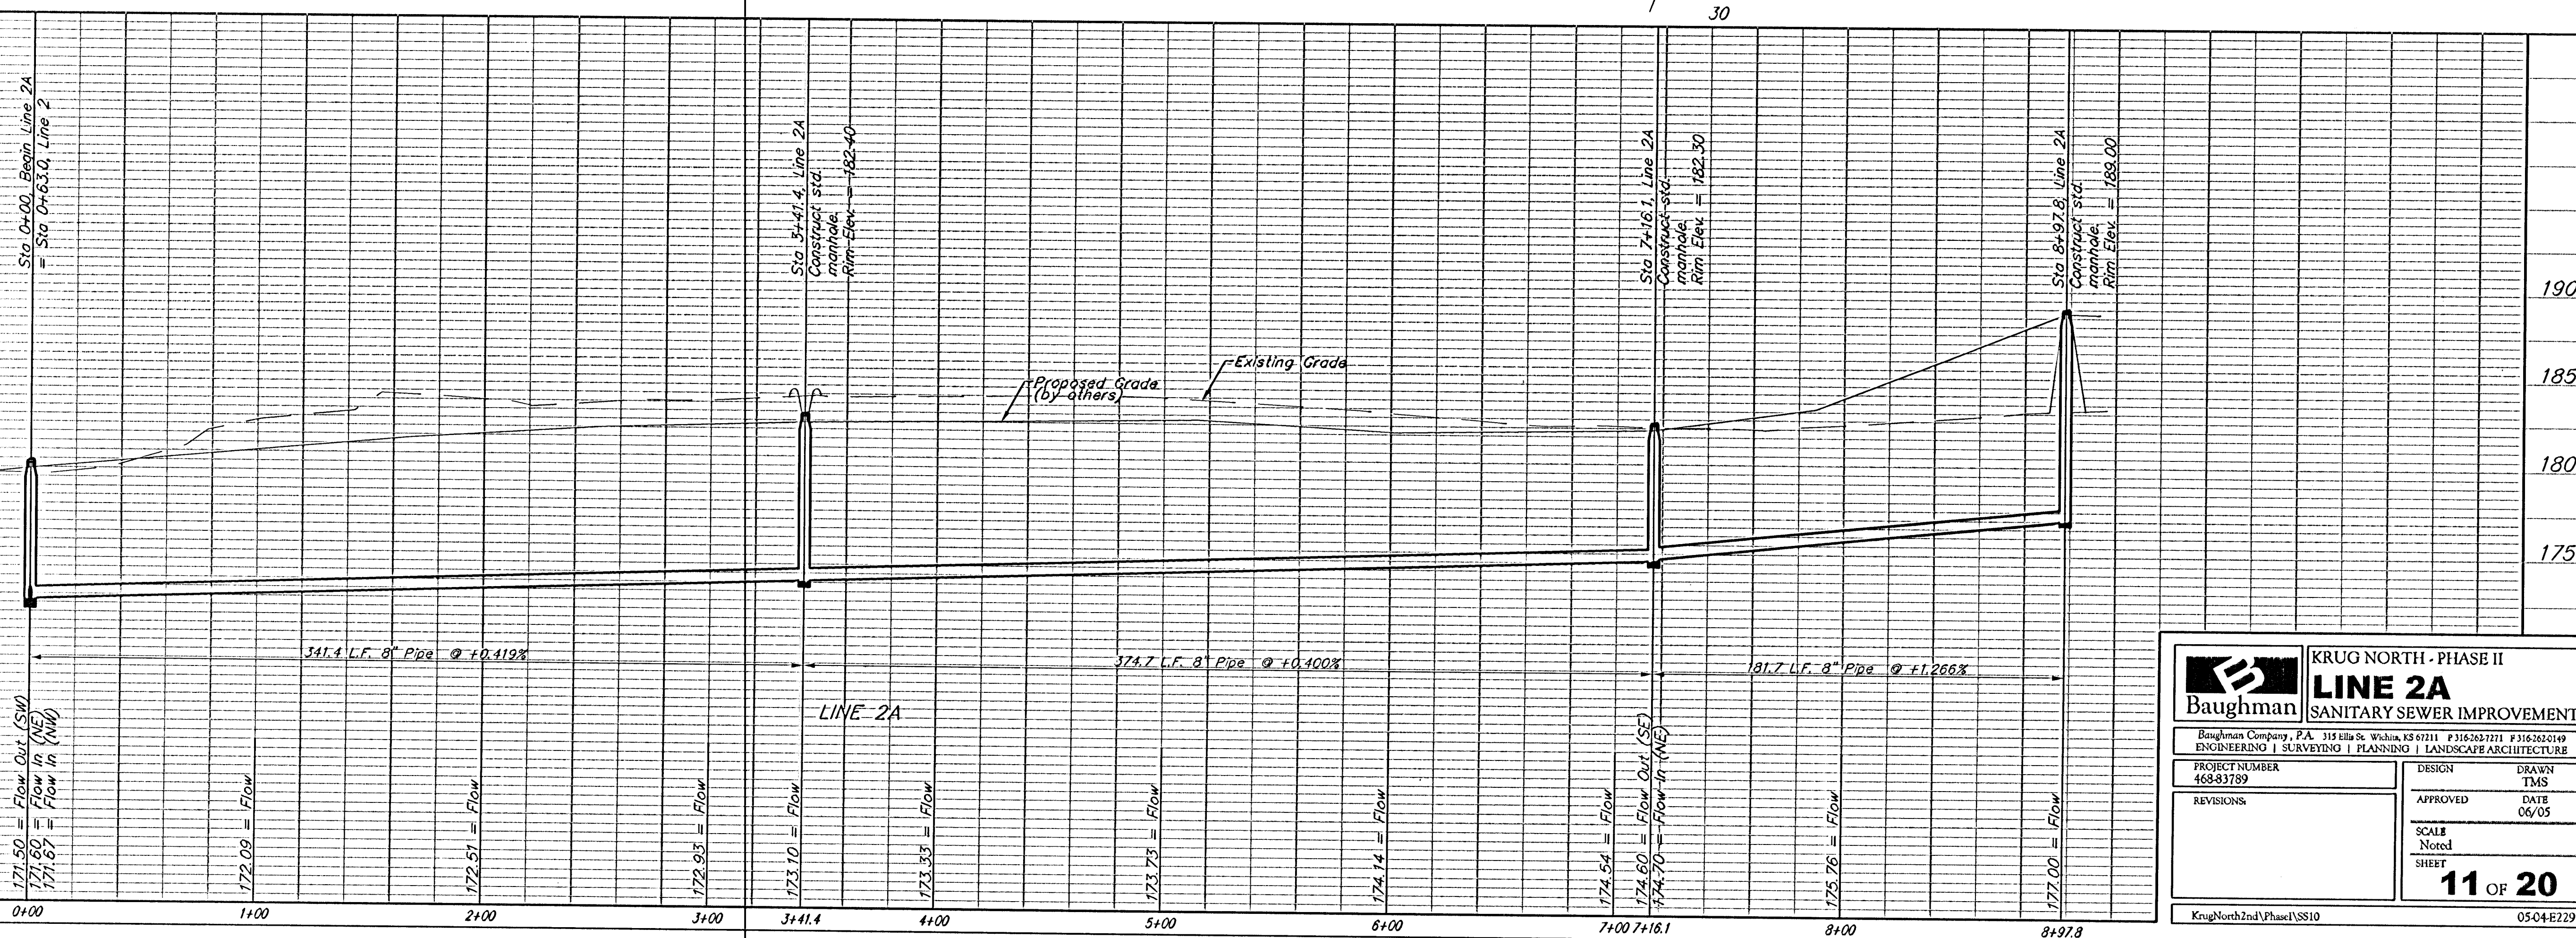

 Baughman	KRUG NORTH - PHASE II LINE 2A SANITARY SEWER IMPROVEMENTS	
	Baughman Company, P.A. 315 Ella St. Wichita, KS 67211 P 316-263-7271 F 316-262-0149 ENGINEERING SURVEYING PLANNING LANDSCAPE ARCHITECTURE	
PROJECT NUMBER 46843789	DESIGN APPROVED	DRAWN TMS DATE 06/05
REVISIONS:	SCALE Noted SHEET 11 OF 20	
KrugNorth2nd\Phase\SS10		0504-E229