

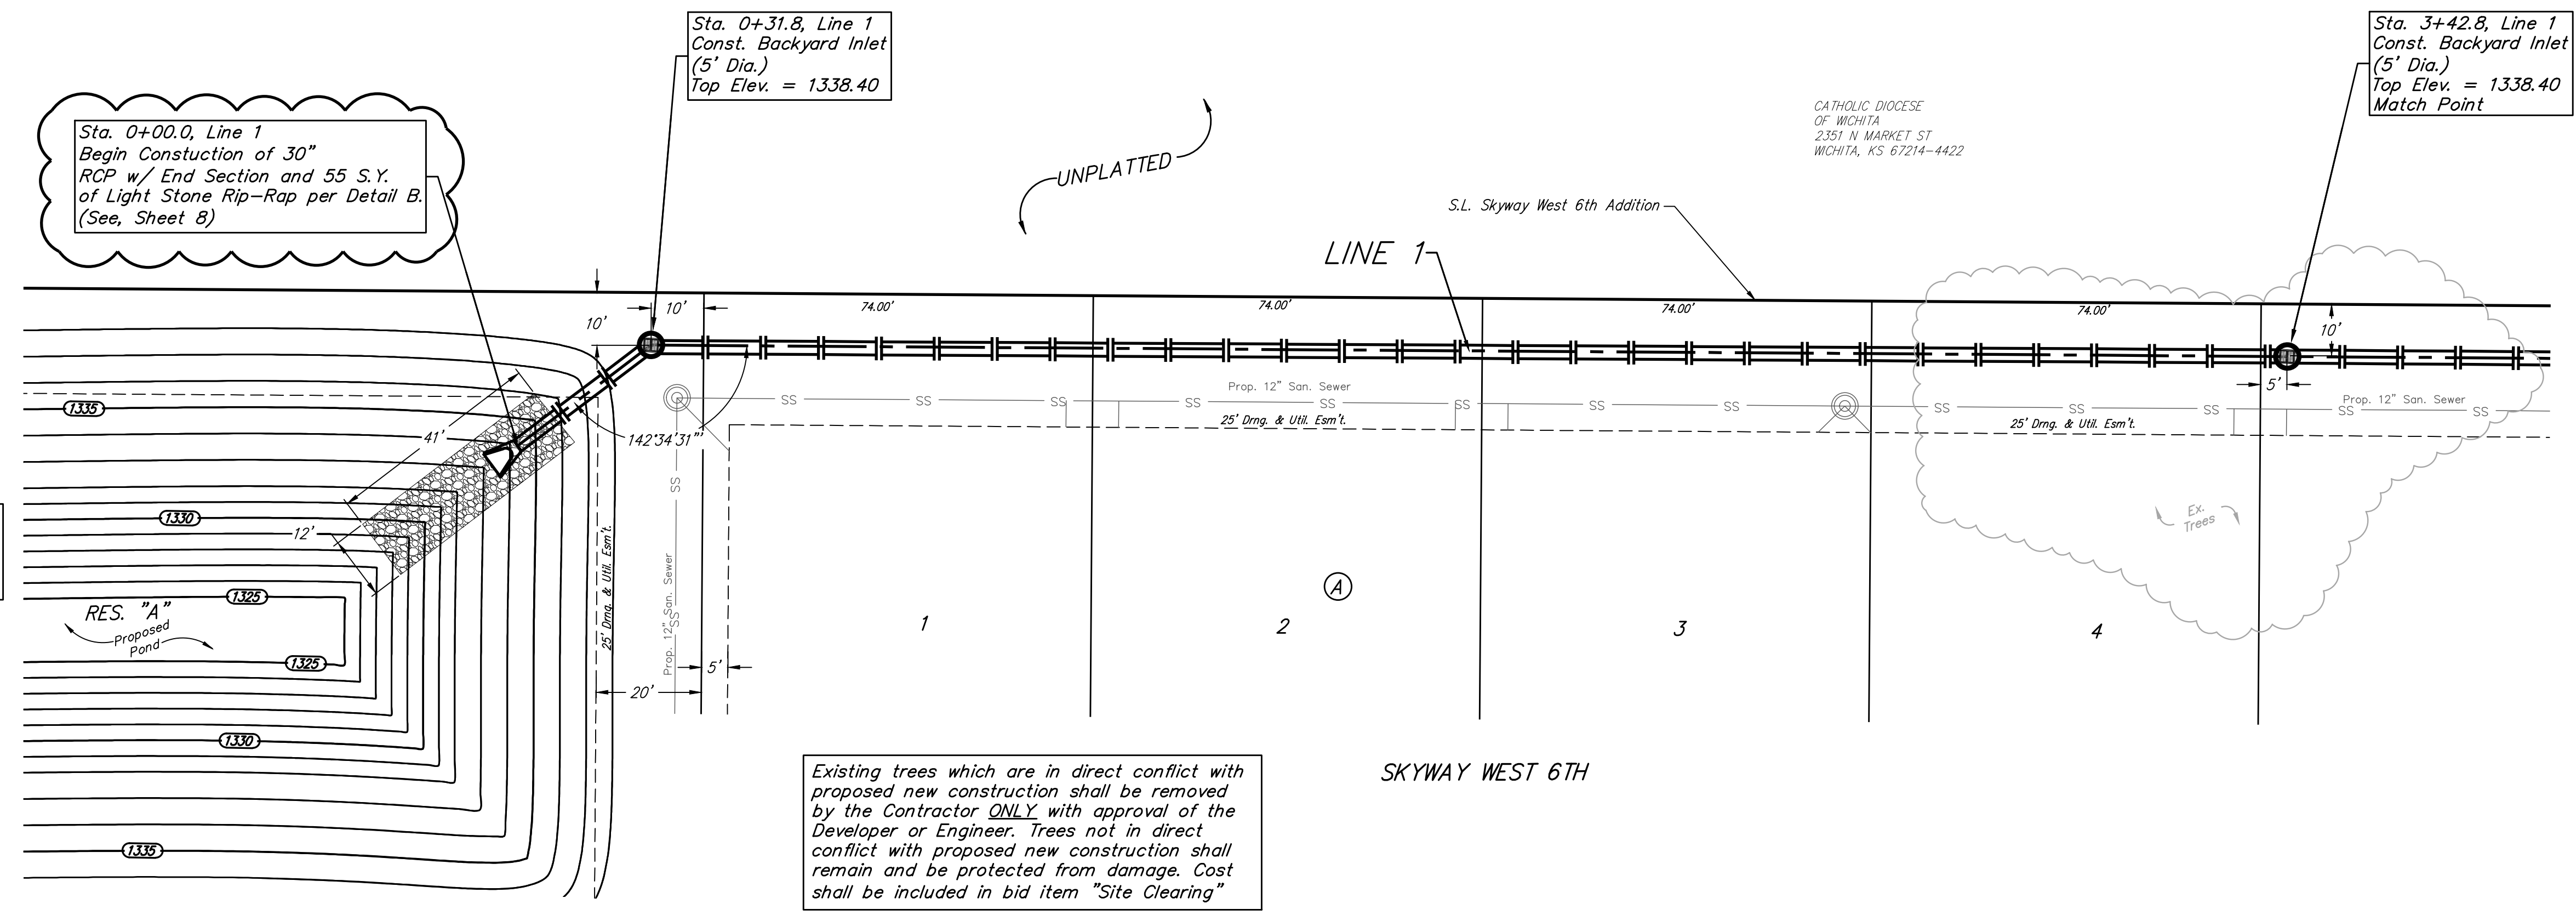
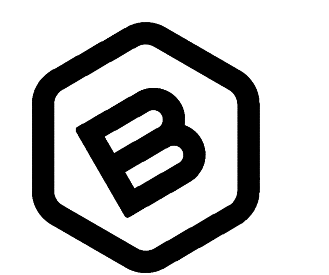


CATHOLIC DIOCESE
OF WICHITA
2351 N MARKET ST
WICHITA, KS 67214-4422

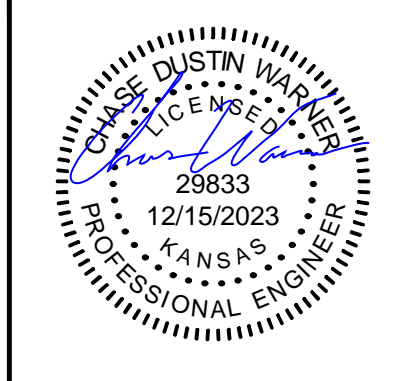

POND DATA:
100-YR ELEV. = 1336.9
STATIC ELEV. = 1332.4
BOTTOM ELEV. = 1325.0

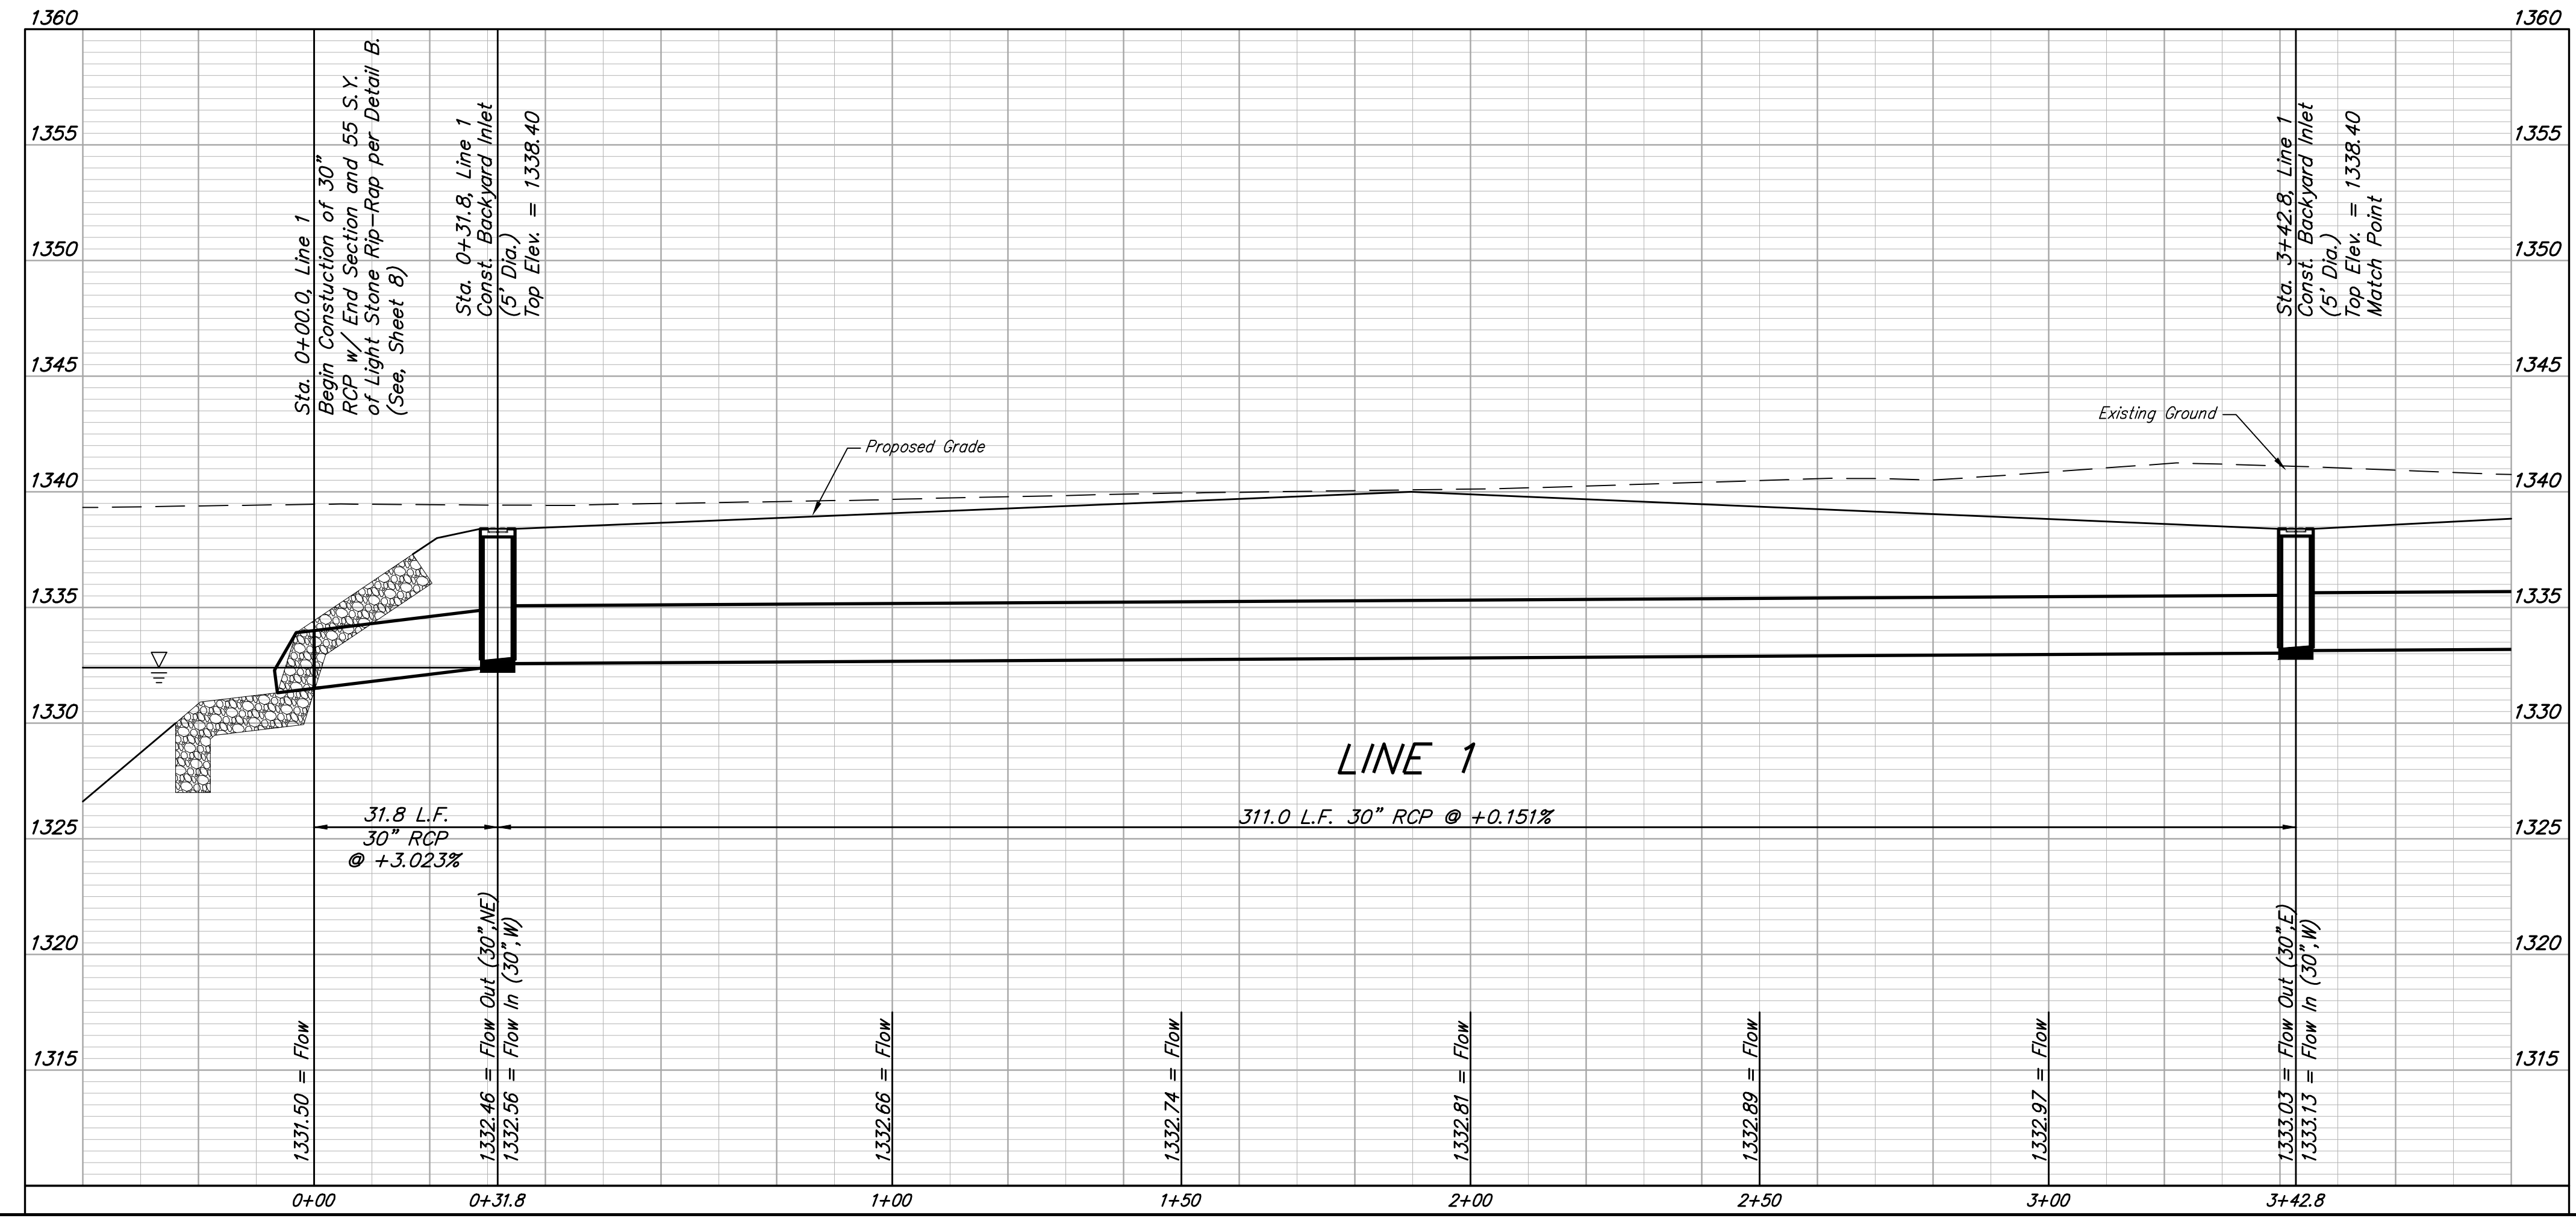

BAUGHMAN COMPANY
315 Ellis St.
Wichita, KS 67211
316-262-7271
BaughmanCo.com

SKYWAY WEST
6TH ADDITION

LINE 1

STORMWATER DRAIN
IMPROVEMENTS
PROJECT NUMBER:
458-2023-085537

DESIGN: CDW DRAWN: CDW
DATE: December 13, 2023

SHEET 02 OF 27

REVISION: Rip-Rap Detail Label Updated Date: 12/13/2023 By: CDW

File: E:\Projects\Skyway West 6th_22-05-P786\Engineering\Phase 1\SWD-SWS\SWD-SWS.dwg