

Sta. 0+71.9, End Line 4  
End Construction of 15" RCP  
w/ End Section & 34 S.Y. of Light  
Stone Rip-Rap as Indicated.

Sta. 0+00.0, Begin Line 4  
Core Ex. 4' Backyard  
Inlet & Extend 15" RCP  
(NW). Contractor to Verify  
Depth & Location of  
Existing Inlet Prior to  
Construction.  
To Be Bid as  
"Connect to Existing"  
Ex. Top Elev. = 1335.80

Evergy Elec. Box  
to Be Relocated Prior to  
Construction  
(See note, this Sheet.)

CAUTION!  
Evergy, AT&T, & Cox  
Crossing

Remove & Replace Existing Wood  
Fence as necessary for construction.  
Cost to be included in "Site Clearing"  
& "Site Restoration"






POND DATA:  
100-YR ELEV. = 1336.9  
STATIC ELEV. = 1332.4  
BOTTOM ELEV. = 1325.0

Contractor to verify depth and location of AT&T prior to construction. Coordinate with AT&T if relocation or temporary removal of equipment/lines is necessary. Contact Shannon Brinkmeyer (316-268-2931) a minimum of three weeks prior to construction.

Contractor to verify depth and location of Cox prior to construction. Coordinate with Cox if relocation or temporary removal of equipment/lines is necessary. Contact Ace Cruz (316-249-4494) a minimum of three weeks prior to construction.

Contractor to verify depth and location of Evergy prior to construction. Coordinate with Evergy if relocation or temporary removal of equipment/lines is necessary. Contact Heide Bryan (316-261-6354) a minimum of three weeks prior to construction.

**NOTE:**  
The Evergy electric box in conflict is to be relocated by Evergy and paid for by the Contractor as a bid item. The Contractor shall place \$10,000 in the lump sum bid item "Utility Relocation" and contact Heide Bryan (316-261-6354) for the precise cost of the relocation. If the amount for relocation is less than \$10,000, the bid item shall be reduced to meet the correct cost of relocation. Evergy will require 30 days to proceed with relocation work once payment is received.

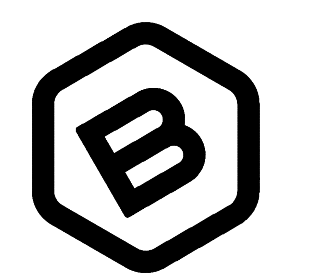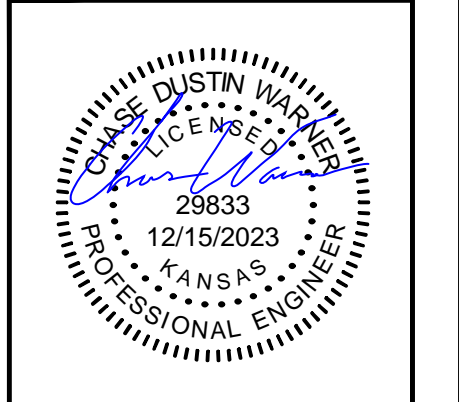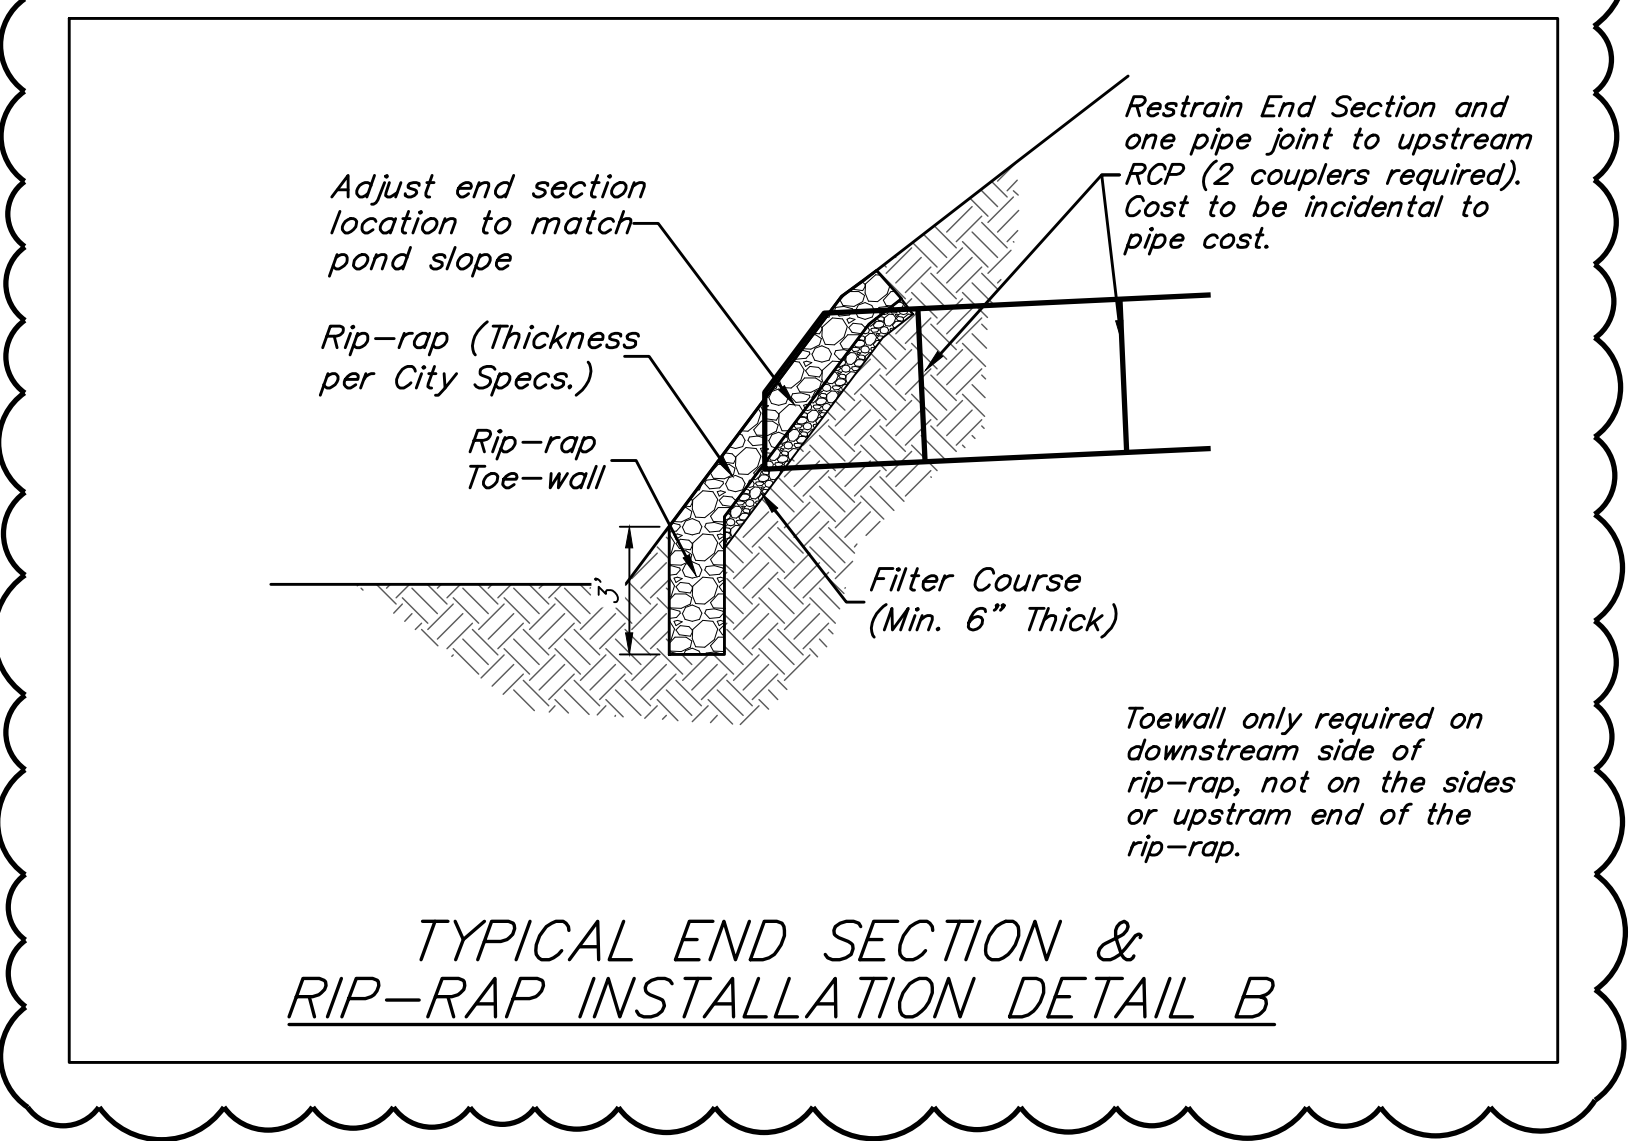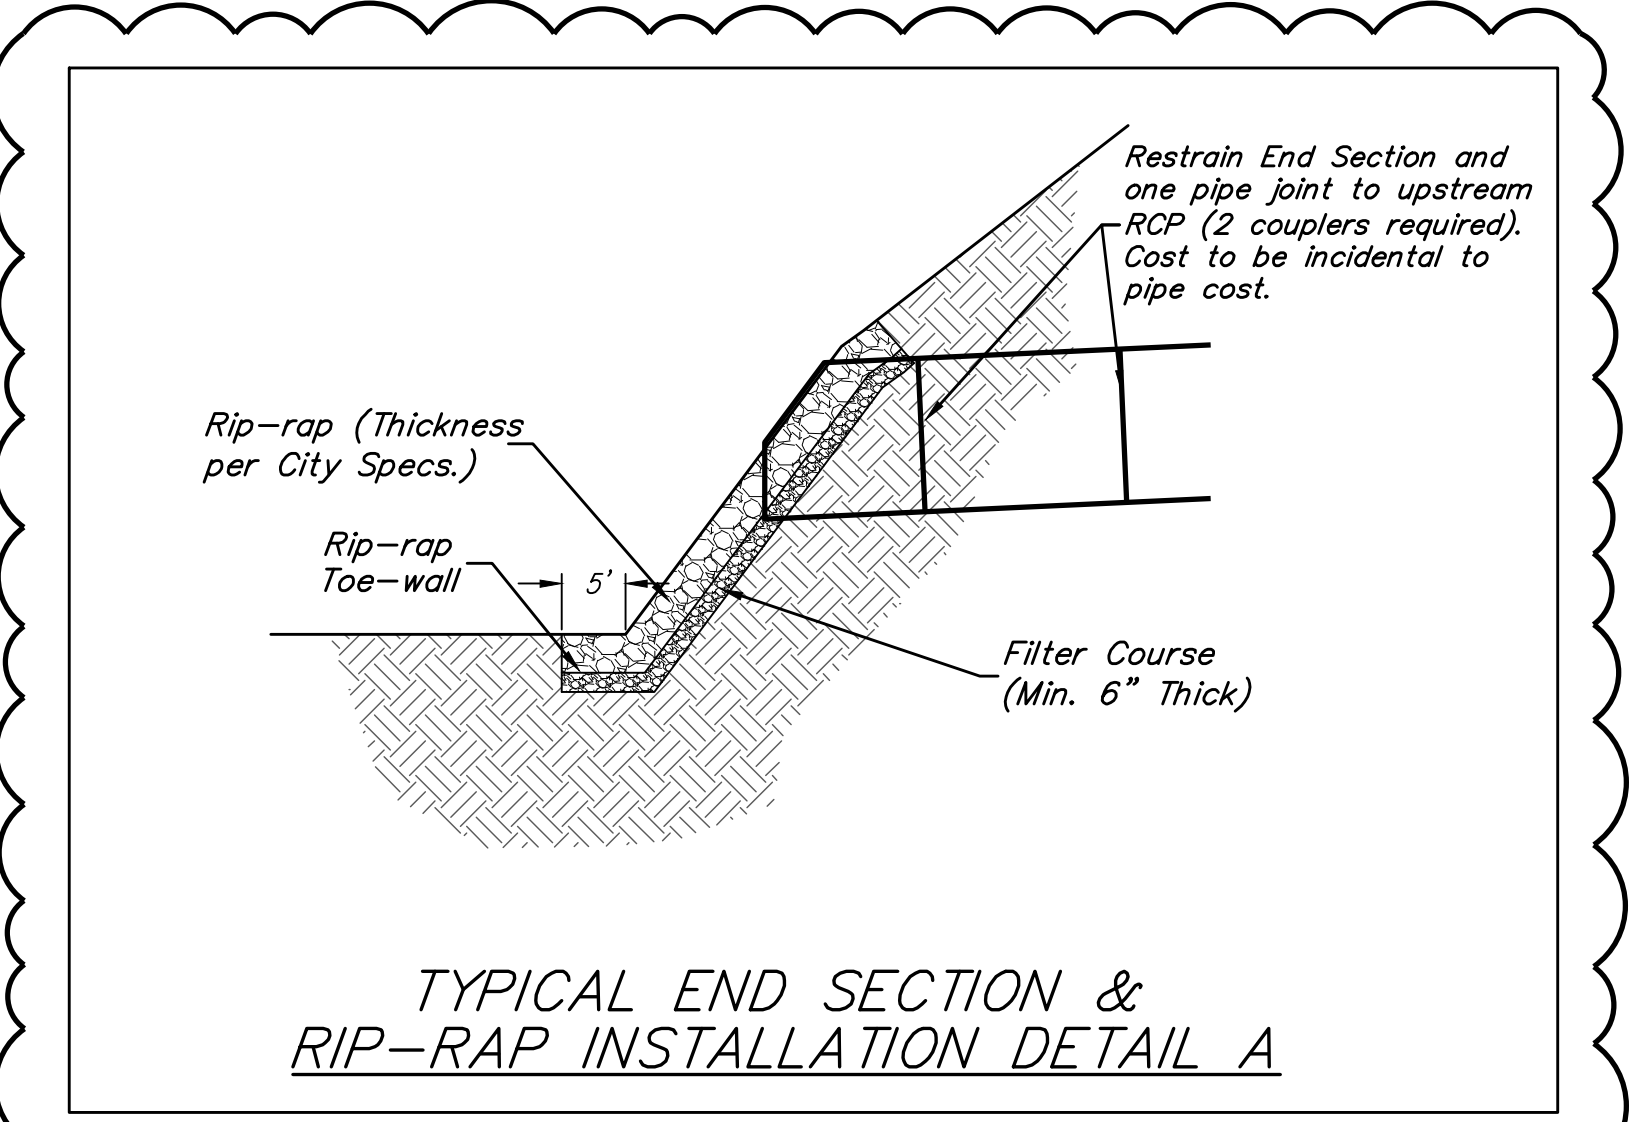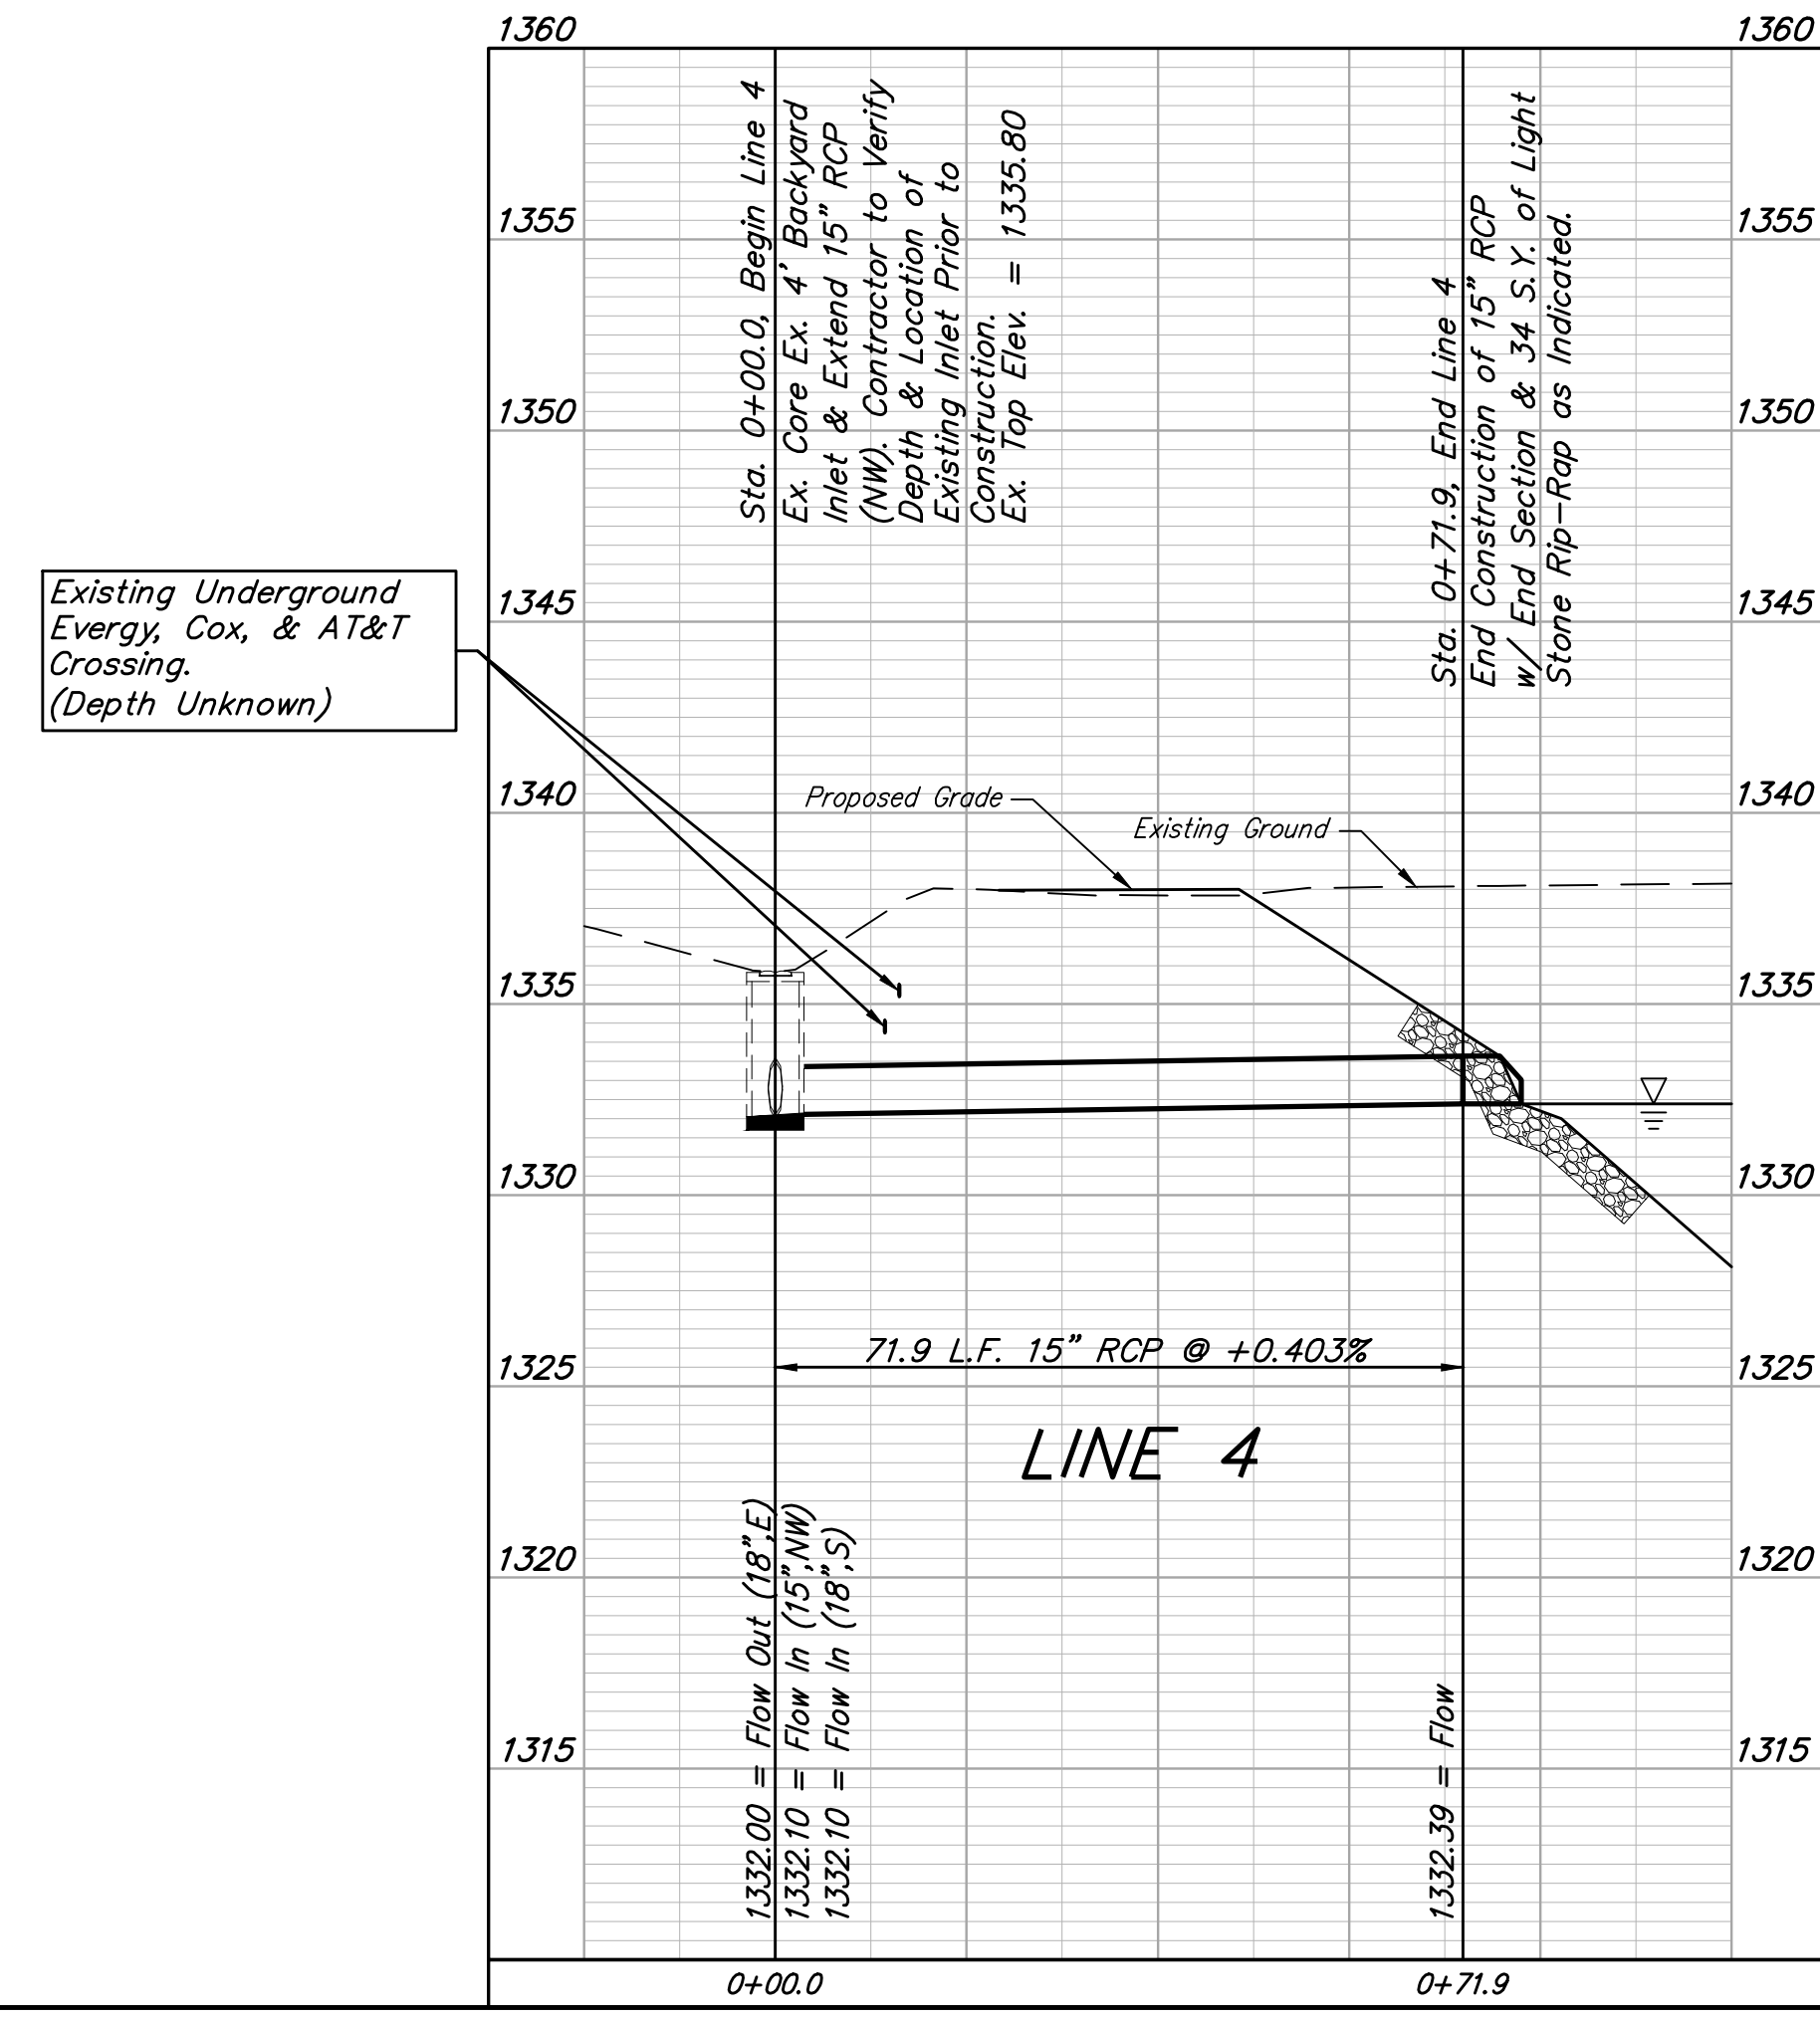

**BAUGHMAN COMPANY**  
315 Ellis St.  
Wichita, KS 67211  
316-262-7271  
BaughmanCo.com

SKYWAY WEST  
6TH ADDITION  
**LINE 4**  
STORMWATER DRAIN  
IMPROVEMENTS

PROJECT NUMBER:  
458-2023-085537  
DESIGN: CDW DRAWN: CDW  
DATE: December 13, 2023  
SHEET 08 OF 27

REVISION: Rip-Rap Details Added  
Date: 12/13/2023  
By: CDW

File: E:\Projects\Skyway West 6th\_22-05-P786\Engineering\Phase 1\SWD-SWWS\SWS-SWS.dwg