
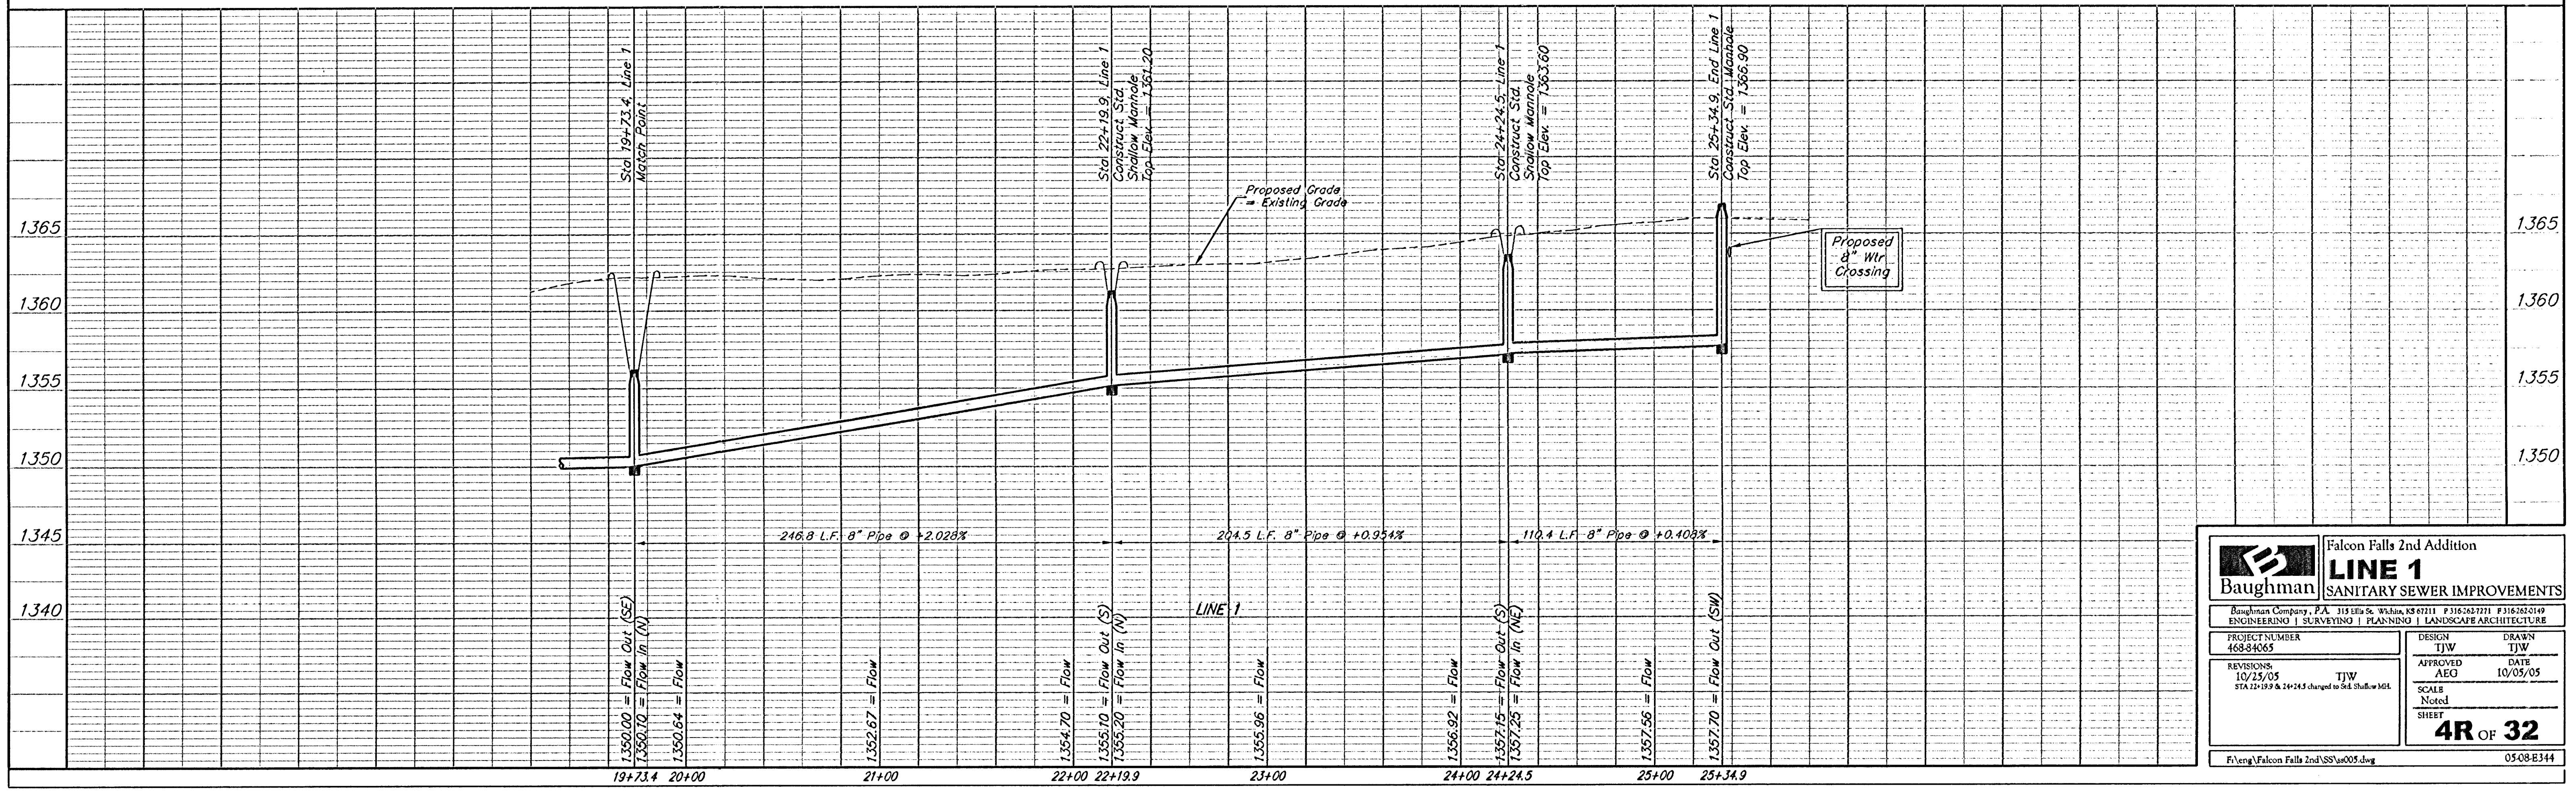


BENCHMARKS

BM #1: Brass Plate on North
Hub Guard of R.C.B.C., 50' East of
NW Corner NE 1/2, Sec. 22, Twp.
26-S, R-1-E.
Elev. = 1371.83 (NGVD29)

BM #2: "X" cut on East Hub
Guard of R.C.B.C., 110' S. of the
SE Cor., SE 1/4, Sec. 22, Twp.
26-S, R-1-E.
Elev. = 1359.54 (NGVD29)

Scale: 1" = 40' Horizontal
1" = 5' Vertical
• = Iron

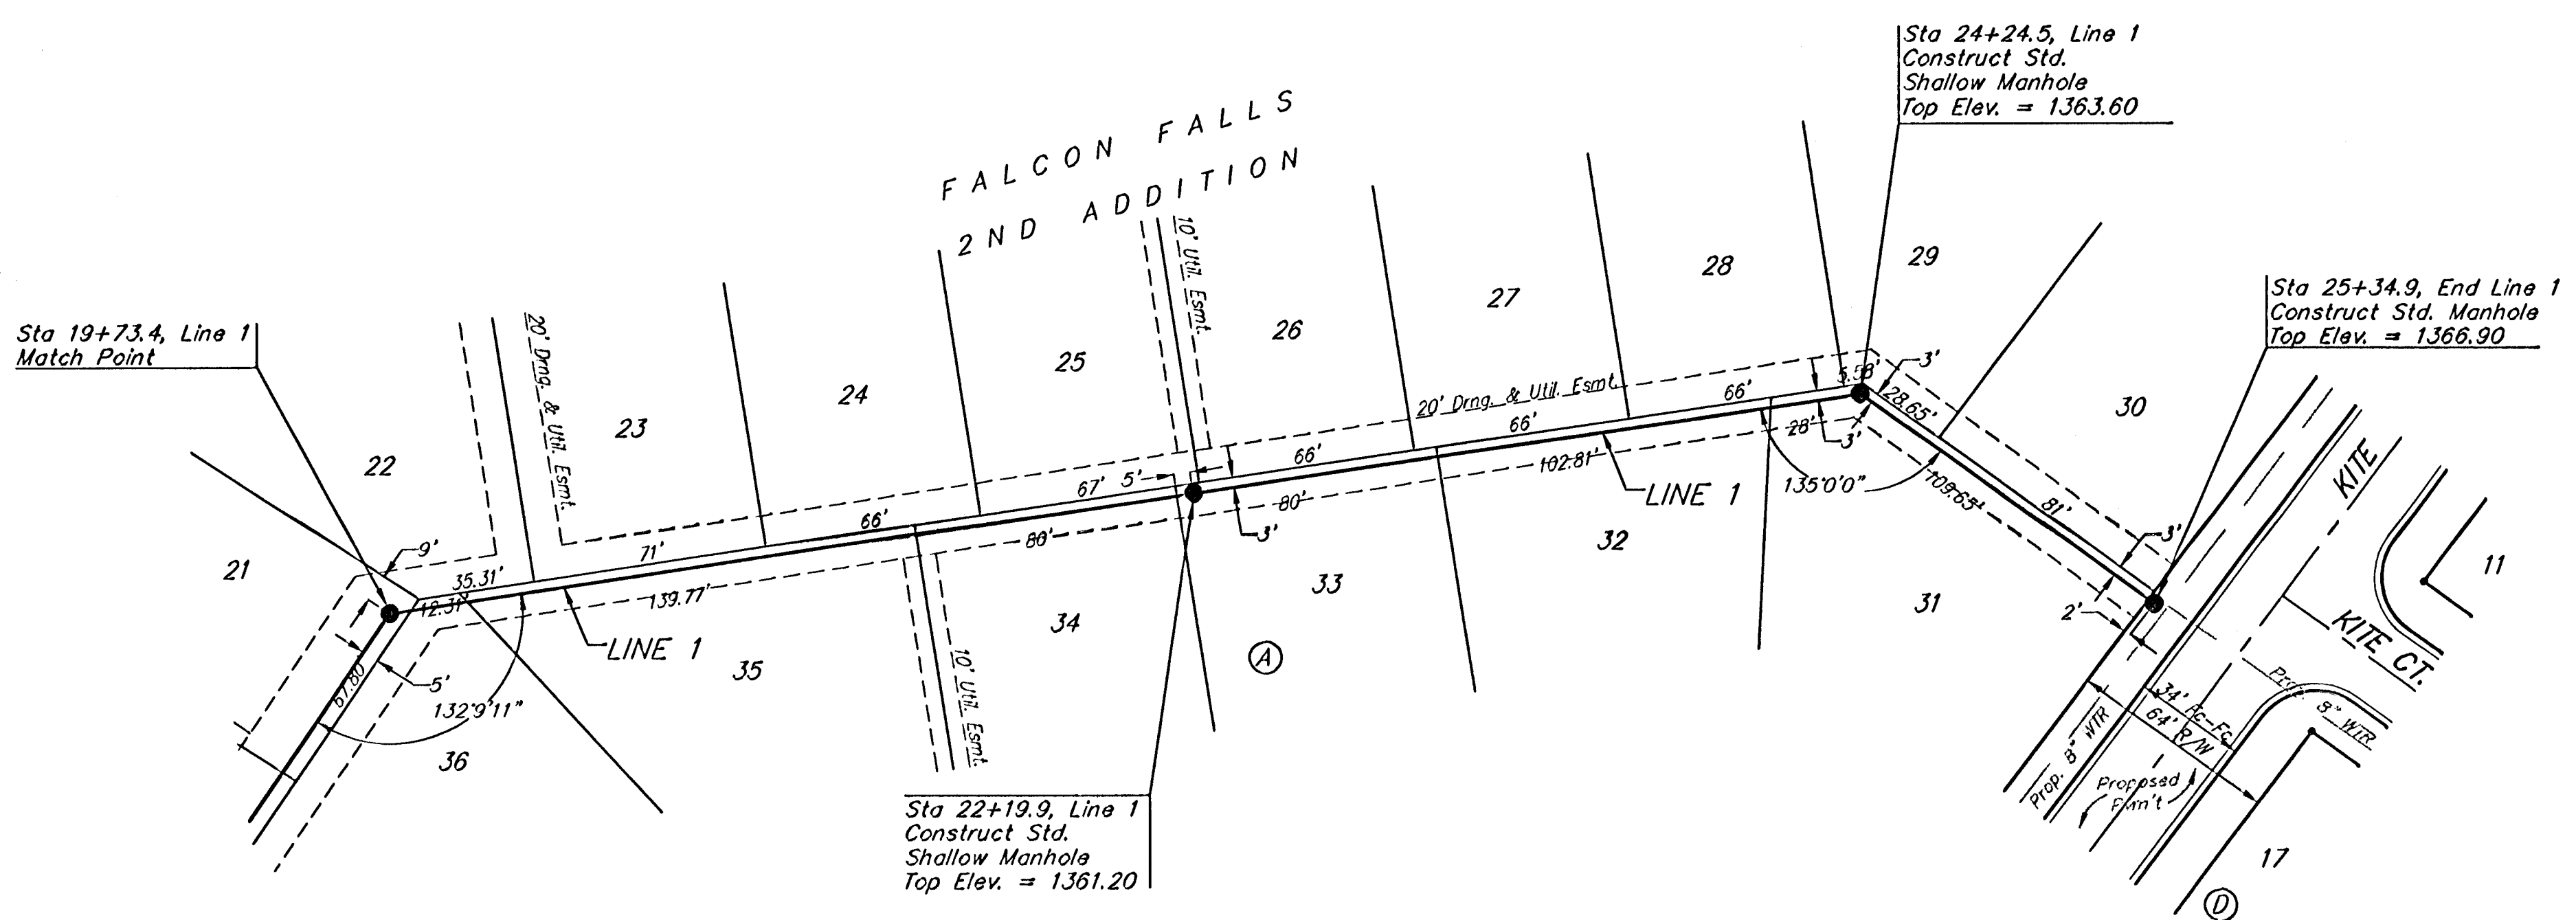

Baughman		Falcon Falls 2nd Addition	
LINE 1		SANITARY SEWER IMPROVEMENTS	
Baughman Company, P.A. 315 Ellis St. Wichita, KS 67211 P 316-263-7271 F 316-262-0149 ENGINEERING SURVEYING PLANNING LANDSCAPE ARCHITECTURE			
PROJECT NUMBER 468-8465	DESIGN TJW	DRAWN TJW	
REVISIONS 10/25/05 STA 19+73.4 & 24+24.5 changed to Std. Shallow Manhole	APPROVED AEO	DATE 10/05/05	
SCALE Noted		SHEET 4R OF 32	
F:\eng\Falcon Falls 2nd\SS\ss005.dwg		0508-B344	