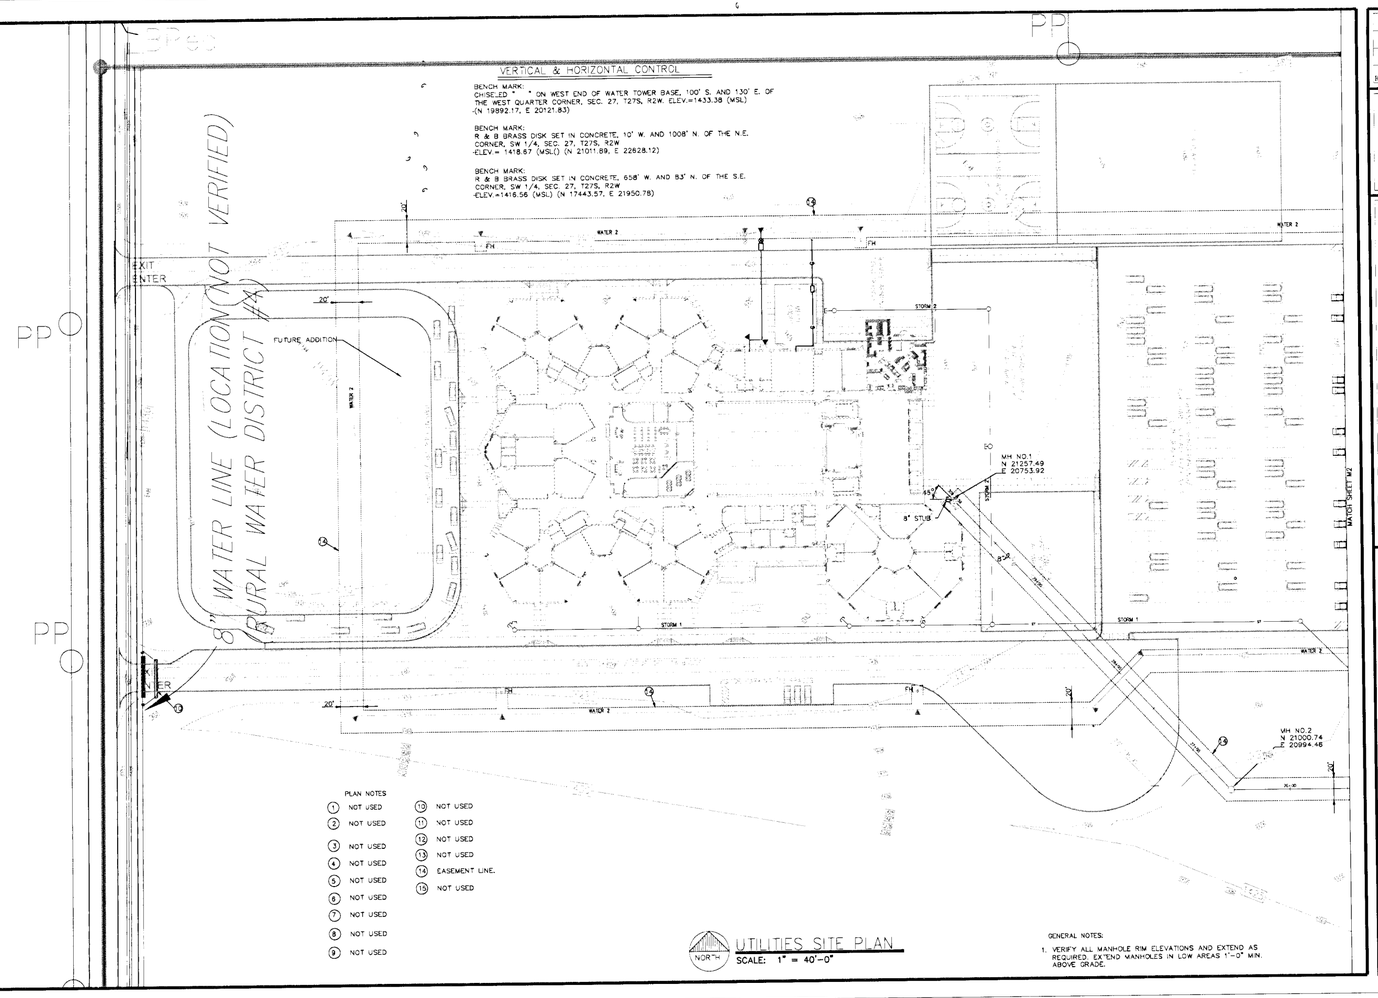

REVISION	DATE	BY

WILSON & COMPANY
Engineers & Architects
1700 Farnam Drive Salina, Kansas 67401 Tel 785 827-0433 Fax 785 827-0949

GODDARD FACILITY IMPROVEMENTS
#1 - New Elementary School
GODDARD PUBLIC SCHOOLS U.S.D. No. 265
201 S. MAIN, GODDARD, KANSAS

DESIGN	JLL
DRAWN	DFP
DATE	JUNE 2005
FILE NO.	X4-420-078
SHEET NO.	