



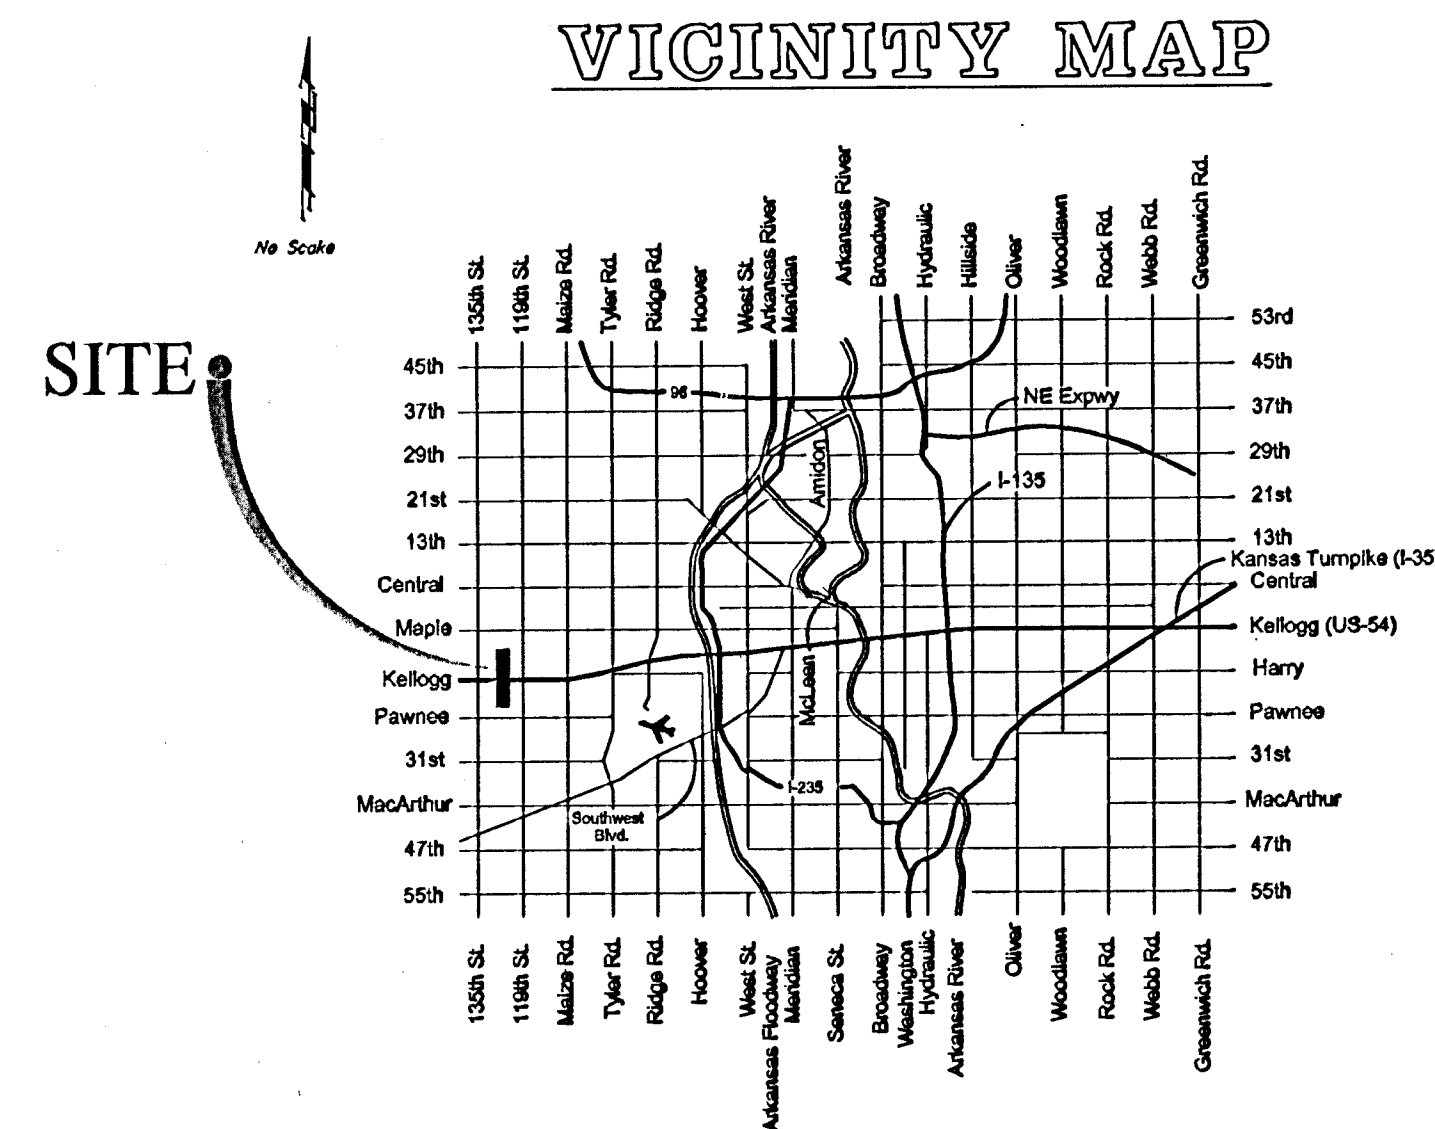

INDEX

Title Sheet	1
General Notepage & Keysheet	2
SS Plan/Profile Sheets	3-11
Type "P" Manhole Details	12
Manhole Ring & Cover Details	13
Erosion Controls Details	14-16

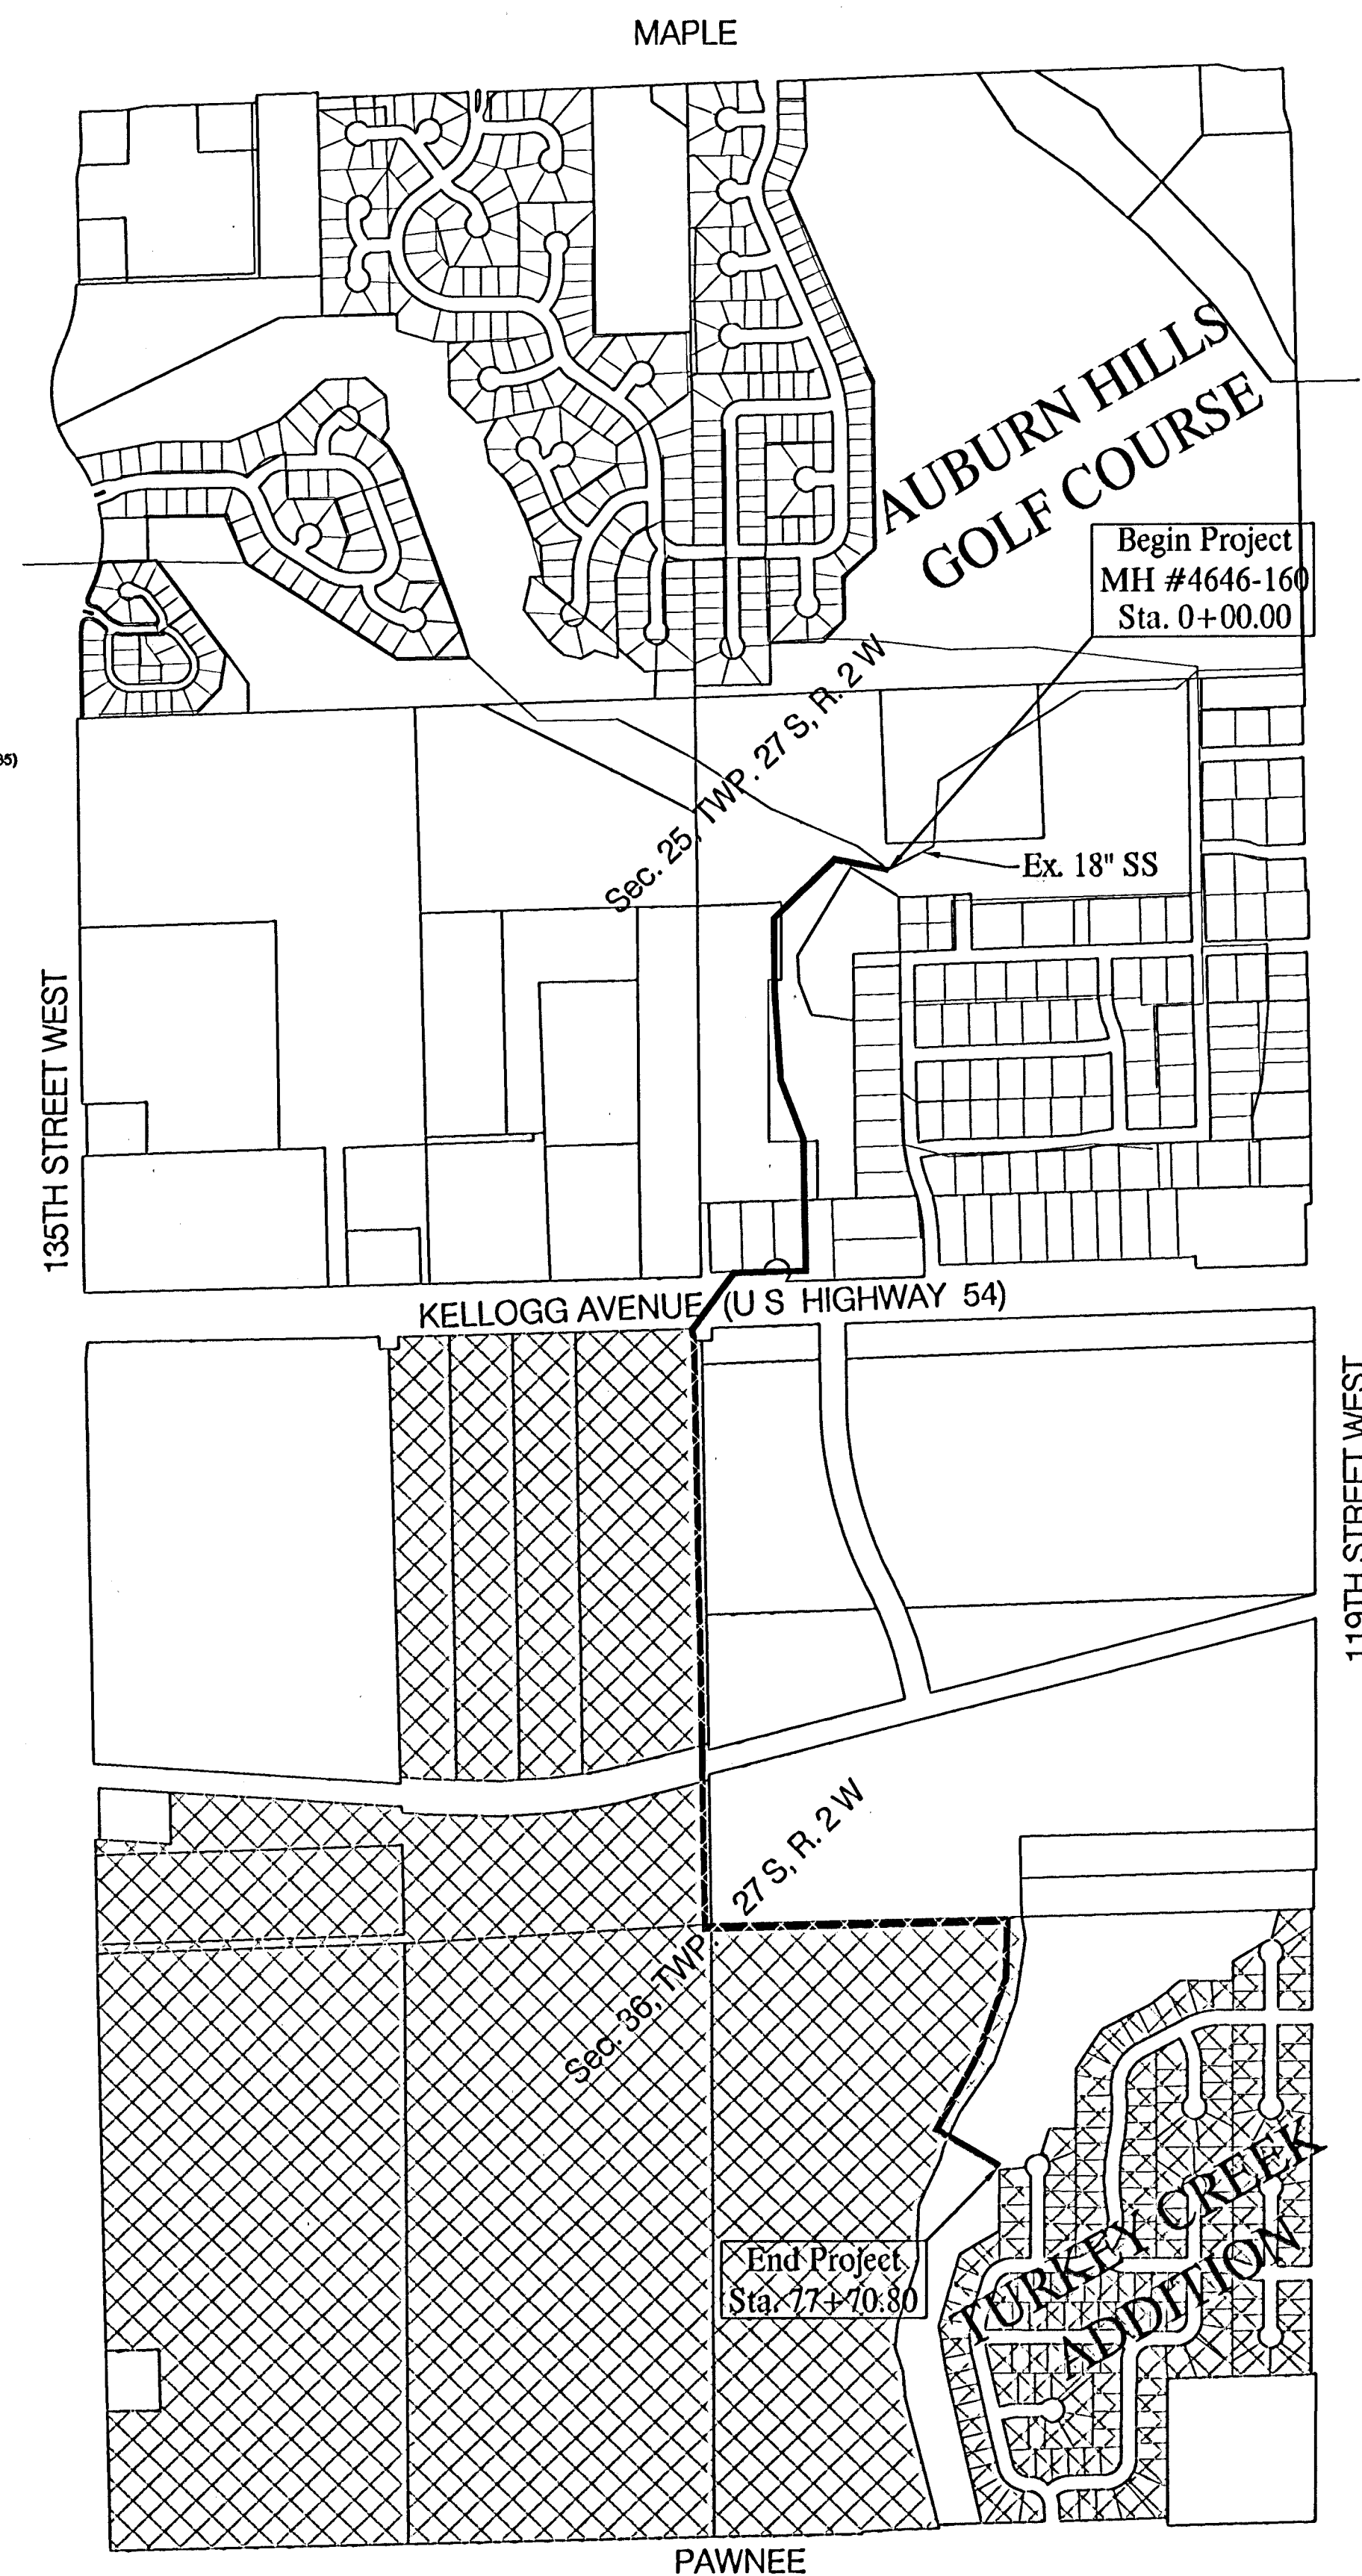

SANITARY SEWER COLLECTION SYSTEM IMPROVEMENTS MAIN 6, COWSKIN INTERCEPTOR SEWER to serve TURKEY CREEK ADDITION

Project No.


468-83817

CITY OF WICHITA, KANSAS

James L. Armour, City Engineer

August 2005

Mies Construction, Inc. - Contractor
Hartman, City - Inspector
Released 2/22/06
Per Plan
Stubs
.pdf by JDL 4/26/06

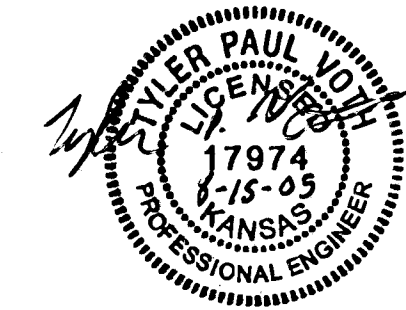

Benefit District

