



Benchmarks:
BM #1: "x" on the West End of the Steel Casing Pipe at the Railroad Crossing South of 37th Street North Sta. 25+90, 41' Rt. Elev. = 149.18 (1336.58 MSL)
BM #2: Steel T-Post Driven 4' Deep Sta. 18+00, 25' Rt. Elev. = 150.33 (1337.73 MSL)
BM #3: "□" in the Concrete Footing of the SBC Pedestal in the South West Corner of 37th Street North and Tyler Road Sta. 8+56, 95' Rt. Elev. = 154.77 (1342.17 MSL)
BM #4: Railroad Spike in the East Face of the 2nd Power Pole North of 37th Street and West of Tyler Road Sta. 94+24, 48' Lt. Elev. = 155.45 (1342.85 MSL)

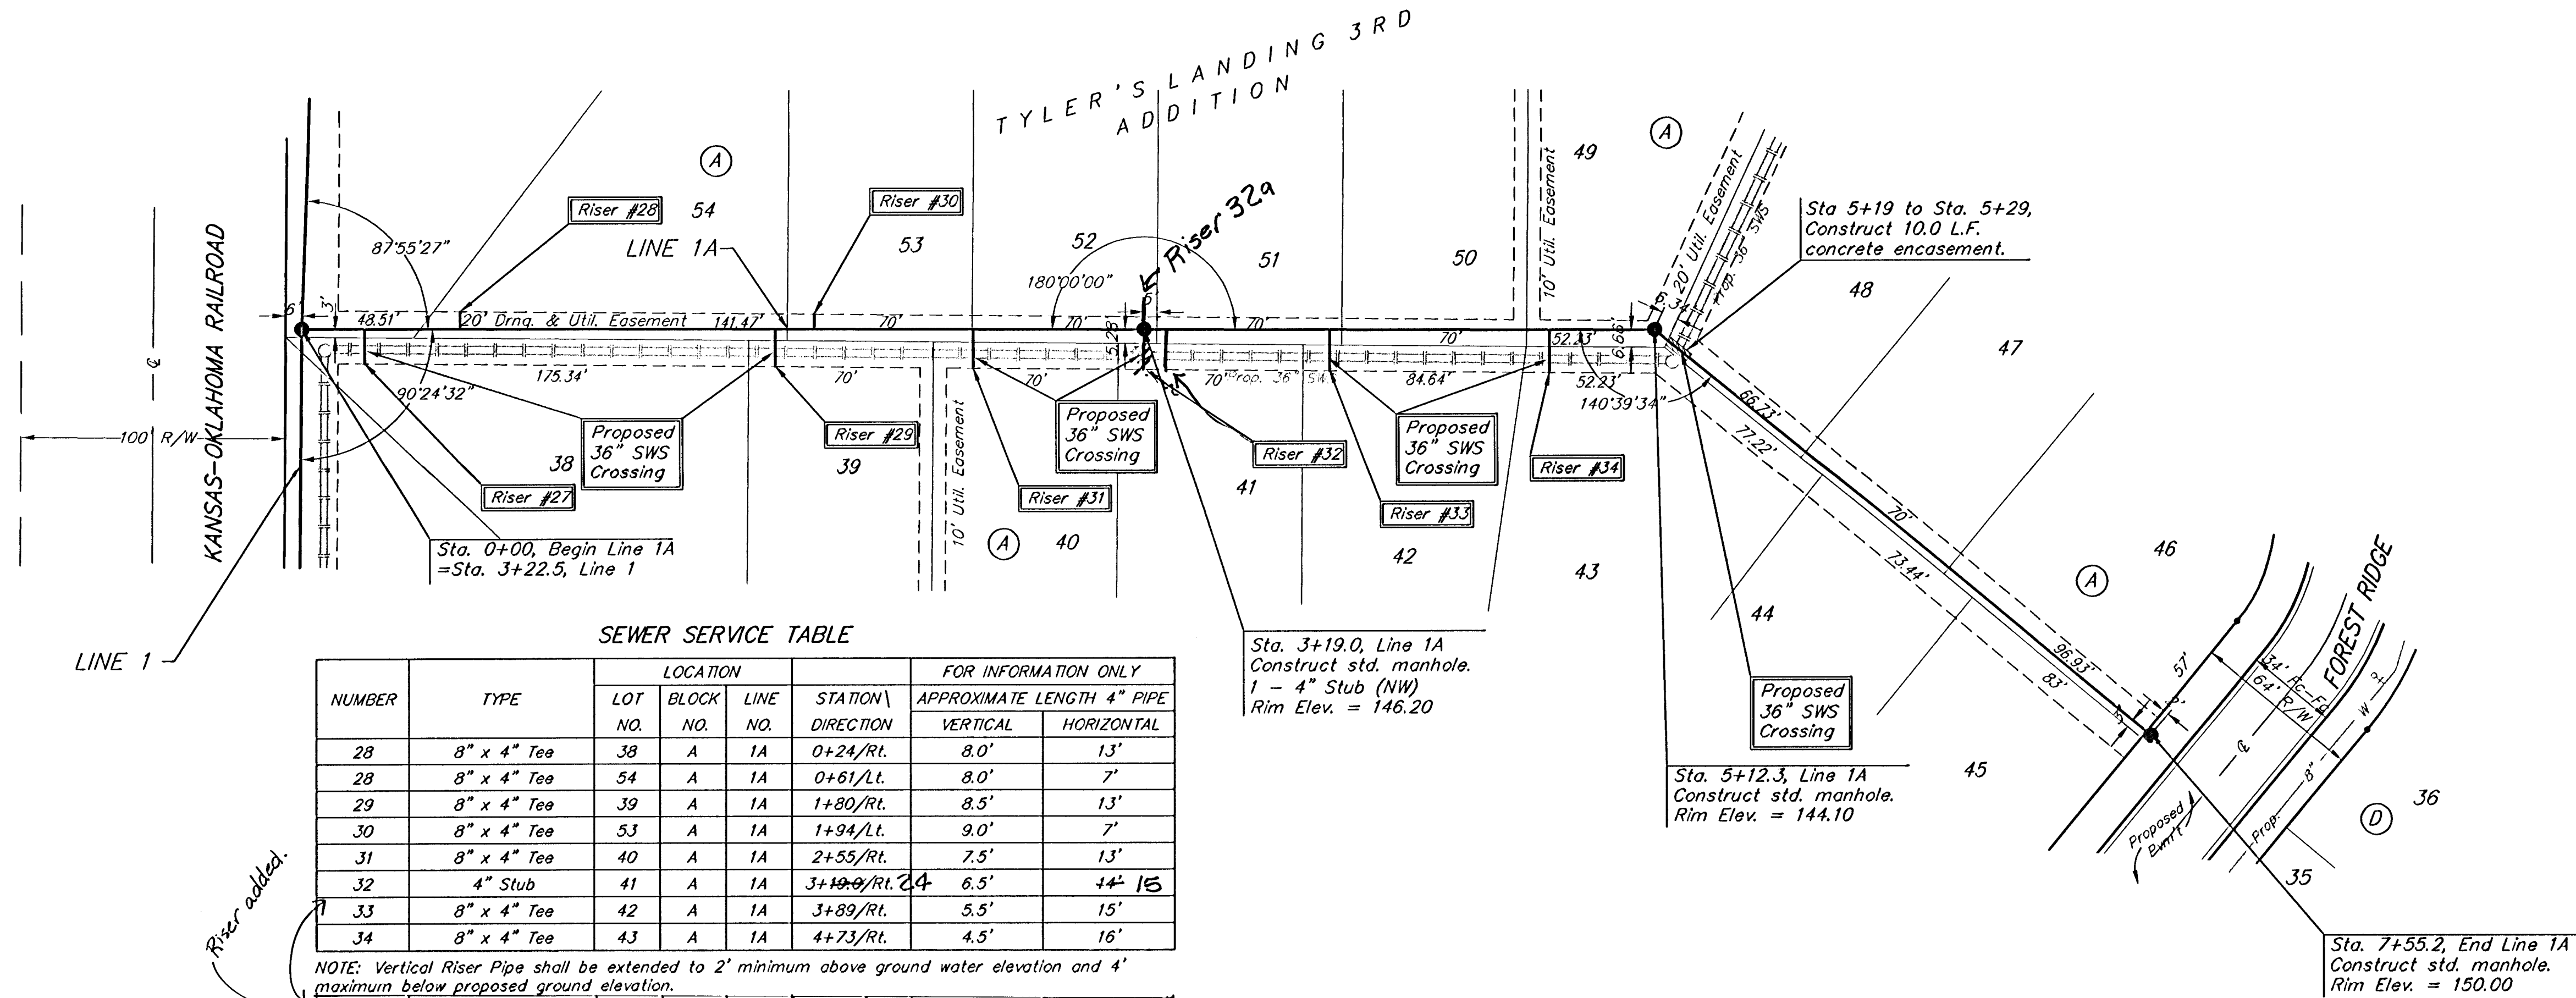

NUMBER	TYPE	LOCATION				FOR INFORMATION ONLY	
		LOT NO.	BLOCK NO.	LINE NO.	DIRECTION	APPROXIMATE LENGTH 4" PIPE	
29	8" x 4" Tee	39	A	1A	1+80.00 Rt.	8.5'	13'
30	8" x 4" Tee	53	A	1A	1+94.00 Lt.	9.0'	7'
31	8" x 4" Tee	40	A	1A	2+55.00 Rt.	7.5'	13'
32	4" Stub	41	A	1A	3+19.00 Rt. 24	6.5'	14' 15
33	8" x 4" Tee	42	A	1A	3+89.00 Rt.	5.5'	15'
34	8" x 4" Tee	43	A	1A	4+73.00 Rt.	4.5'	16'

NOTE: Vertical Riser Pipe shall be extended to 2' minimum above ground water elevation and 4' maximum below proposed ground elevation.

32a	8" x 4" Tee	52	A	1A	3+19.00 Lt.	5'	
-----	-------------	----	---	----	-------------	----	--

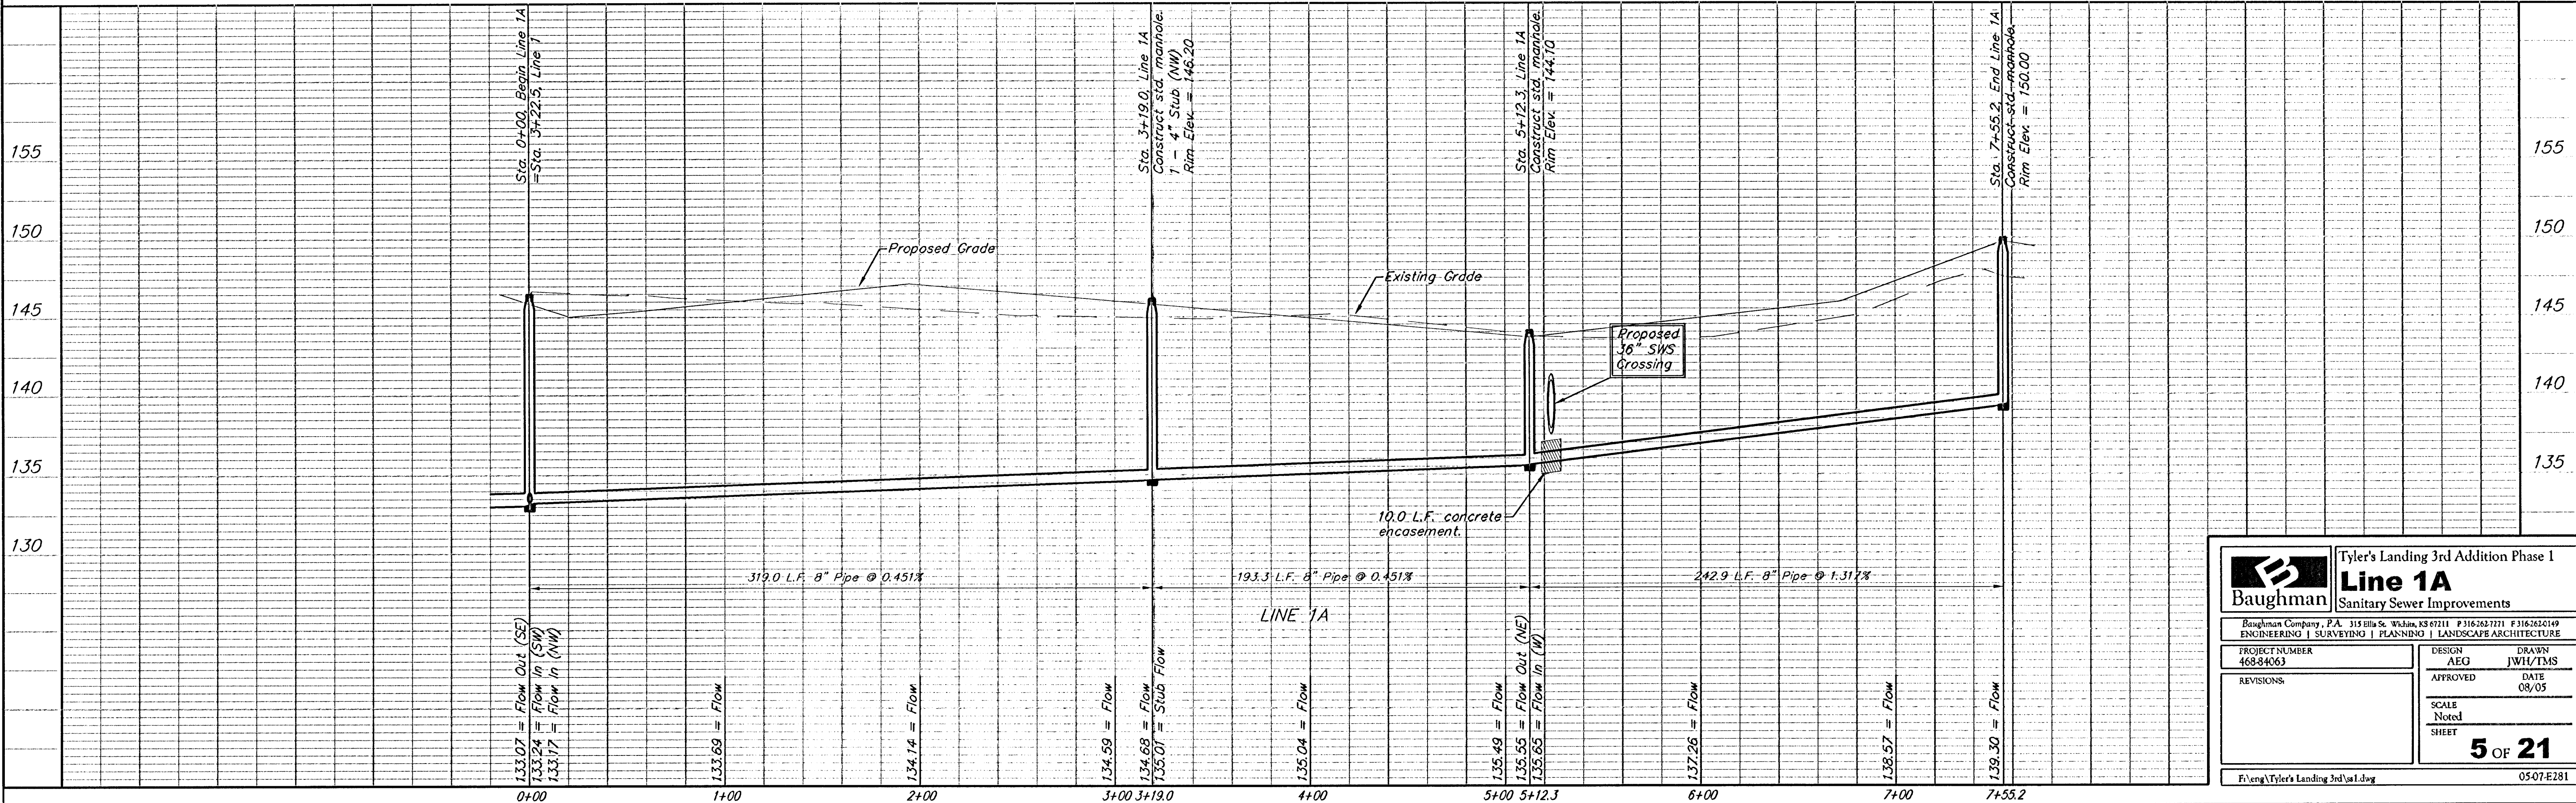

Tyler's Landing 3rd Addition Phase 1
Line 1A
Sanitary Sewer Improvements

PROJECT NUMBER
46834063

DESIGN
AEG

APPROVED
DATE
08/05

REVISIONS

BAUGHMAN COMPANY, P.A.
ENGINEERING & SURVEYING | PLANNING | LANDSCAPE ARCHITECTURE

315 Ellis St. Wichita, KS 67211 P: 316.262.7711 F: 316.262.0149

SCALE
Noted
SHEET
5 OF 21

F:\eng\Tyler's Landing 3rd\sa1.dwg

0507-E281