


BM #2: COW Disc in top of curb adjacent to the fire hydrant on the west side of Westgate along the southwesterly line of Lot 13, Block B, Southern Ridge Addition. Elev. = 144.10 (City Datum)



-Scale: 1" = 40' Horizontal
1" = 5' Vertical
• = Iron

Note: Risers follow future Southern Ridge 4th Add. lot lines.

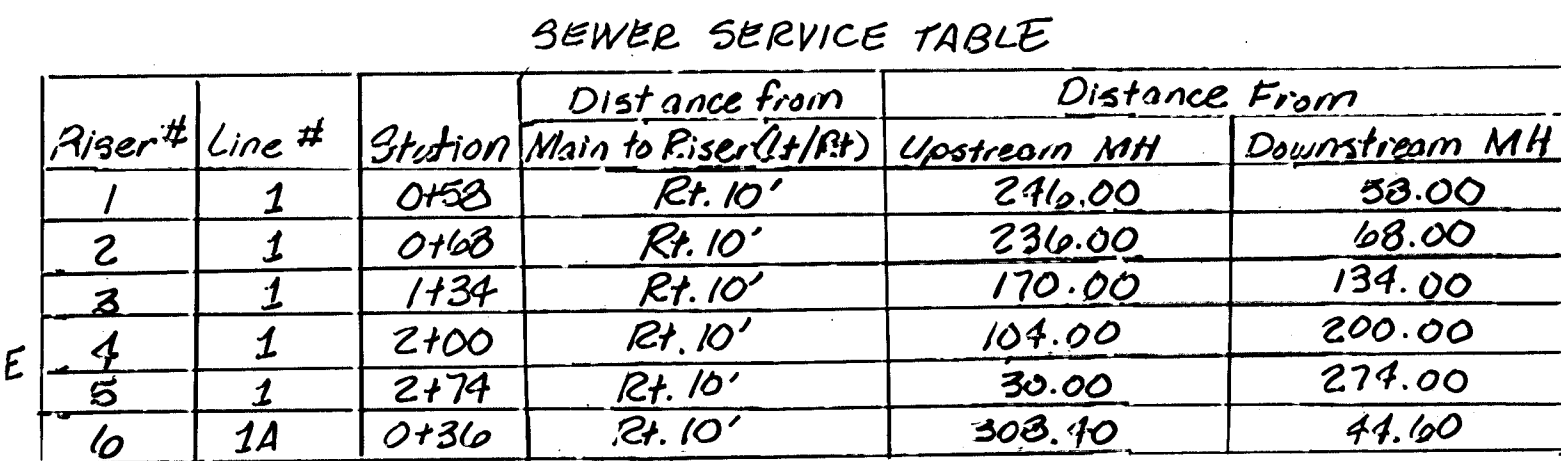