
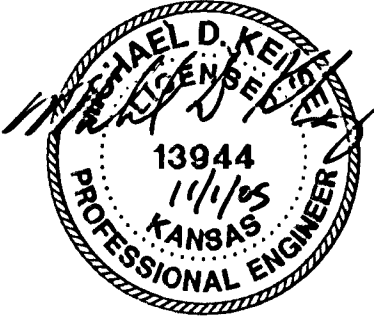
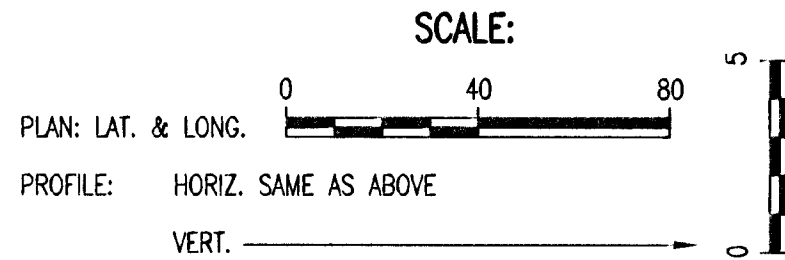
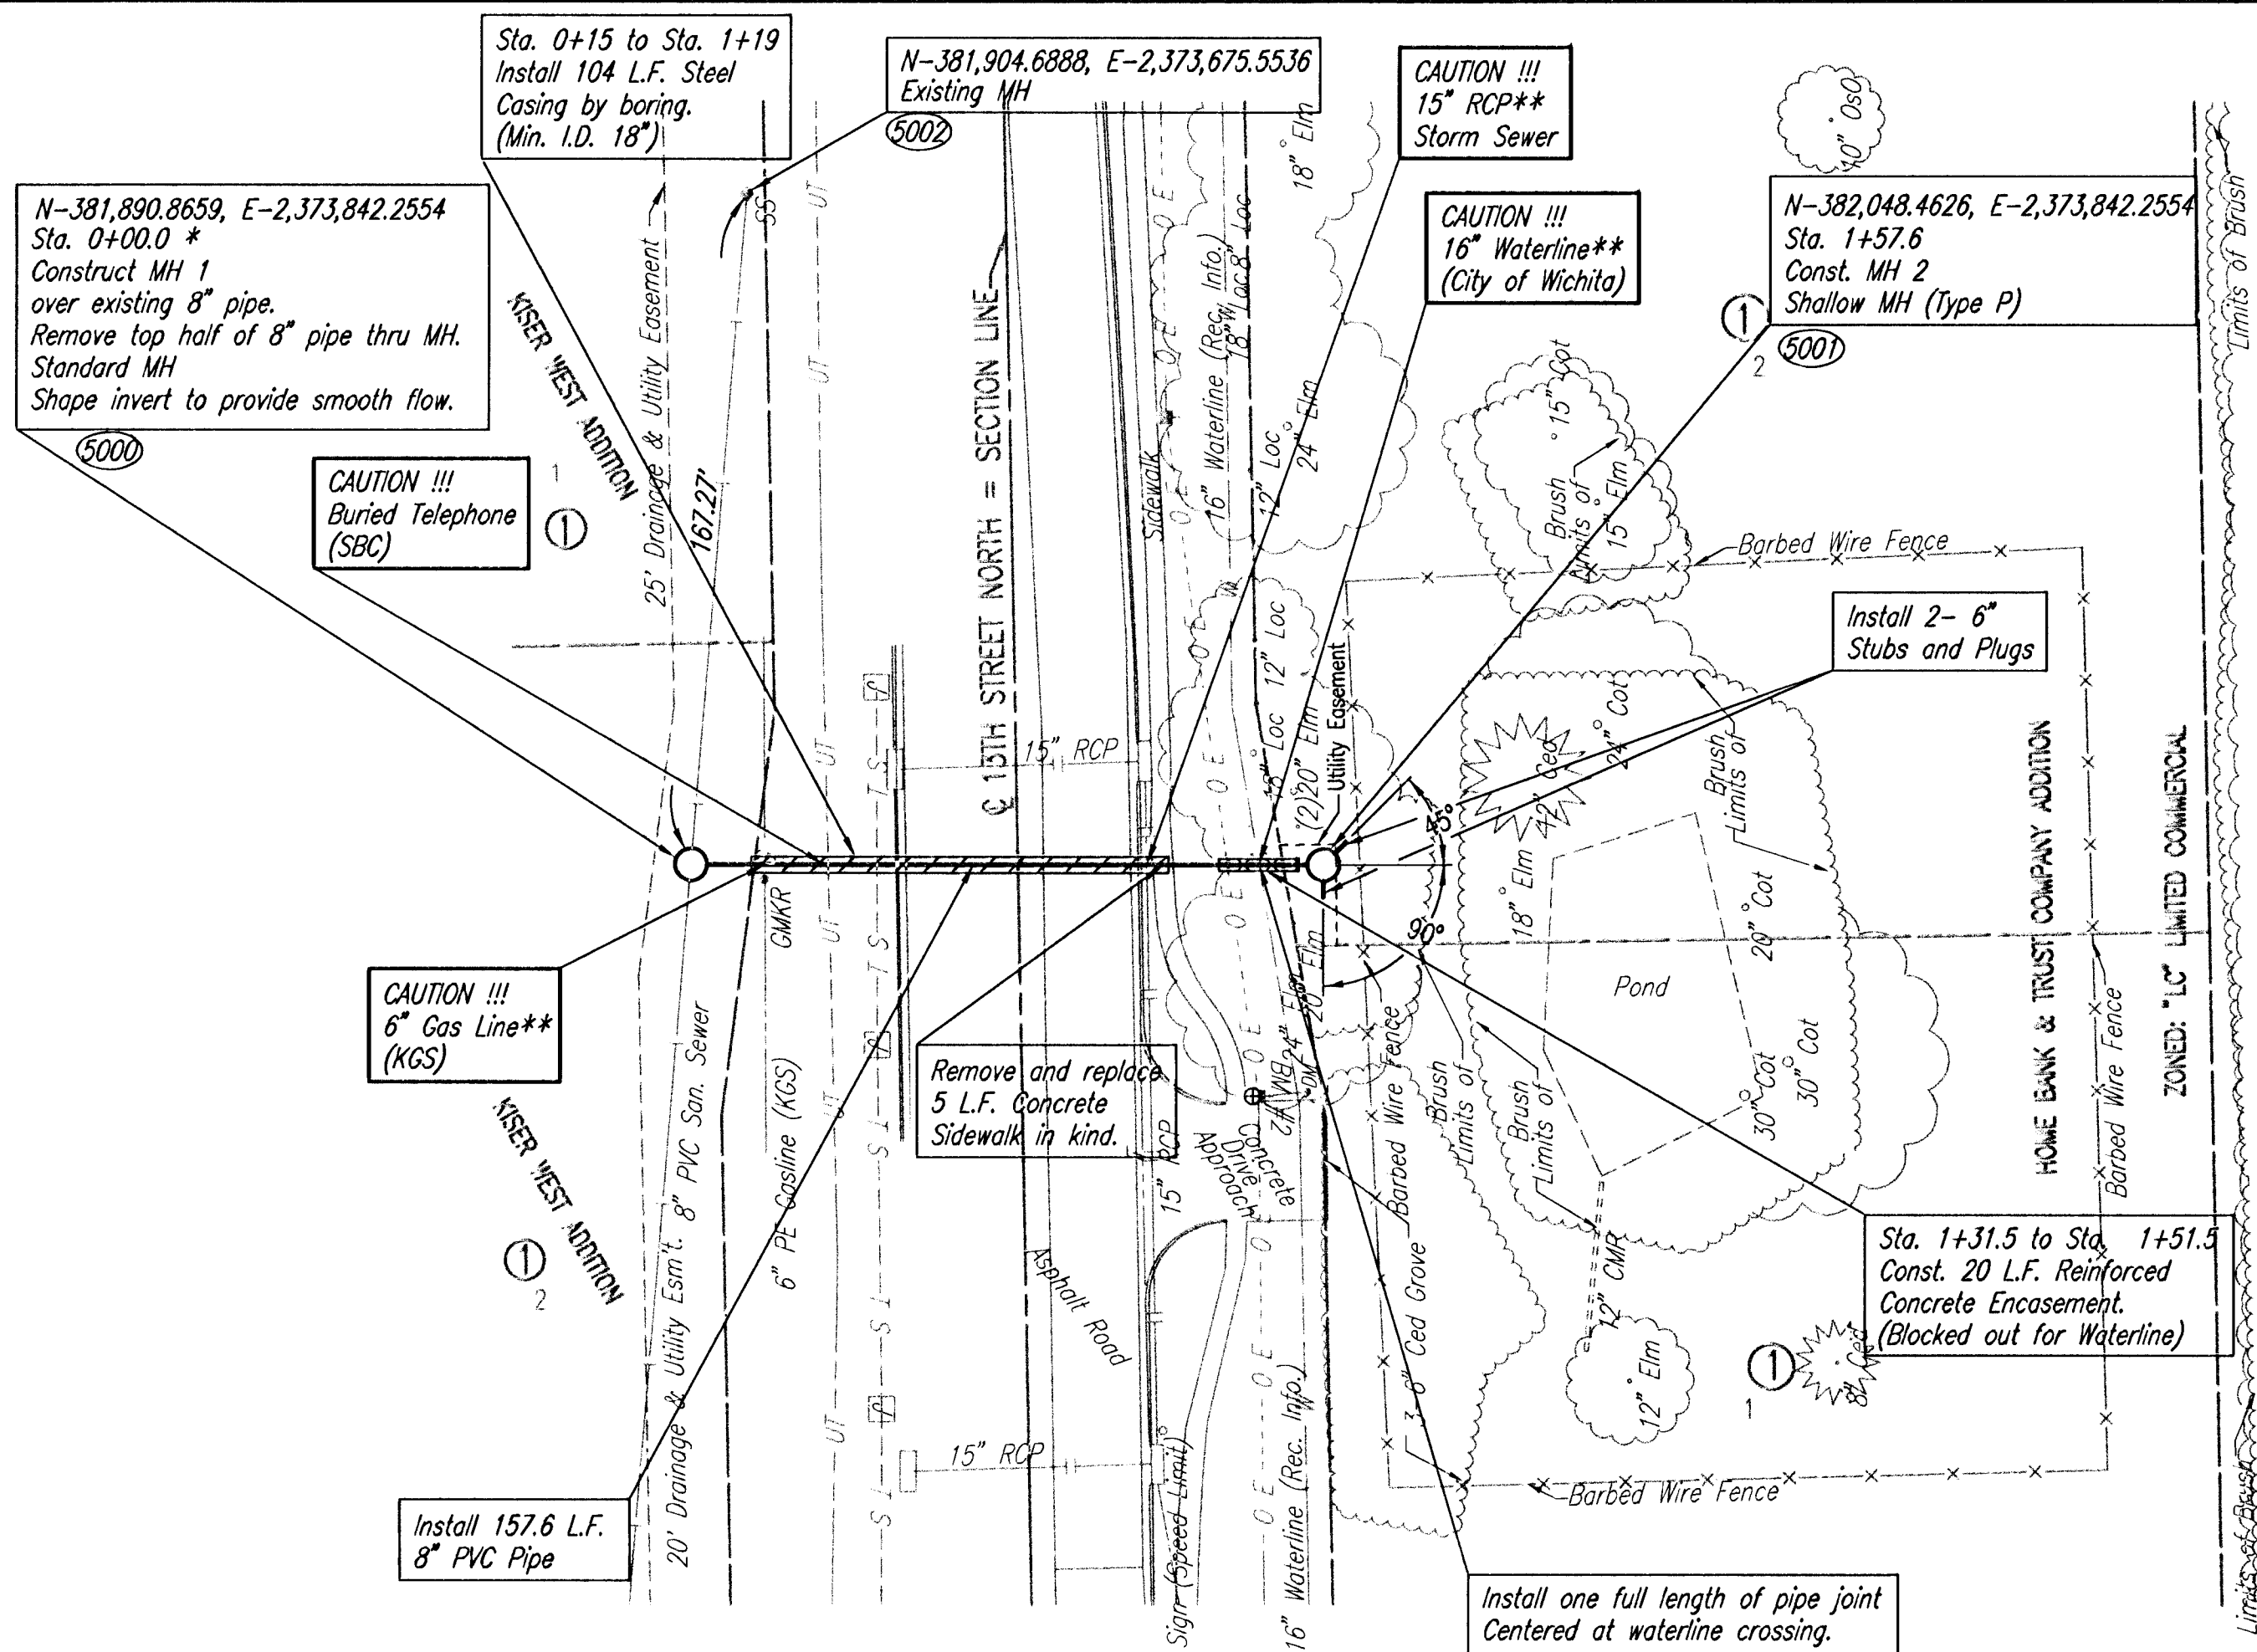


PLAN	CHECKED	DATE

PROFILE	CHECKED	DATE

DSNR: MDK OPER: REF SCALE: 1"=40.00
 Q:\2005\05582\05582-000-C-SSPP01 11-01-2005 11:24:39 am

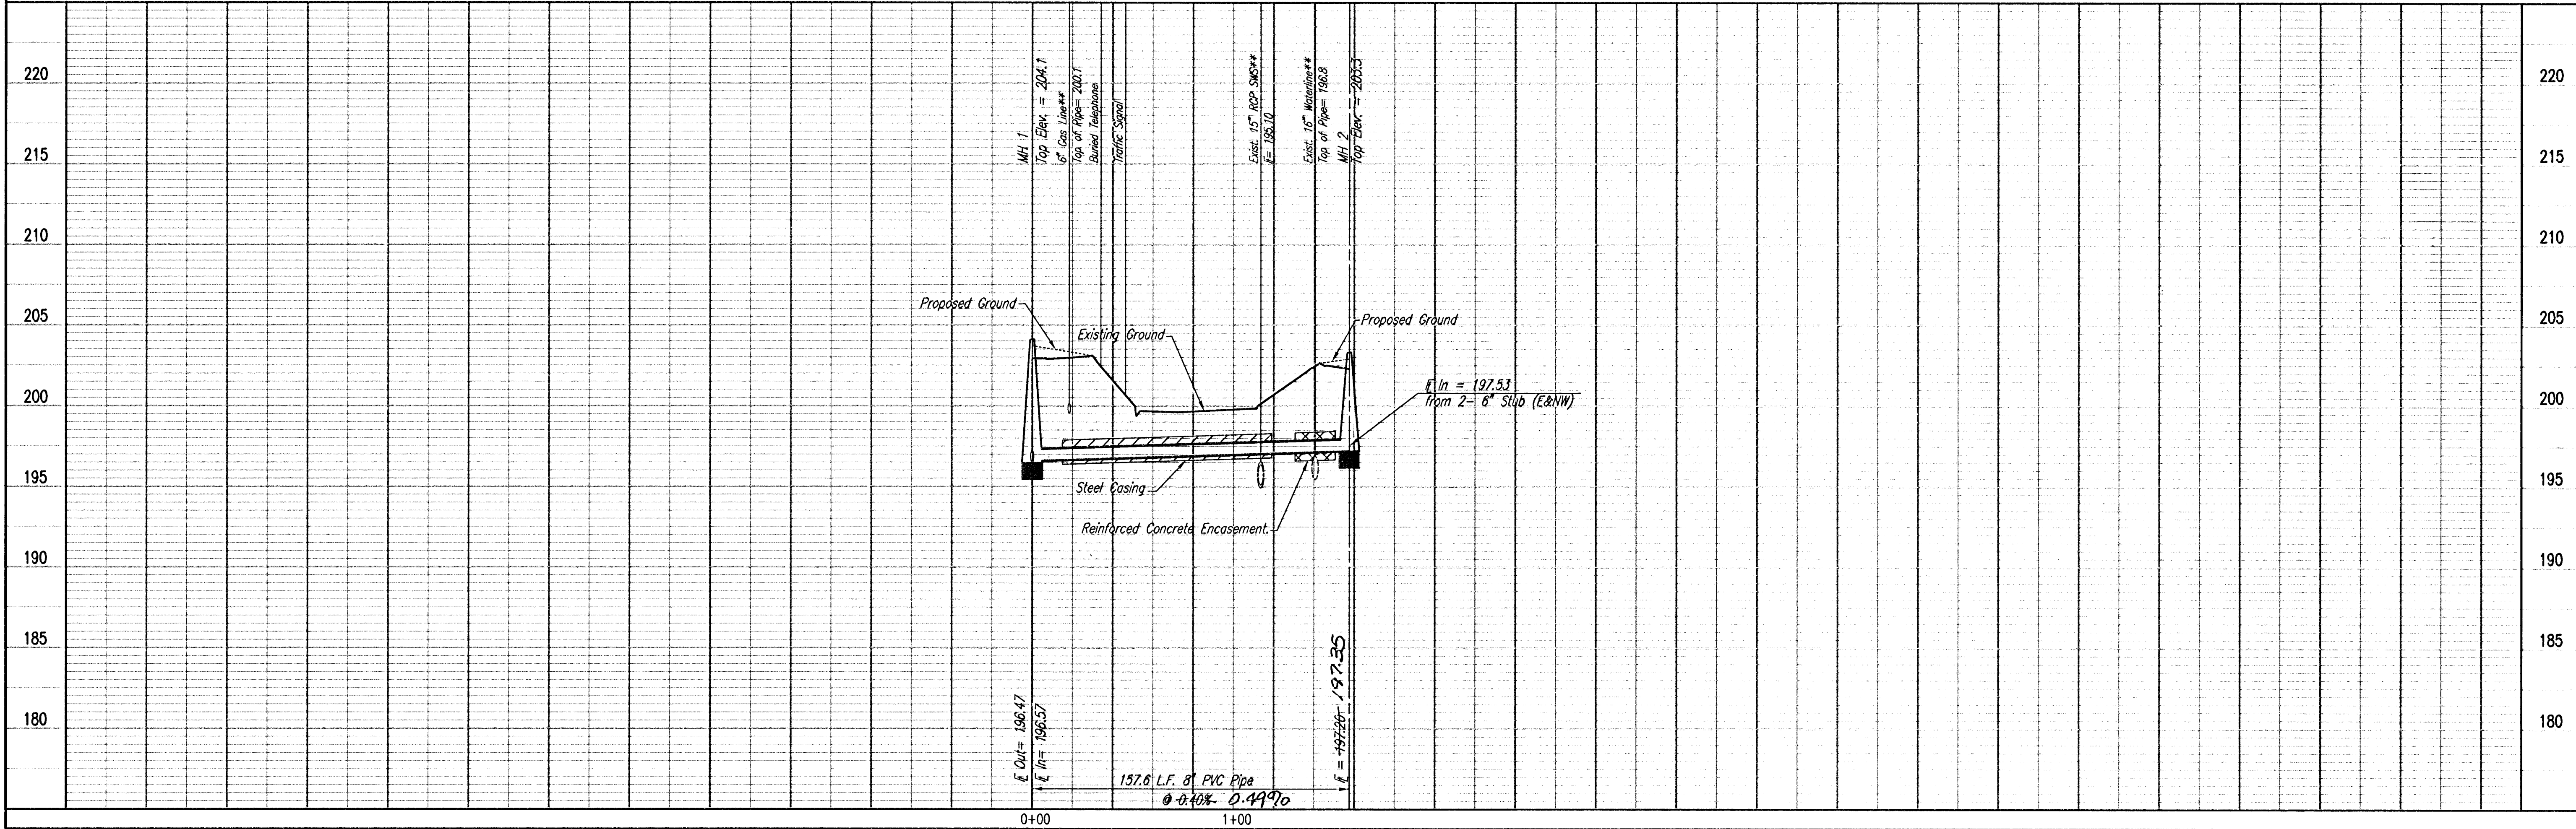

** PRIOR TO BEGINNING CONSTRUCTION, THE CONTRACTOR SHALL EXCAVATE THE EXISTING 6" GAS LINE AT SANITARY SEWER STATION 0+18.4, THE EXISTING 15" RCP STORM SEWER AT SANITARY SEWER STATION 1+13.6, AND THE EXISTING 16" WATERLINE AT SANITARY SEWER STATION 1+41.5 TO VERIFY HORIZONTAL AND VERTICAL LOCATIONS. THE PIPE LOCATIONS SHALL BE REPORTED TO THE ENGINEER SO THAT ANY NECESSARY PLAN MODIFICATIONS CAN BE MADE. ANY ADDITIONAL LABOR OR MATERIALS NECESSARY TO COMPLETE THE WORK SHALL BE CONSIDERED SUBSIDIARY TO THE PROJECT.

Professional Engineering Consultants, P.A. 303 S. TOPICKA • WICHITA, KANSAS 67202 316-262-2691 • FAX 316-262-3003	
Designed By: MDK	Job No.: 35-05582-042
Drawn By: TJS	Date: OCTOBER 2005