


BRENTWOOD SOUTH

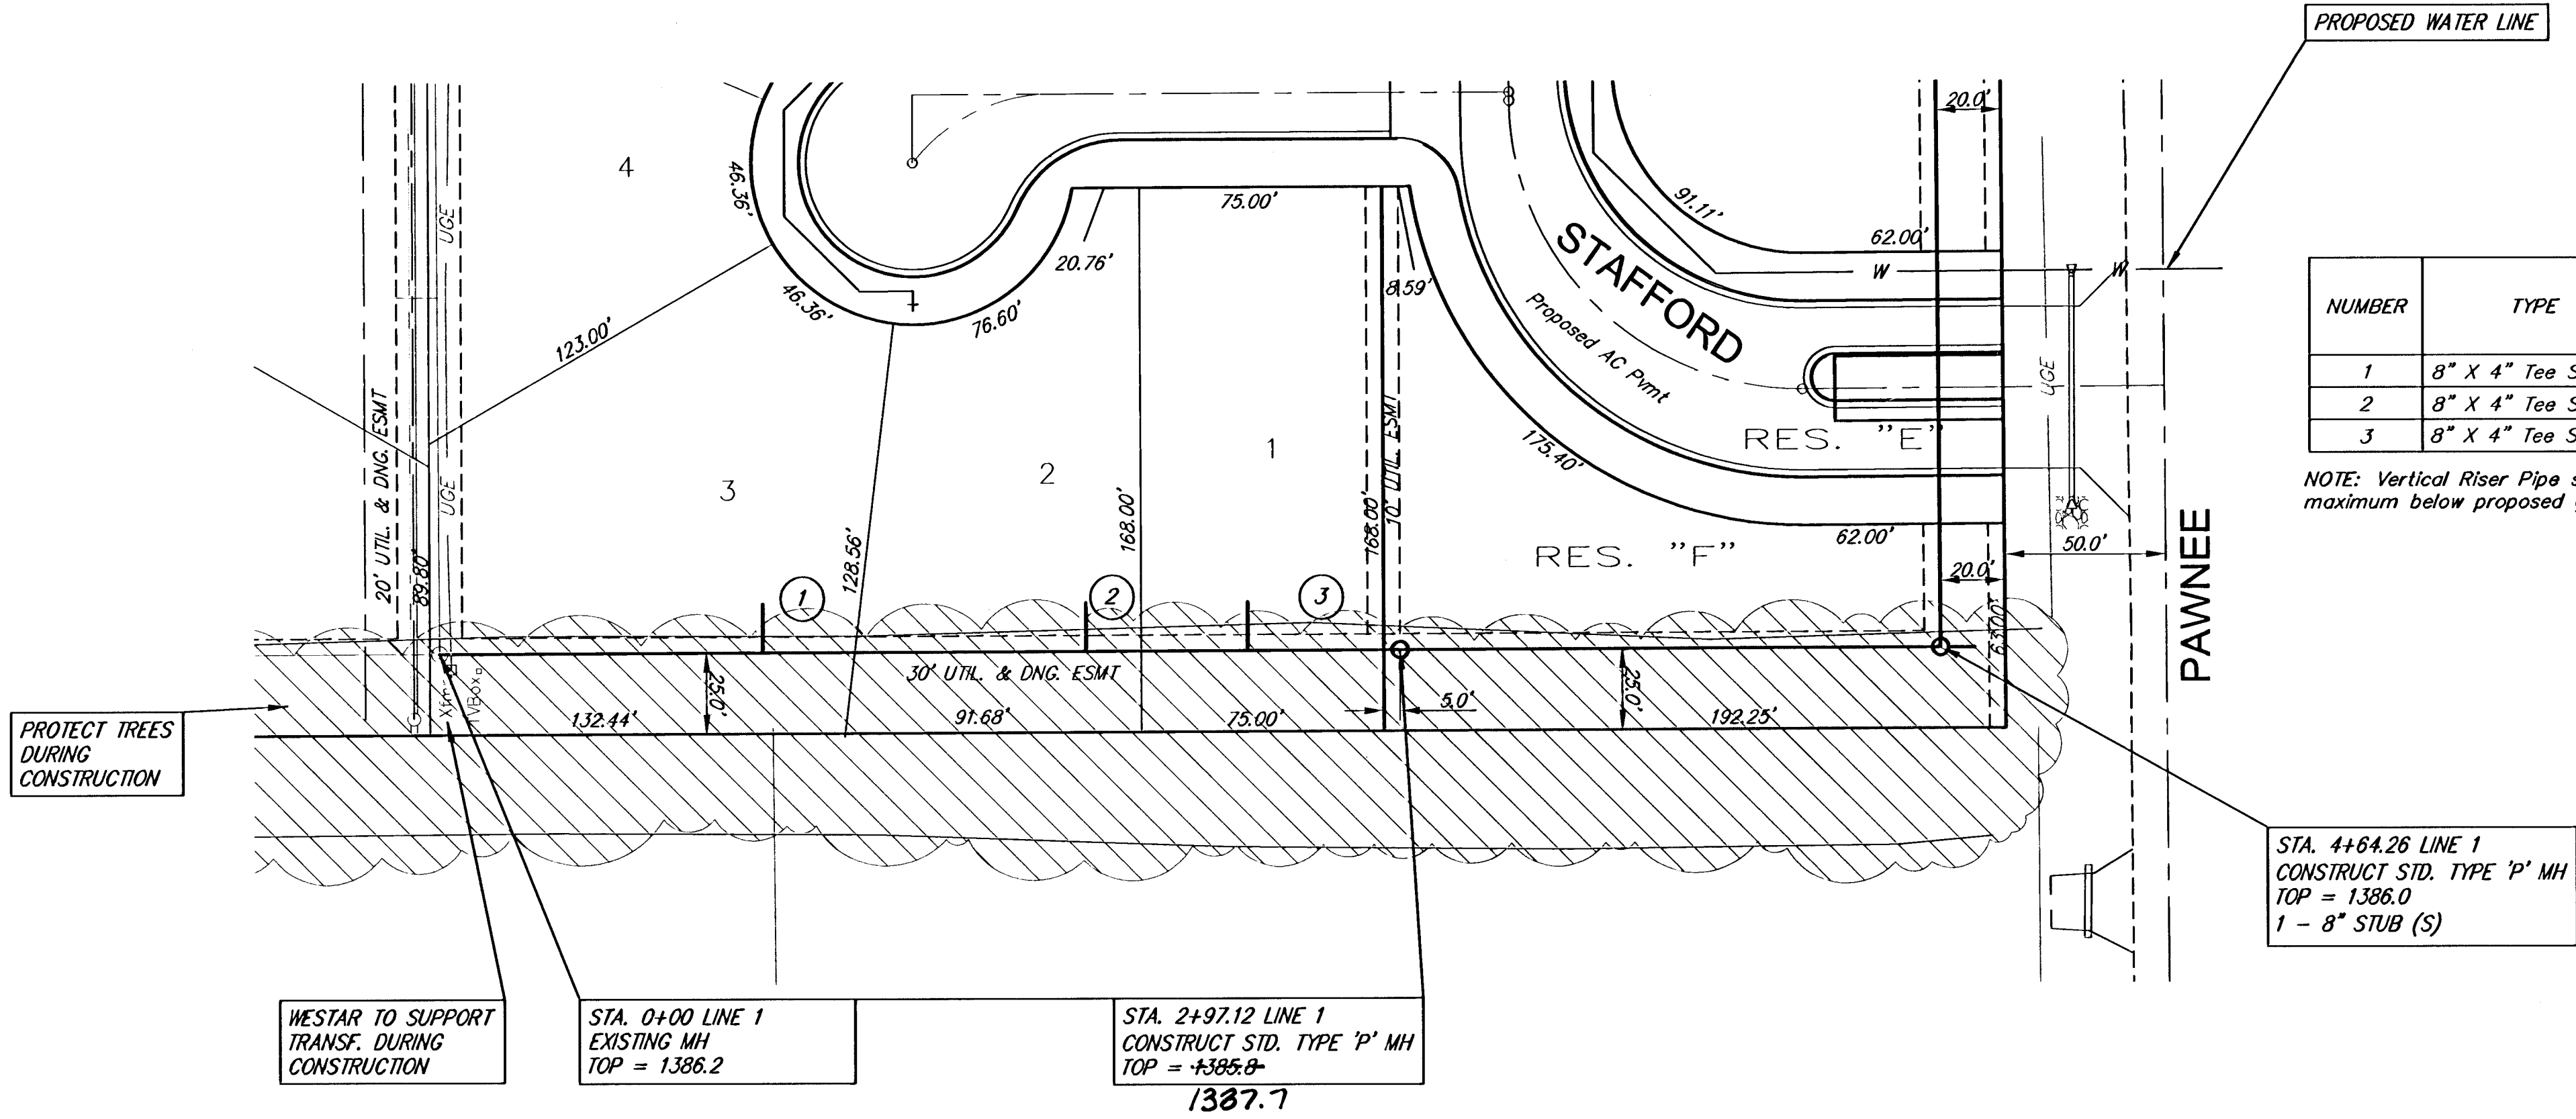

SEWER SERVICE TABLE

NUMBER	TYPE	LOCATION			STATION/ DIRECTION	FOR INFORMATION ONLY	
		LOT NO.	BLOCK NO.	LINE NO.		APPROXIMATE LENGTH 4" PIPE	
						VERTICAL	HORIZONTAL
1	8" X 4" Tee Saddle	3	7	1	1+00/E	12.1'	14.5'
2	8" X 4" Tee Saddle	2	7	1	2+00/E	12.3'	15'
3	8" X 4" Tee Saddle	1	7	1	2+50/E	12.5'	16'

NOTE: Vertical Riser Pipe shall be extended to 2' minimum above ground water elevation and 4' maximum below proposed ground elevation.

