


BRENTWOOD SOUTH

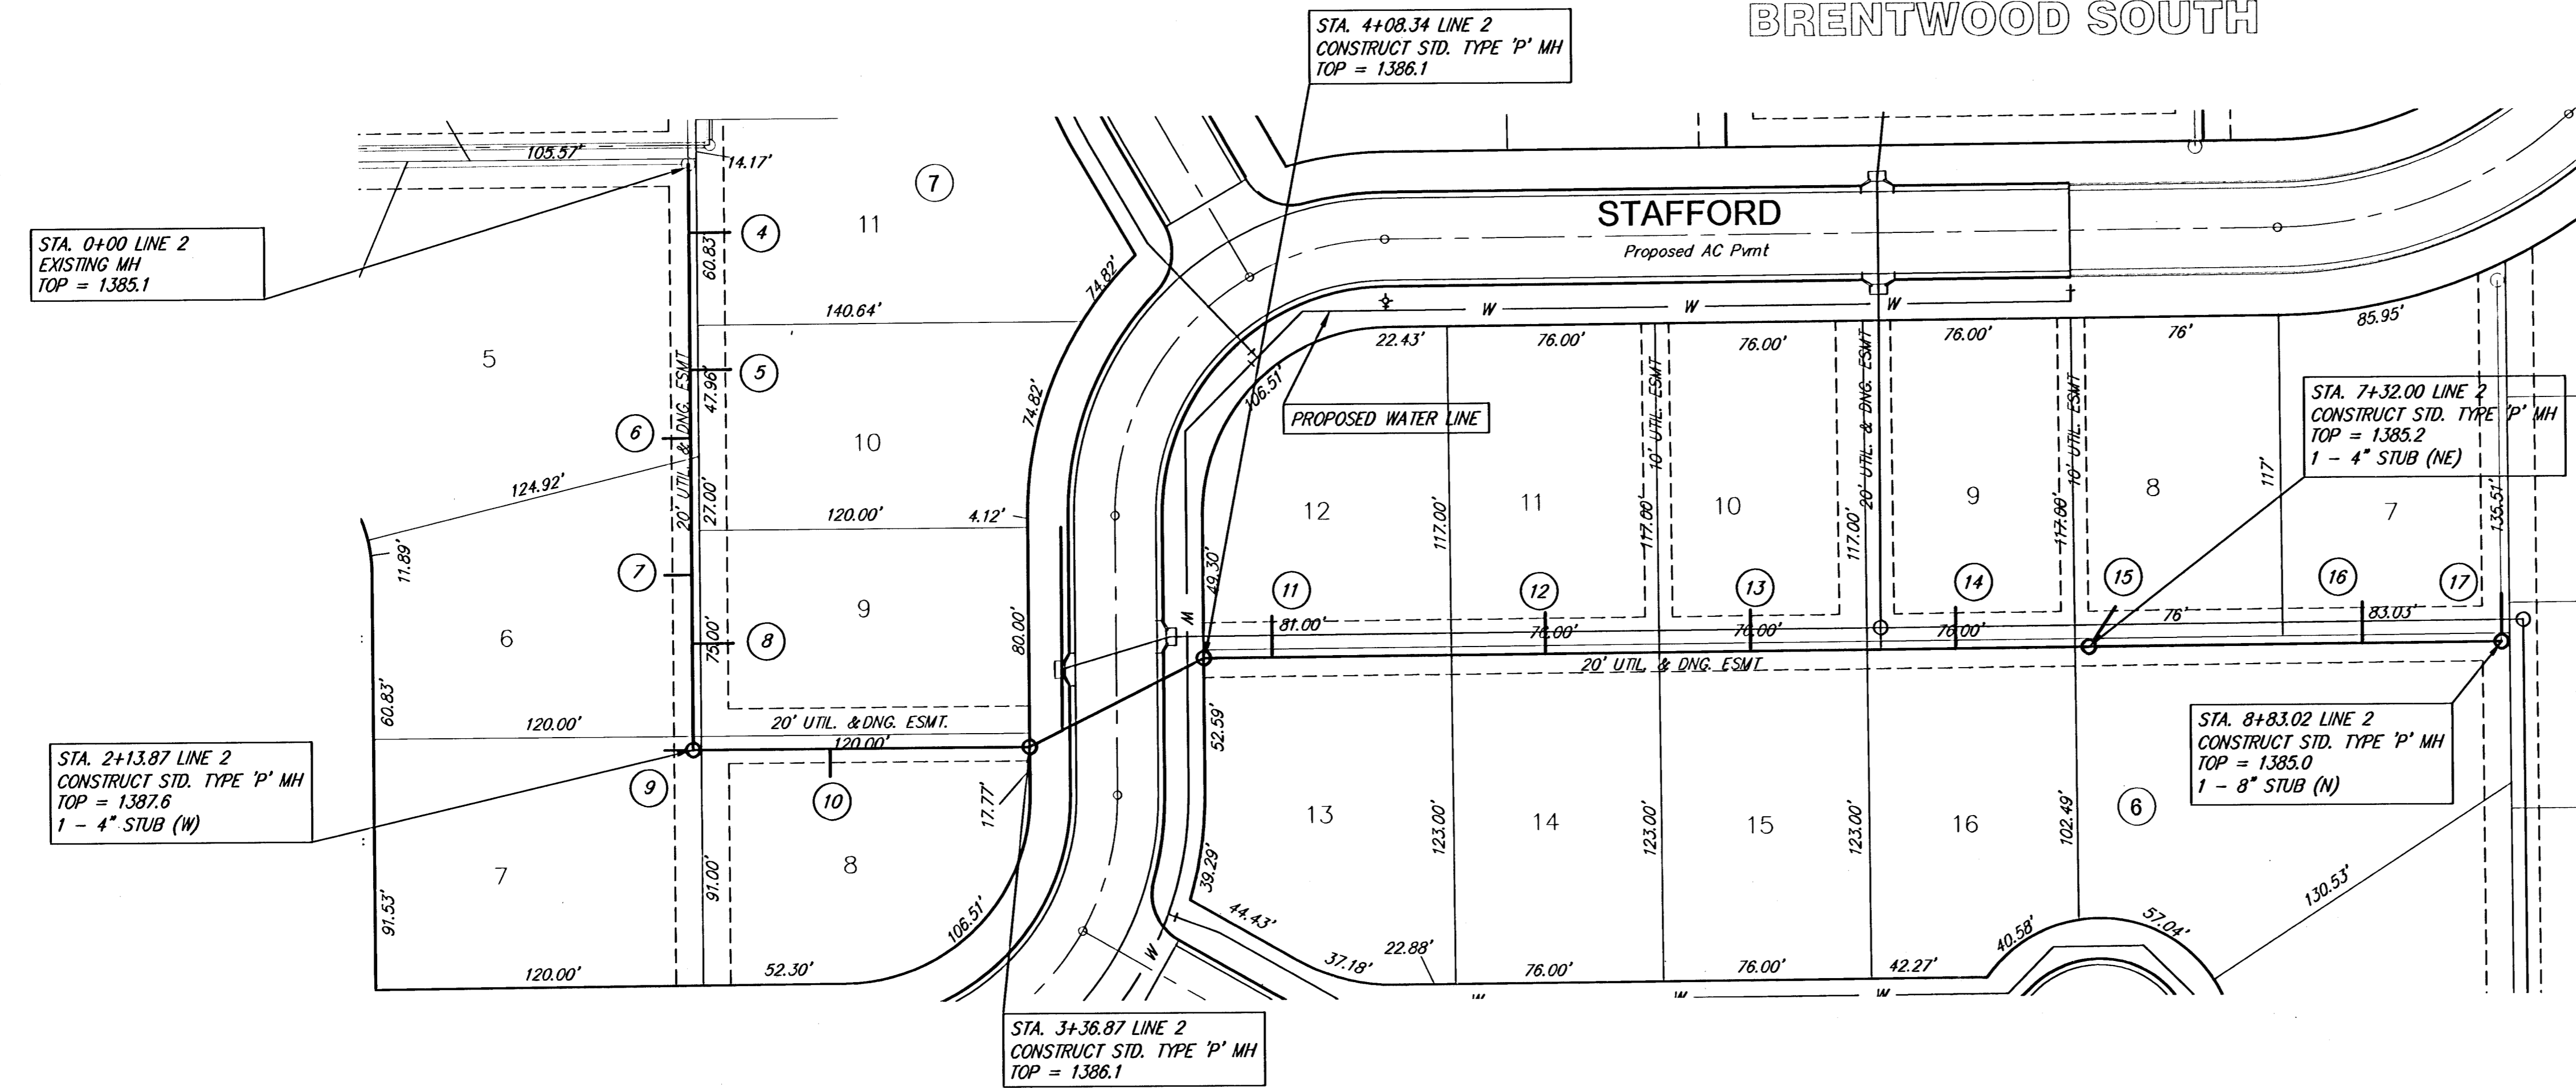


SCALE 1" = 40'
IRON = •



SEWER SERVICE TABLE

NUMBER	TYPE	LOCATION			FOR INFORMATION ONLY	
		LOT NO.	BLOCK NO.	LINE NO.	STATION/DIRECTION	APPROXIMATE LENGTH 4" PIPE
4	8" X 4" Tee Saddle	11	7	2	0+25/E	12.4' +5' 14.5'
5	8" X 4" Tee Saddle	10	7	2	0+75/E	12.8' 15'
6	8" X 4" Tee Saddle	5	7	2	1+00/W	13.0' +6' 10.5'
7	8" X 4" Tee Saddle	6	7	2	1+50/W	13.4' +6' 11'
8	8" X 4" Tee Saddle	9	7	2	1+75/E	13.6' 15'
9	4" Stub w/Riser	7	7	2	2+13.87/E	14.0' +6' 14'
10	8" X 4" Tee Saddle	8	7	2	2+83.87/S	13.2' +6' 10.5'
11	8" X 4" Tee Saddle	12	6	2	4+33.34/N	11.9' +5' 10'
12	8" X 4" Tee Saddle	11	6	2	5+33.34/N	11.0' 15'
13	8" X 4" Tee Saddle	10	6	2	6+08.34/N	9.9' +5' 14.5'
14	8" X 4" Tee Saddle	9	6	2	6+83.34/N	9.6' +6' 14.5'
15	4" Stub w/Riser	8	6	2	7+32/NE	+5' 10' 8" +1' N
16	8" X 4" Tee Saddle	7	6	2	8+32/NE	9.9' +5' 13.5'

NOTE: Vertical Riser Pipe shall be extended to 2' minimum above ground water elevation and 4' maximum below proposed ground elevation.

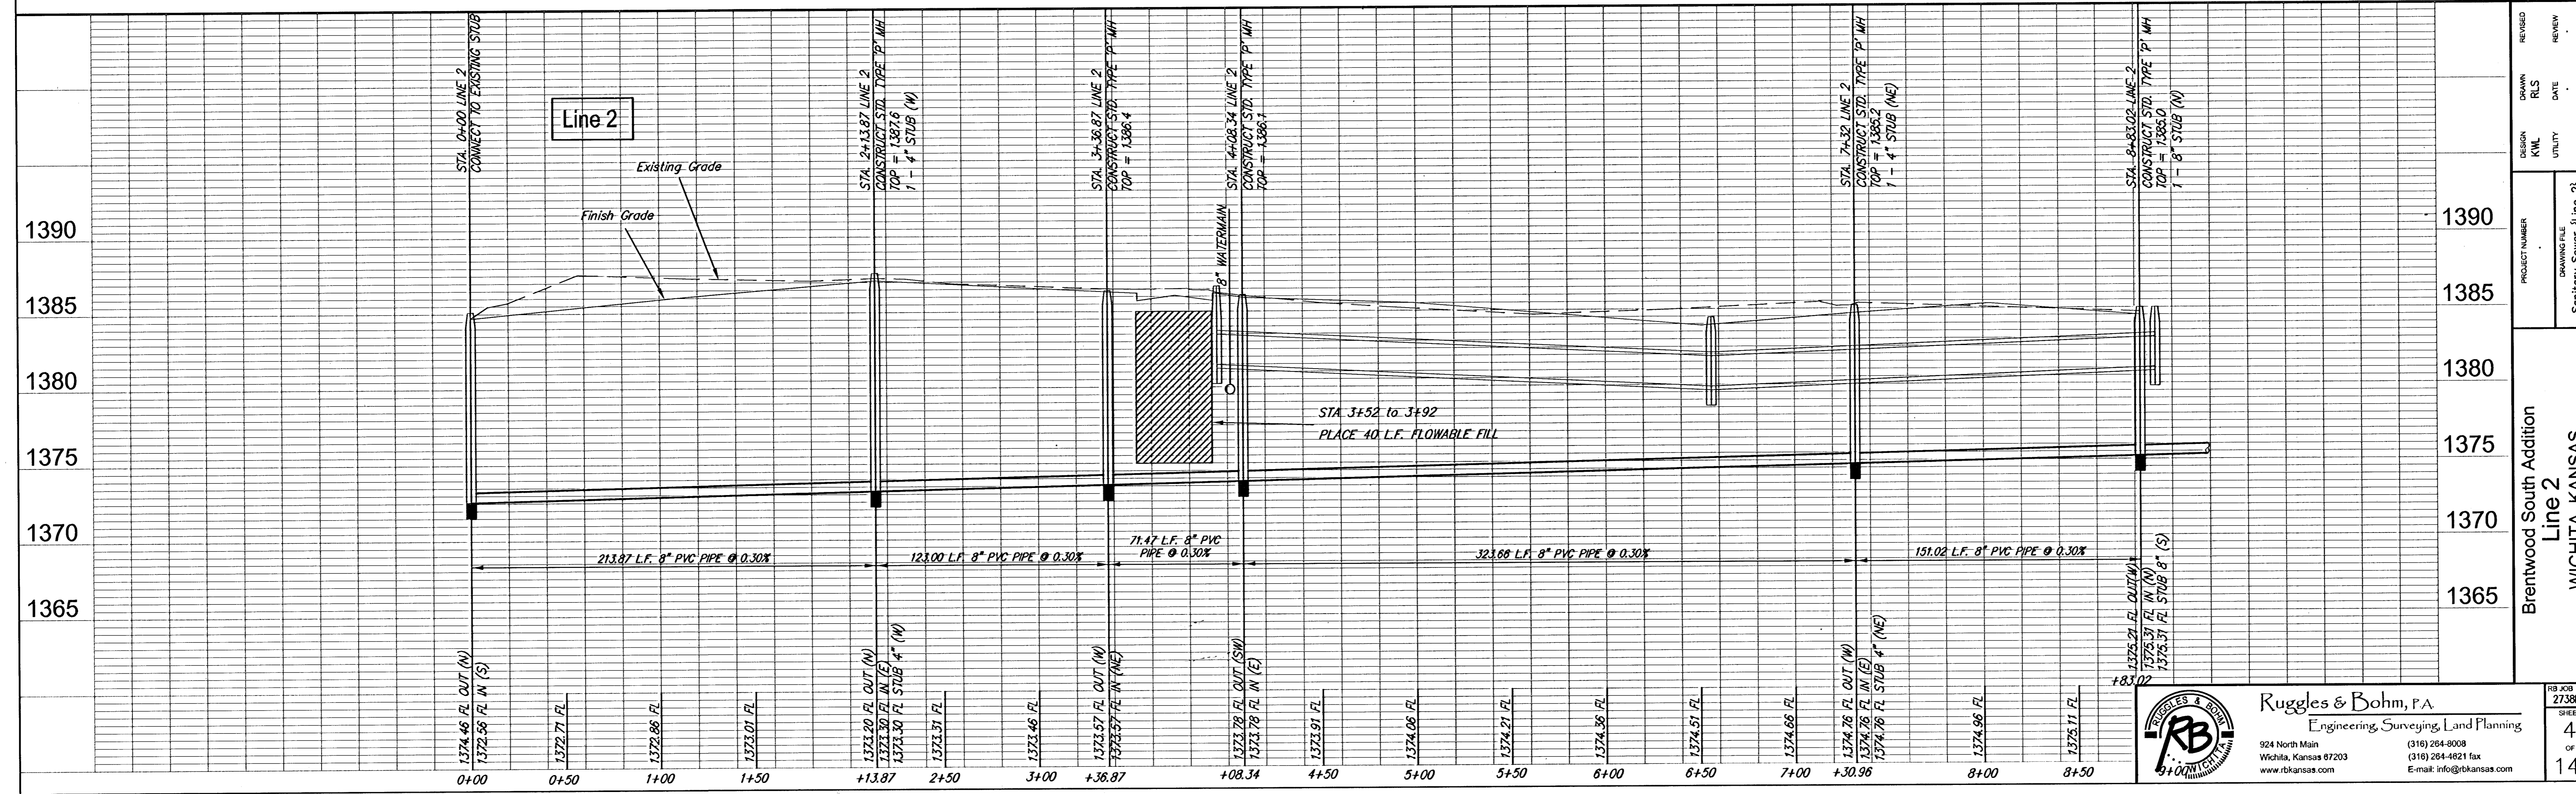

PROJECT NUMBER: Sanitary Sewer (Line 2)
DRAWING FILE: WICHITA, KANSAS