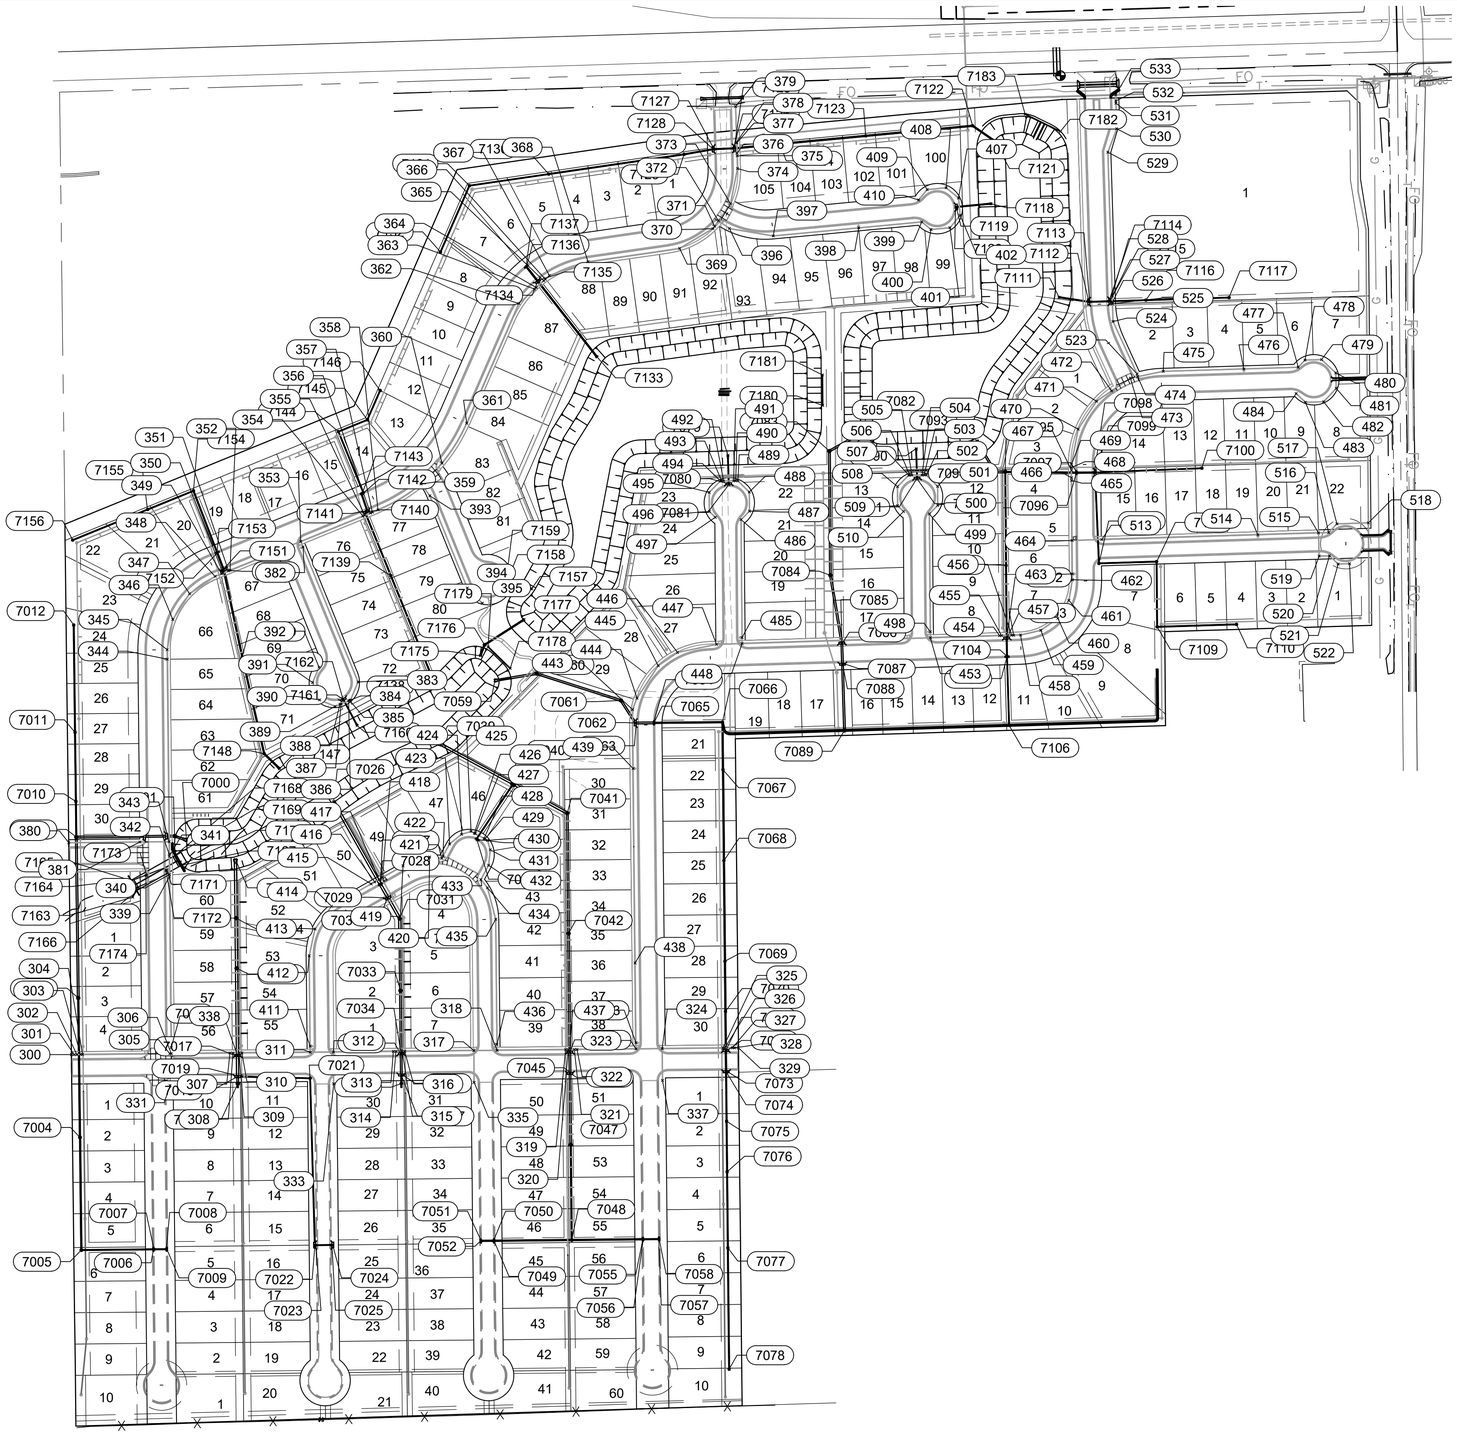

Storm Water Point Table					
Point #	Northing	Easting	Grid Northing	Grid Easting	Description
7000	1696607.73	1594316.51	1696509.23	1594223.95	END SEC LINE 1
7001	1696615.65	1594293.13	1696517.14	1594200.56	MH LINE 1
7002	1696613.65	1594098.53	1696515.15	1594005.97	BACKYARD INLET LINE 1
7003	1696295.09	1594102.43	1696196.60	1594009.88	BACKYARD INLET LINE 1
7004	1696019.20	1594105.82	1695920.73	1594013.26	BACKYARD INLET LINE 1
7005	1695796.09	1594108.56	1695697.63	1594016.00	BACKYARD INLET LINE 1
7006	1695797.55	1594251.25	1695699.09	1594158.69	DRIVEWAY INLET CENTER
7007	1695797.56	1594252.25	1695699.10	1594159.69	DRIVEWAY INLET INSIDE FACE
7008	1695797.81	1594276.75	1695699.35	1594184.18	DRIVEWAY INLET INSIDE FACE
7009	1695797.82	1594277.75	1695699.36	1594185.18	DRIVEWAY INLET CENTER
7010	1696684.30	1594097.66	1696585.79	1594005.10	BACKYARD INLET LINE 1A
7011	1696821.03	1594095.98	1696722.51	1594003.43	BACKYARD INLET LINE 1A
7012	1697033.44	1594093.37	1696934.91	1594000.82	BACKYARD INLET LINE 1A
7013	1696569.72	1594413.60	1696471.21	1594321.03	END SECTION LINE 2
7014	1696453.25	1594414.80	1696354.76	1594322.22	BACKYARD INLET LINE 2
7015	1696354.06	1594415.81	1696255.57	1594323.24	BACKYARD INLET LINE 2
7016	1696180.93	1594417.58	1696082.45	1594325.01	TYPE 1A CENTER LINE 2
7017	1696179.44	1594417.60	1696080.96	1594325.03	TYPE 1A INSIDE FF LINE 2
7018	1696139.60	1594418.01	1696041.13	1594325.44	TYPE 1A CENTER LINE 2
7019	1696141.10	1594417.99	1696042.62	1594325.42	TYPE 1A INSIDE FF LINE 2
7020	1696125.50	1594418.15	1696027.02	1594325.58	BACKYARD INLET LINE 2
7021	1696136.21	1594561.41	1696037.74	1594468.83	MH LINE 2A
7022	1695805.82	1594570.77	1695707.36	1594478.19	TYPE 1A CENTER LINE 2A
7023	1695805.83	1594572.26	1695707.37	1594479.68	TYPE 1A INSIDE FF LINE 2A
7024	1695806.18	1594606.10	1695707.72	1594513.51	TYPE 1A CENTER LINE 2A
7025	1695806.16	1594604.60	1695707.70	1594512.02	TYPE 1A INSIDE FF LINE 2A
7026	1696683.70	1594607.88	1696585.19	1594515.29	END SECTION LINE 3
7027	1696520.09	1594700.47	1696421.59	1594607.88	DRIVEWAY INLET CENTER LINE 3
7028	1696519.22	1594700.96	1696420.72	1594608.37	DRIVEWAY INLET INSIDE FF LINE 3
7029	1696493.18	1594715.70	1696394.68	1594623.11	TYPE 1A CENTER LINE 3
7030	1696494.48	1594714.96	1696395.99	1594622.37	TYPE 1A INSIDE FF LINE 3
7031	1696452.32	1594738.82	1696353.82	1594646.23	BACKYARD INLET LINE 3
7032	1696409.77	1594739.26	1696311.28	1594646.67	BACKYARD INLET LINE 3
7033	1696309.75	1594740.28	1696211.26	1594647.69	BACKYARD INLET LINE 3
7034	1696184.25	1594741.57	1696085.77	1594648.98	TYPE 1A CENTER LINE 3
7035	1696182.76	1594741.58	1696084.27	1594648.99	TYPE 1A INSIDE FF LINE 3
7036	1696144.42	1594741.98	1696045.94	1594649.38	TYPE 1A INSIDE FF LINE 3
7037	1696142.92	1594741.99	1696044.44	1594649.40	TYPE 1A CENTER LINE 3
7038	1696125.88	1594742.16	1696027.41	1594649.57	BACKYARD INLET LINE 3
7039	1696798.98	1594817.16	1696700.47	1594724.57	END SECTION LINE 4
7040	1696719.25	1594963.68	1696620.74	1594871.08	MH LINE 4
7041	1696661.01	1595070.70	1696562.50	1594978.09	BACKYARD INLET LINE 4
7042	1696422.92	1595073.14	1696324.42	1594980.53	BACKYARD INLET LINE 4
7043	1696187.67	1595075.55	1696089.19	1594982.94	TYPE 1A INLET CENTER LINE 4
7044	1696186.17	1595075.57	1696087.69	1594982.96	TYPE 1A INLET INSIDE FF LINE 4
7045	1696147.83	1595075.96	1696049.36	1594983.35	TYPE 1A INLET INSIDE FF LINE 4
7046	1696146.34	1595075.97	1696047.86	1594983.36	TYPE 1A INLET CENTER LINE 4
7047	1696004.65	1595077.42	1695906.18	1594984.81	BACKKYARD INLET LINE 4
7048	1695816.02	1595079.35	1695717.56	1594986.74	BACKKYARD INLET LINE 4
7049	1695814.45	1594925.61	1695715.99	1594833.01	DRIVEWAY INLET CENTER LINE 4

GARVER
© 2023 GARVER, LLC
THIS DOCUMENT, ALONG WITH THE IDEAS AND DESIGNS CONVEYED HEREIN, SHALL BE CONSIDERED INSTRUMENTS OF PROFESSIONAL SERVICE AND ARE PROPERTY OF GARVER, LLC. ANY USE, REPRODUCTION, OR DISTRIBUTION OF THIS DOCUMENT, ALONG WITH THE IDEAS AND DESIGN CONTAINED HEREIN, IS PROHIBITED UNLESS AUTHORIZED IN WRITING BY GARVER, LLC OR EXPLICITLY ALLOWED IN THE GOVERNING PROFESSIONAL SERVICES AGREEMENT FOR THIS WORK.

1995 Midfield Road
Wichita, KS 67209
(316) 264-8008

REV.	DATE	DESCRIPTION	BY

CITY OF WICHITA
WICHITA, KANSAS

AREA 151
STORM WATER DRAIN - PHASE 1

COORDINATE MAP SWS

JOB NO.: 22T41002
DATE: DEC 2023
DESIGNED BY: EJG
DRAWN BY: DRS

BAR IS ONE INCH ON ORIGINAL DRAWING
0 1"
IF NOT ONE INCH ON THIS SHEET, ADJUST SCALES ACCORDINGLY.

DRAWING NUMBER

SHEET NUMBER 81 OF 93

File: L:\2022\22T41002 - Area 151 Addition\Drawings\C3D\22T41002 COORDINATES.dwg Last Save: 10/10/2023 11:21 AM Last saved by: DRSandrich
Last plotted by: Standrich, Daryl R. Plot Style: ---- Plot Scale: 1:2.5849 Plot Date: 12/1/2023 8:10 AM Plotter used: None