





© 2023 GARVER, LLC  
 THIS DOCUMENT, ALONG WITH THE  
 IDEAS AND DESIGNS CONVEYED  
 HEREIN, SHALL BE CONSIDERED  
 INSTRUMENTS OF PROFESSIONAL  
 SERVICE AND ARE PROPERTY OF  
 GARVER, LLC. ANY USE,  
 REPRODUCTION, OR DISTRIBUTION  
 OF THIS DOCUMENT, ALONG WITH  
 THE IDEAS AND DESIGN CONTAINED  
 HEREIN, IS PROHIBITED UNLESS  
 AUTHORIZED IN WRITING BY  
 GARVER, LLC OR EXPLICITLY  
 ALLOWED IN THE GOVERNING  
 PROFESSIONAL SERVICES  
 AGREEMENT FOR THIS WORK.

1995 Midfield Road  
 Wichita, KS 67209  
 (316) 264-8008

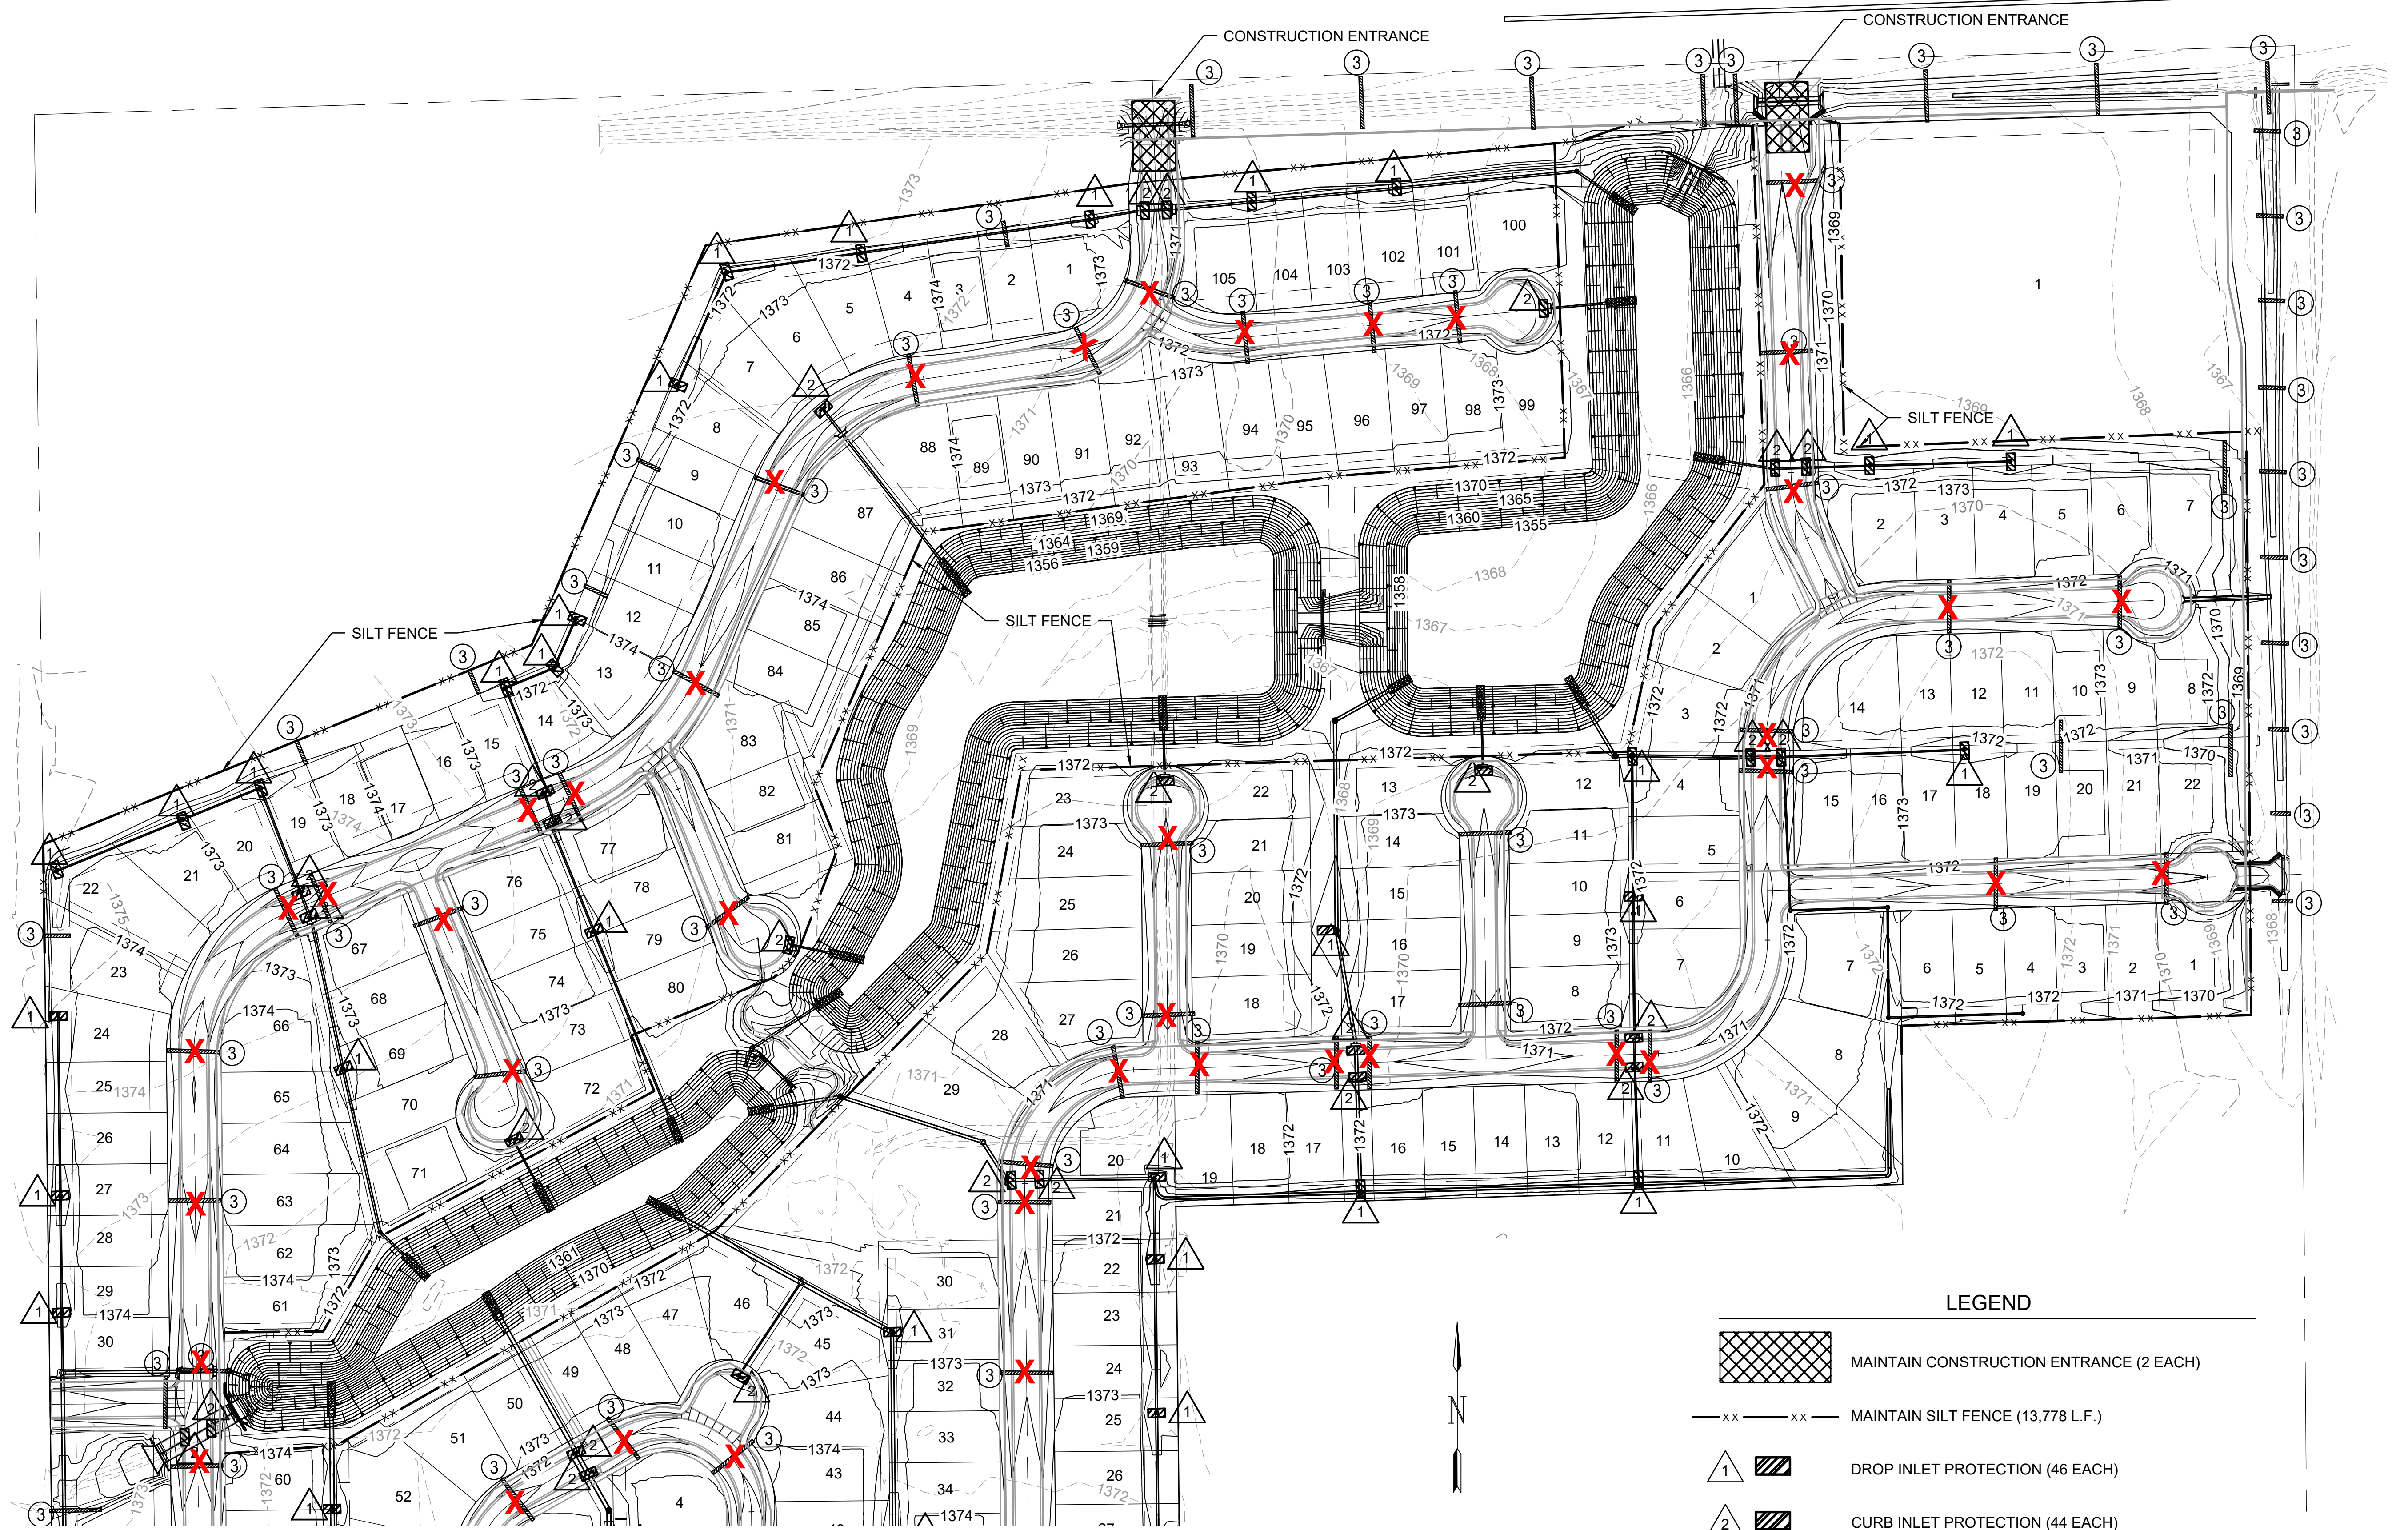

**LEGEND**

	MAINTAIN CONSTRUCTION ENTRANCE (2 EACH)
	MAINTAIN SILT FENCE (13,778 L.F.)
	DROP INLET PROTECTION (46 EACH)
	CURB INLET PROTECTION (44 EACH)
	LINEAR SEDIMENT BARRIER (127 EACH)

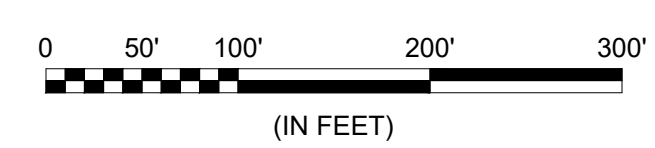

THESE ARE TOTALS FOR THIS SHEET AND THE NEXT SHEET.

File: L:\2022\22T41002 - Area 151 - Addition\Drawings\CADD\22T41002 EROSION CONTROL PLANS.dwg Last Save: 11/30/2023 2:57 PM Last saved by: DRStandrich  
 Last plotted by: Standrich, Darryl R. Plot Style: --- Plot Scale: 1:2,5849 Plot Date: 12/1/2023 8:11 AM Plotter Used: None

REV.	DATE	DESCRIPTION	BY



CITY OF WICHITA  
 WICHITA, KANSAS

AREA 151  
 STORM WATER DRAIN - PHASE 1

**EC PLAN  
 NORTH SWS**

JOB NO.: 22T41002  
 DATE: DEC 2023  
 DESIGNED BY: .  
 DRAWN BY: .

BAR IS ONE INCH ON ORIGINAL DRAWING  
 0 1" IF NOT ONE INCH ON THIS SHEET, ADJUST SCALES ACCORDINGLY.

DRAWING NUMBER