



PROFILE	BY	DATE
CHECKED		
CHECKED		

DSNR: BLB OPER: BJS SCALE: 1=20.00

①00 = COORDINATE POINT NO.
SEE SHEET NO. 3 FOR PLAT COORDINATES

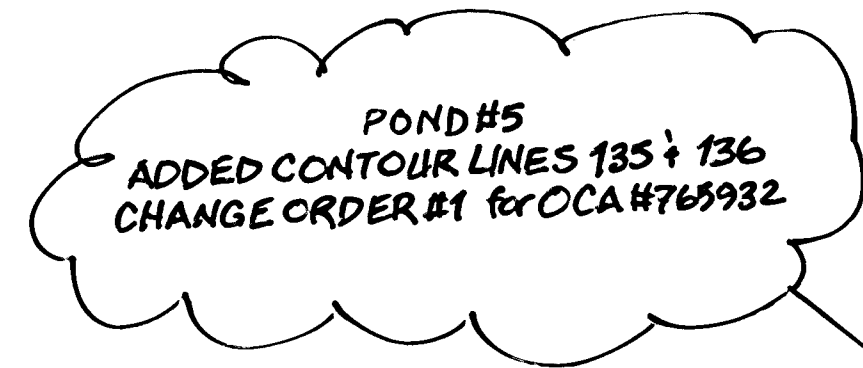

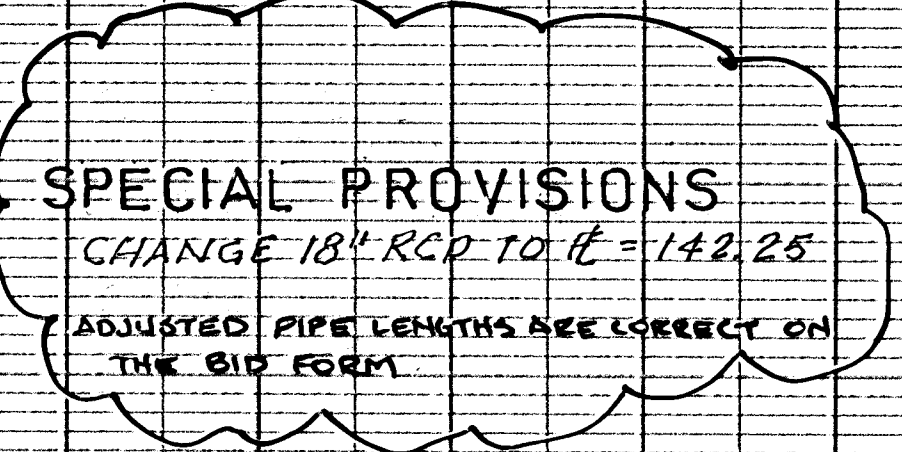

Professional Engineering Consultants, P.A.

303 S. TOPEKA • WICHITA, KANSAS 67202

316-262-2691 • FAX 316-262-3003

Designed By	B08, BUB	Job No.	35-05257
Drawn By	BUS	Date	February 2005