


Brentwood South Addition

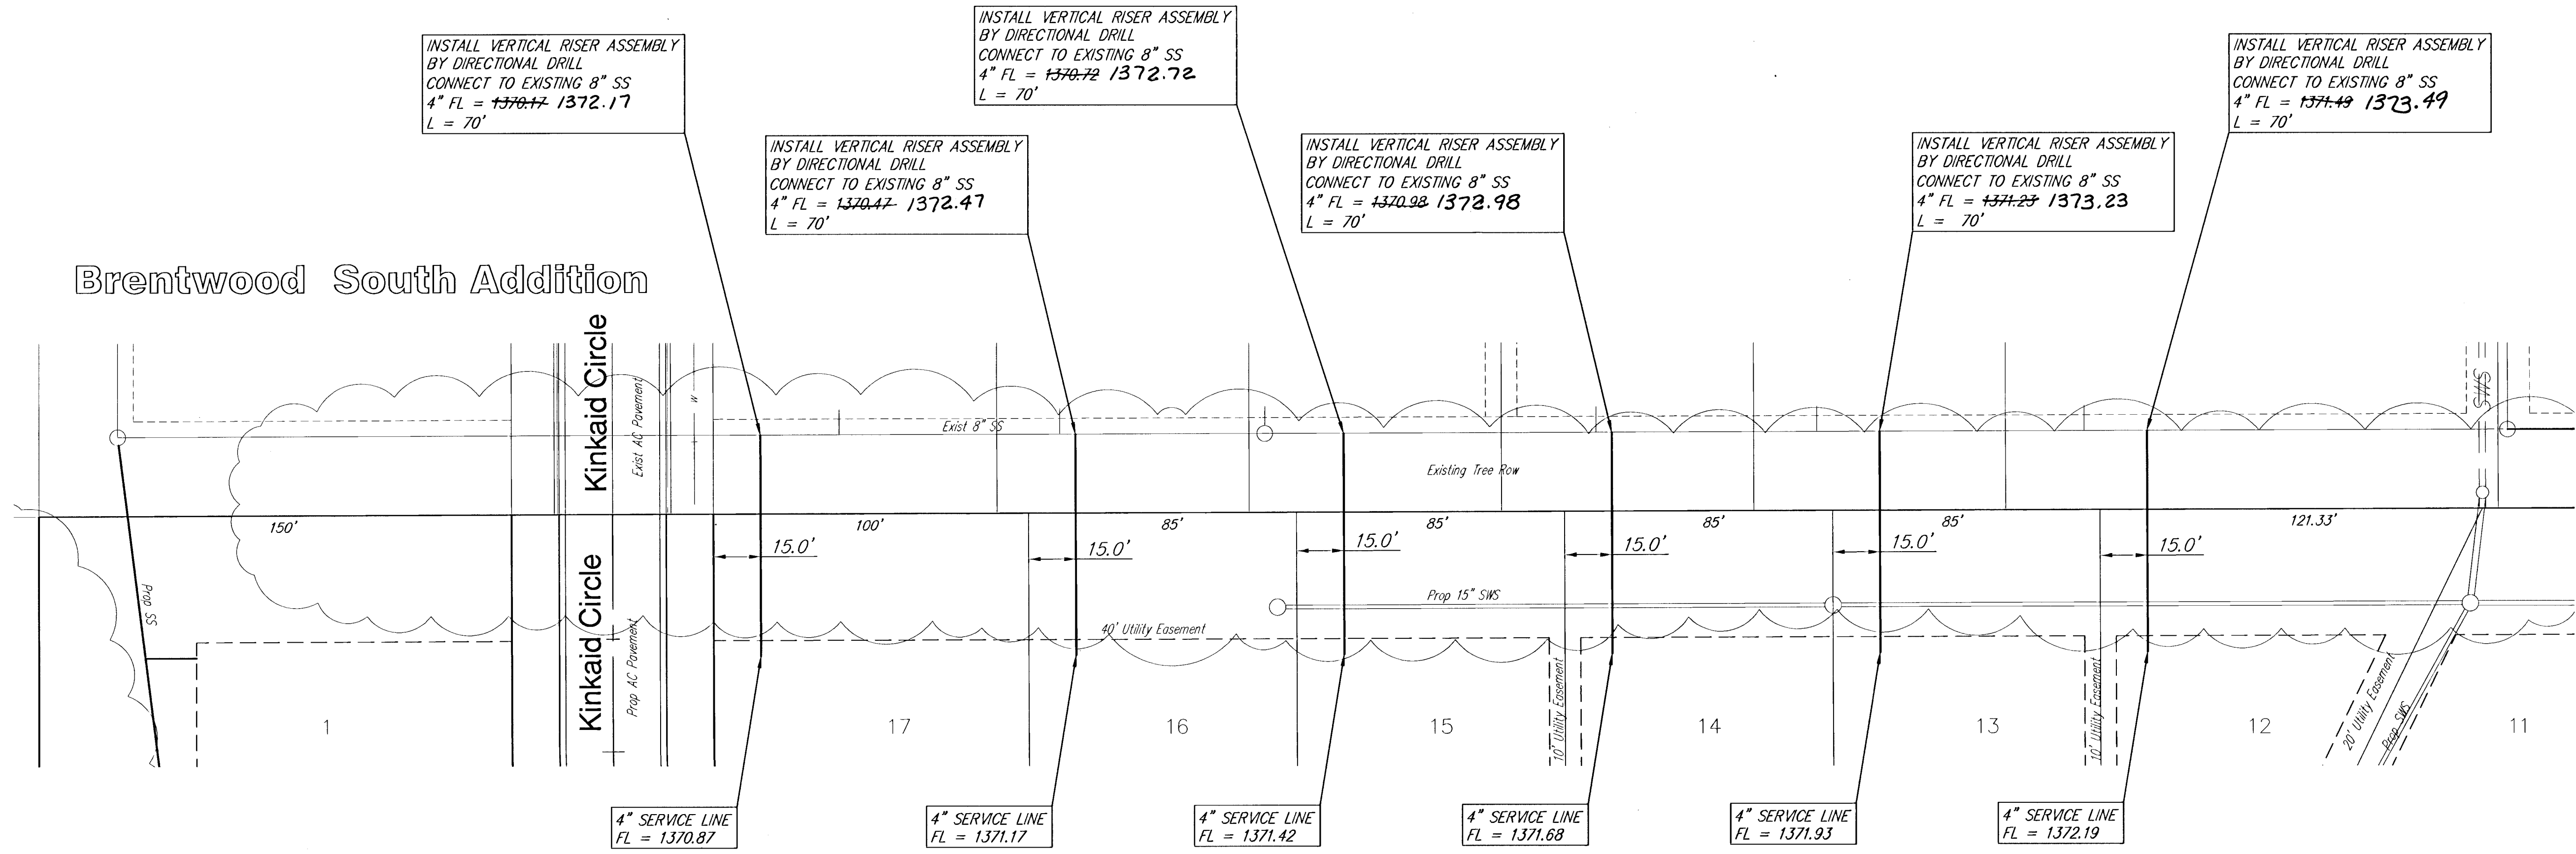

Brentwood South 2nd Addition



SCALE 1" = 30'

FOR VERTICAL RISER DETAILS SEE SHEET 9.

<b>Brentwood South 2nd Addition Sanitary Sewer WICHITA, KANSAS</b>			
	<b>Ruggles &amp; Bohm, P.A.</b> Engineering, Surveying, Land Planning		DESIGN: CMB DRAWN: EUG REVIEW:
	924 North Main Wichita, Kansas 67203 www.rbkansas.com		(316) 264-9008 (316) 264-4621 fax E-mail: info@rbkansas.com
DRAWING FILE: SS {SS03}	PROJECT NUMBER: 468-83802	DATE: July 13, 2004	SHEET: 4 OF 13