



PLOTTED: Thursday, February 15, 2024 @ 08:43PM

J:\PROJECTS\2023\2301010220\_BRIDGER\_THE HEIGHTS AT MAIZE\00 230220 CAD\SHOTS\05 CIVIL\W\FR230220-05-3200.DWG

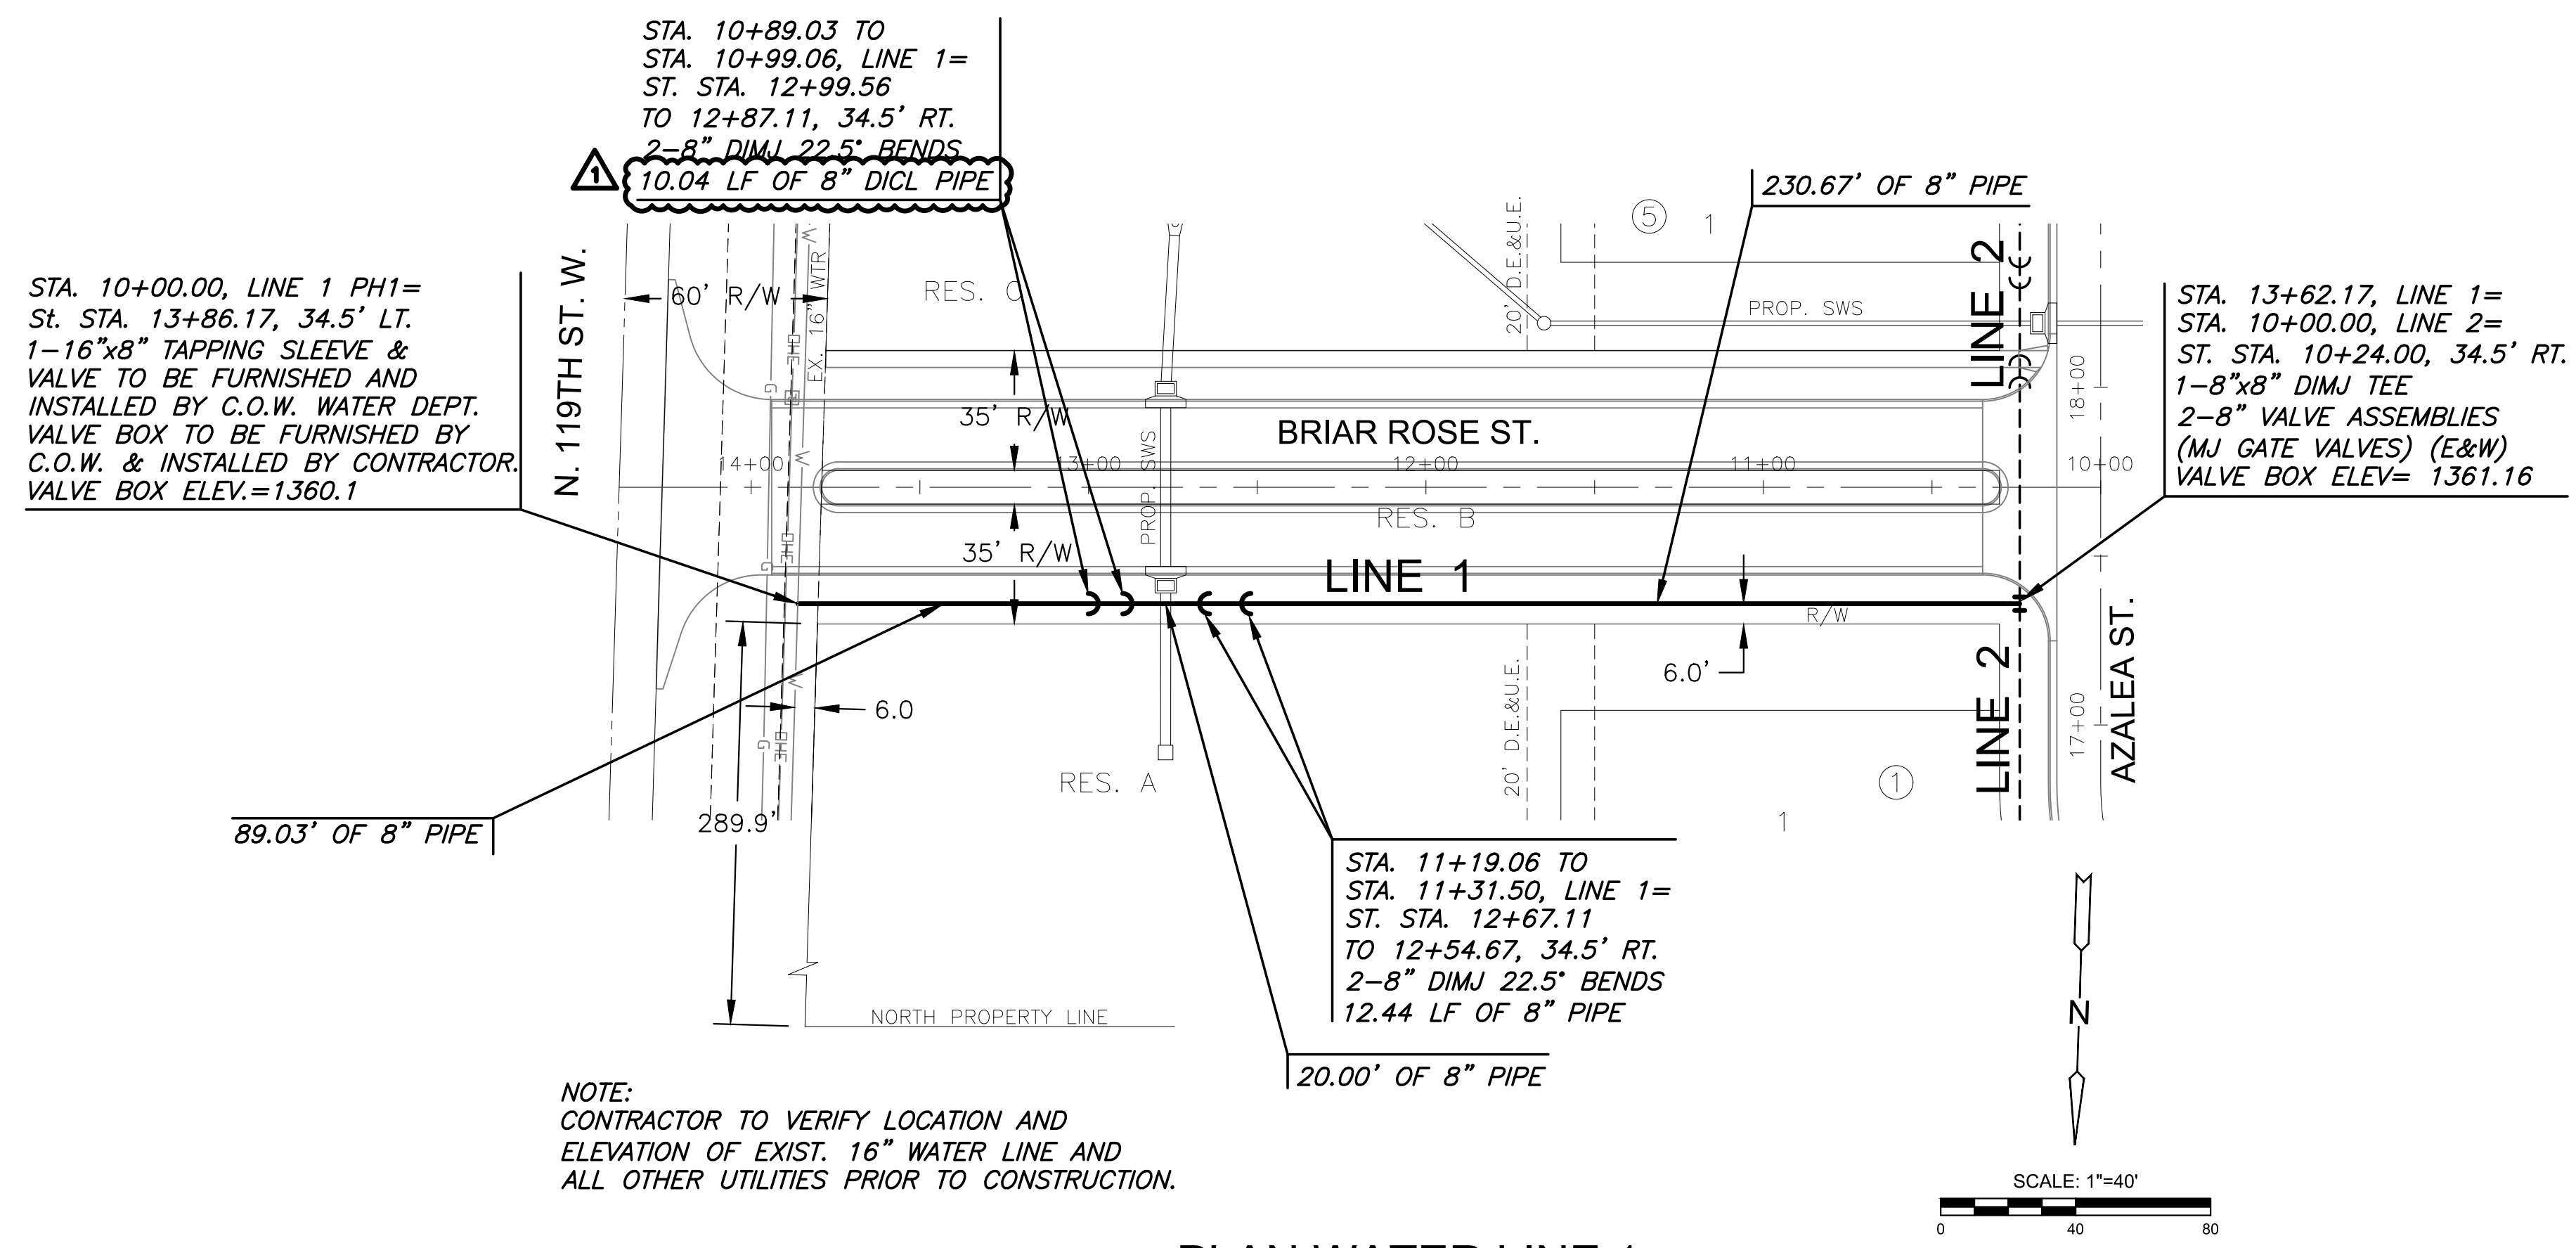

NOTE:  
CONTRACTOR TO VERIFY LOCATION AND ELEVATION OF EXIST. 16" WATER LINE AND ALL OTHER UTILITIES PRIOR TO CONSTRUCTION.

PLAN WATER LINE 1  
PROFILE WATER LINE 1

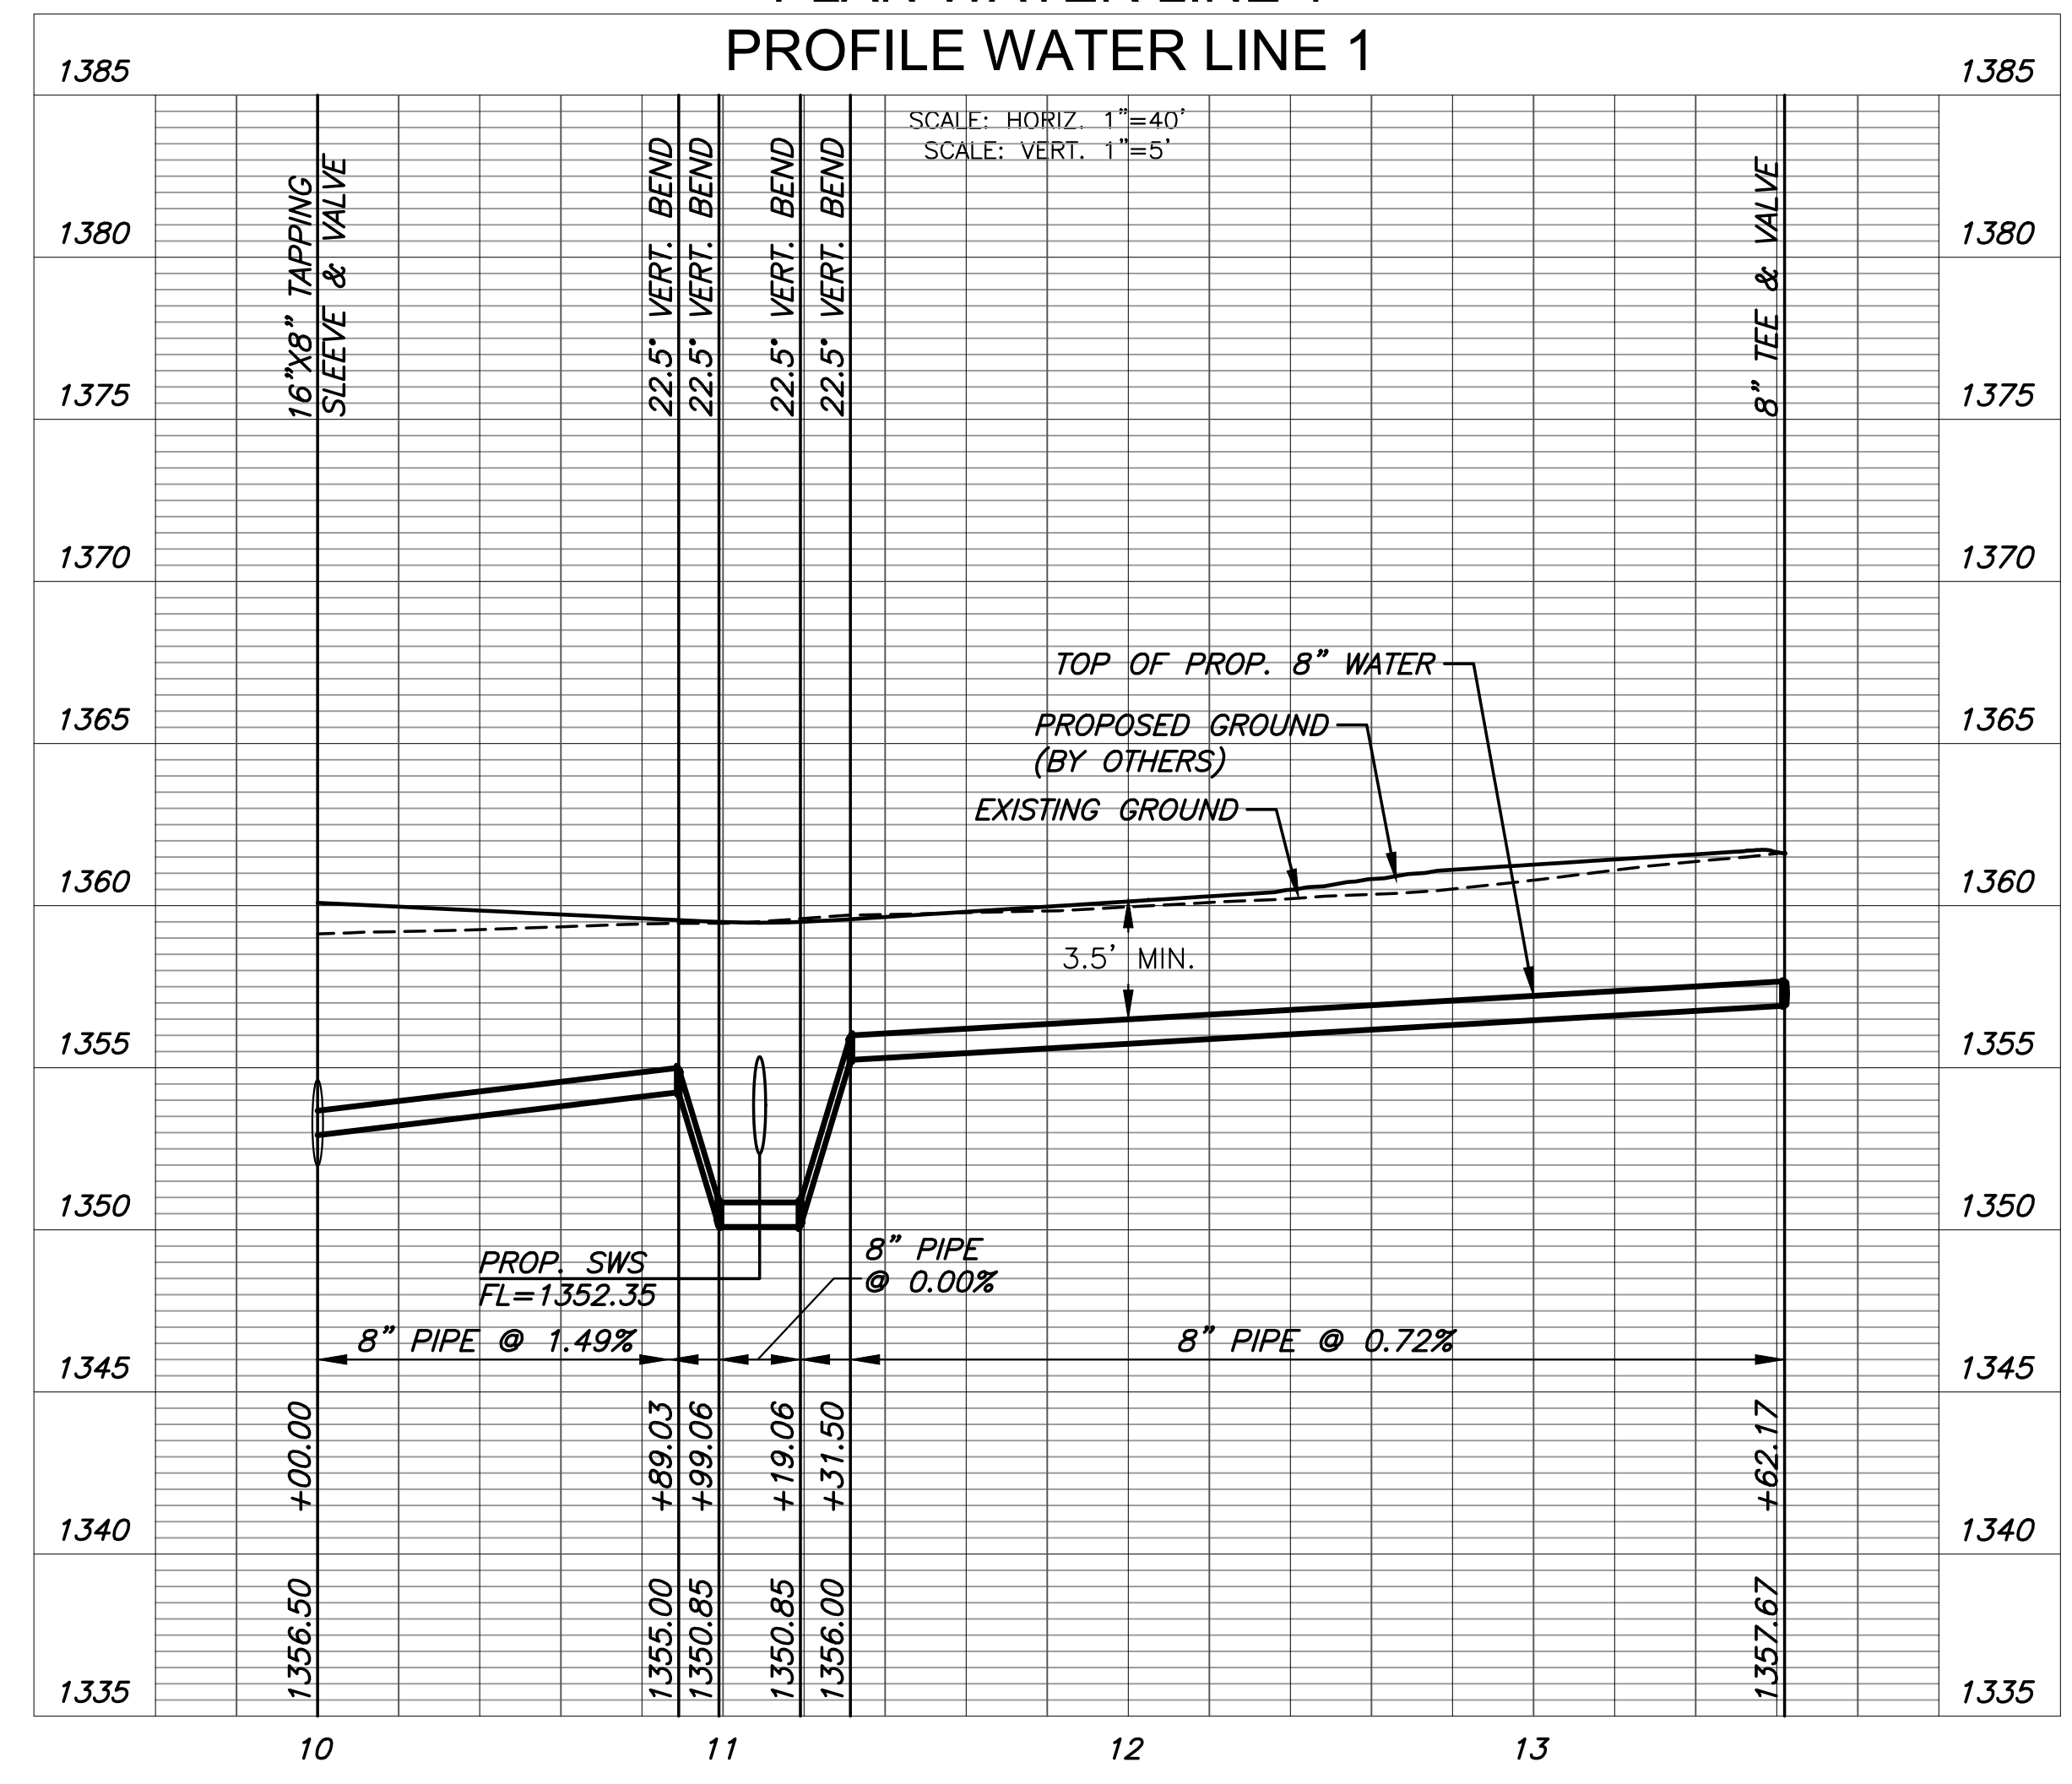

WATER DISTRIBUTION PLANS FOR

# THE HEIGHTS AT MAIZE ADDITION

MAIZE, KANSAS

©2024 MKEC Engineering All Rights Reserved  
www.mkec.com  
These drawings and their contents, including, but not limited to, all concepts, designs, & ideas are the exclusive property of MKEC Engineering (MKEC), and may not be used or reproduced in any way without the express consent of MKEC.

WATER LINE 1

PROJECT NO.	448-2023-037549
DATE	JAN. 2024
SCALE	1" = 40'
DESIGNED	DFL
DRAWN	JWC
CHECKED	SPE

NO.	REVISION	DATE
1	ADJUSTED CALLOUT	02/15/24

SHEET NO.  
04 OF 19