
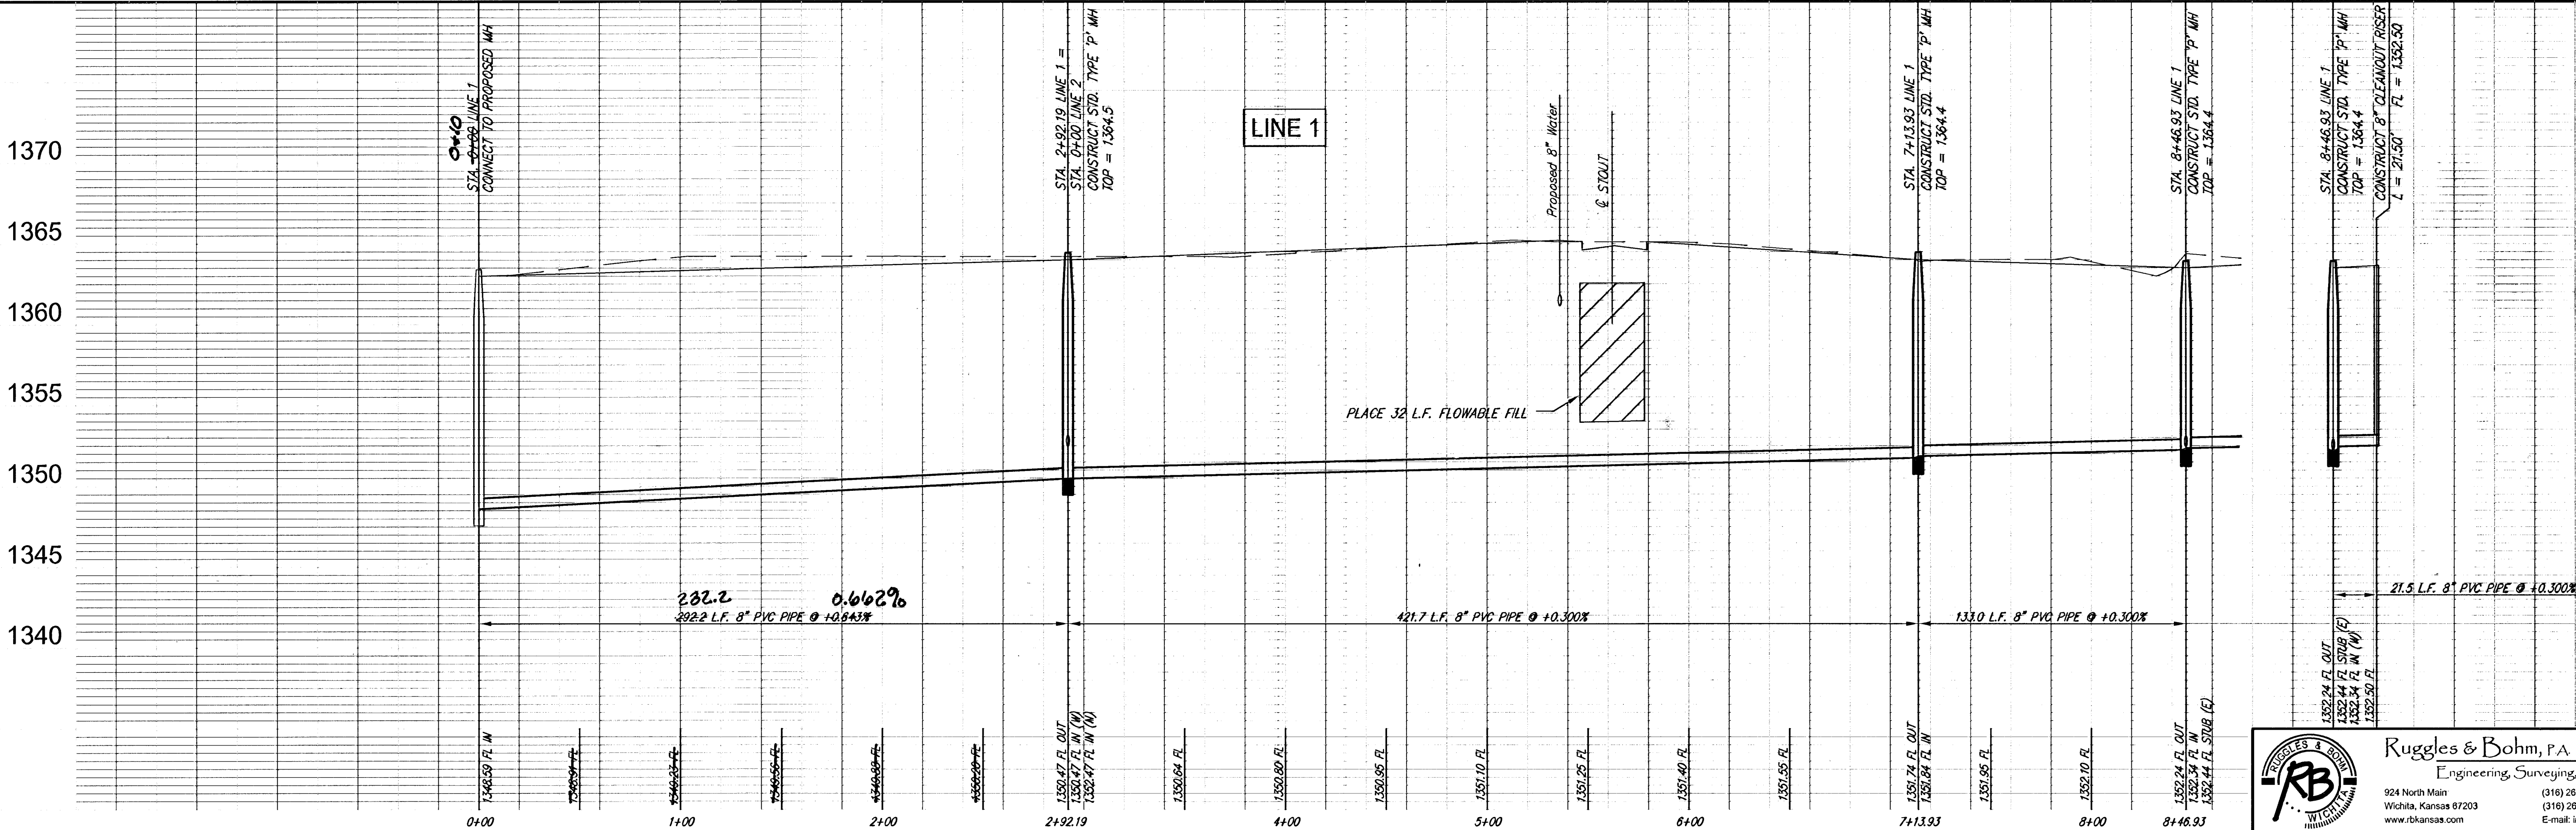


| SEWER SERVICE TABLE |              |         |           |          |                      |                                                   |
|---------------------|--------------|---------|-----------|----------|----------------------|---------------------------------------------------|
| NUMBER              | TYPE         | SERVING |           |          | FOR INFORMATION ONLY |                                                   |
|                     |              | LOT NO. | BLOCK NO. | LINE NO. | STATION\ DIRECTION   | APPROXIMATE LENGTH 4" PIPE<br>VERTICAL HORIZONTAL |
| 1                   | 8"x4" Saddle | 5       | 2         | 1        | 0+50; N 48.90 14'    | 15' 14.7                                          |
| 2                   | 8"x4" Saddle | 5       | 2         | 1        | 1+50; N 50.2 14'     | 15'                                               |
| 3                   | 8"x4" Saddle | 4       | 2         | 1        | 2+32; N 30.9 14'     | 15' 15.2                                          |
| 4                   | 8"x4" Saddle | 3       | 2         | 1        | 3+20; N 18.29 14'    | 15' 14.8                                          |
| 5                   | 8"x4" Saddle | 2       | 2         | 1        | 3+95; N 92.89 14'    | 15' 14.6                                          |
| 6                   | 8"x4" Saddle | 1       | 2         | 1        | 4+70; N 70.49 13'    | 15' 14.4                                          |
| 7                   | 8"x4" Saddle | 3       | 1         | 1        | 8+46.39; N 46.93 9'  | 15' 13.2                                          |
| 8                   | 4" MH Stub   | 4       | 1         | 1        | 8+46.39; N 46.93 9'  | 15' NA                                            |

NOTE: Vertical Riser Pipe shall be extended to 2' minimum above ground water elevation and 4' maximum below proposed ground elevation.

THIS LINE TO BE CONSTRUCTED WITH PROJECT CONTRACTOR TO COORDINATE CONSTRUCTION WITH THIS PROJECT. FIELD VERIFY FLOWS AND NOTIFY ENGINEER IF CHANGES ARE NECESSARY.

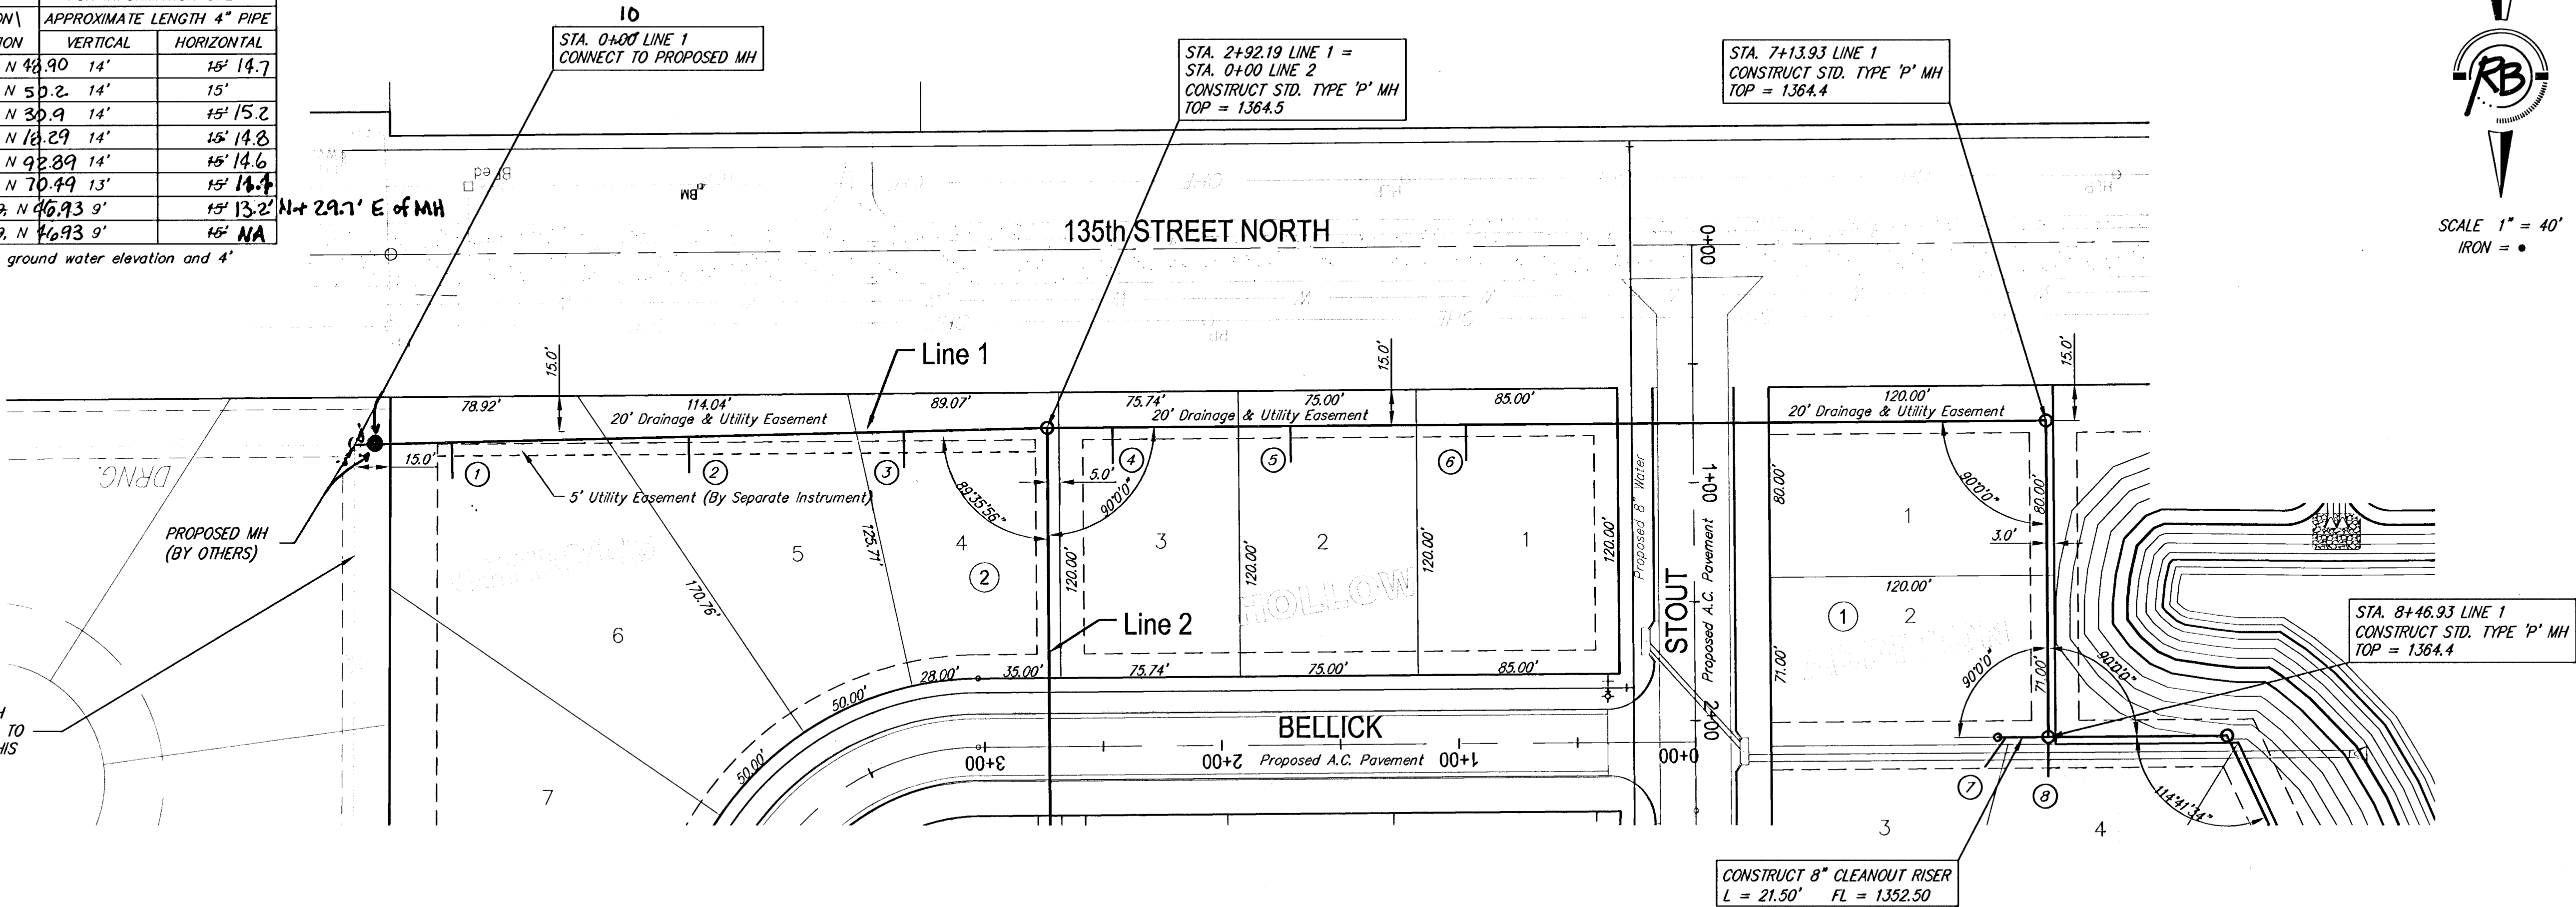

**Ruggles & Bohm, P.A.**  
Engineering, Surveying, Land Planning  
924 North Main  
Wichita, Kansas 67203  
www.rbkansas.com

(316) 264-8008  
(316) 264-4921 fax  
E-mail: info@rbkansas.com

PROJECT NUMBER  
468-83937

DESIGN  
KML

REVISIONS  
DATE  
May 3, 2005

Cheryl's Hollow Addition  
Line 1  
WICHITA, KANSAS

2  
OF  
11